DISTRICT	COUNTY	ROUTE	PROJECT	SHEET
9-0	BLAIR	I-99		

SNYDER TOWNSHIP AND TYRONE BOROUGH

REVISIONS

TABULATION OF QUANTITIES		
ITEM	UNIT	QUANTITY
POST MOUNTED SIGNS, TYPE A, LOGO	SQ.FT.	
POST MOUNTED SIGNS, TYPE B, LOGO	SQ.FT.	
POST MOUNTED SIGNS, TYPE C, LOGO	SQ.FT.	
BREAKAWAY SYSTEMS	EACH	
* STEEL S OR W BEAM POSTS	LBS.	
LOGO SIGN MOUNTING	EACH	
REMOVAL OF POST MOUNTED MOTORIST SERVICE SIGNS, TYPES A & E	EACH	
REMOVAL OF POST MOUNTED MOTORIST SERVICE SIGNS, TYPES B, C & F	L.S.	

* APPROXIMATE QUANTITY FOR INFORMATION ONLY

SYMBOLS

- ○ *Existing Sign to Remain*
- △ *Existing Sign to be Removed*
- □ *Existing Sign Reset as Shown*
- ● NEW SIGN
- × FUTURE SIGN
- Ø *Existing Utility Pole*

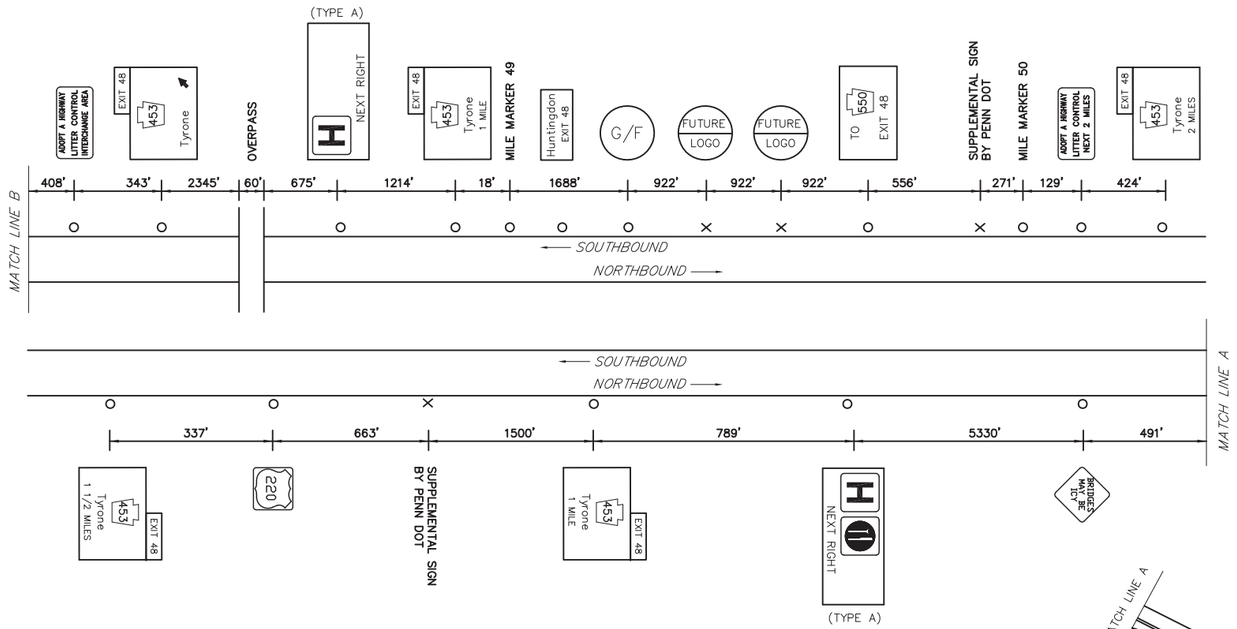

MAINLINE SCHEMATIC

NOT TO SCALE

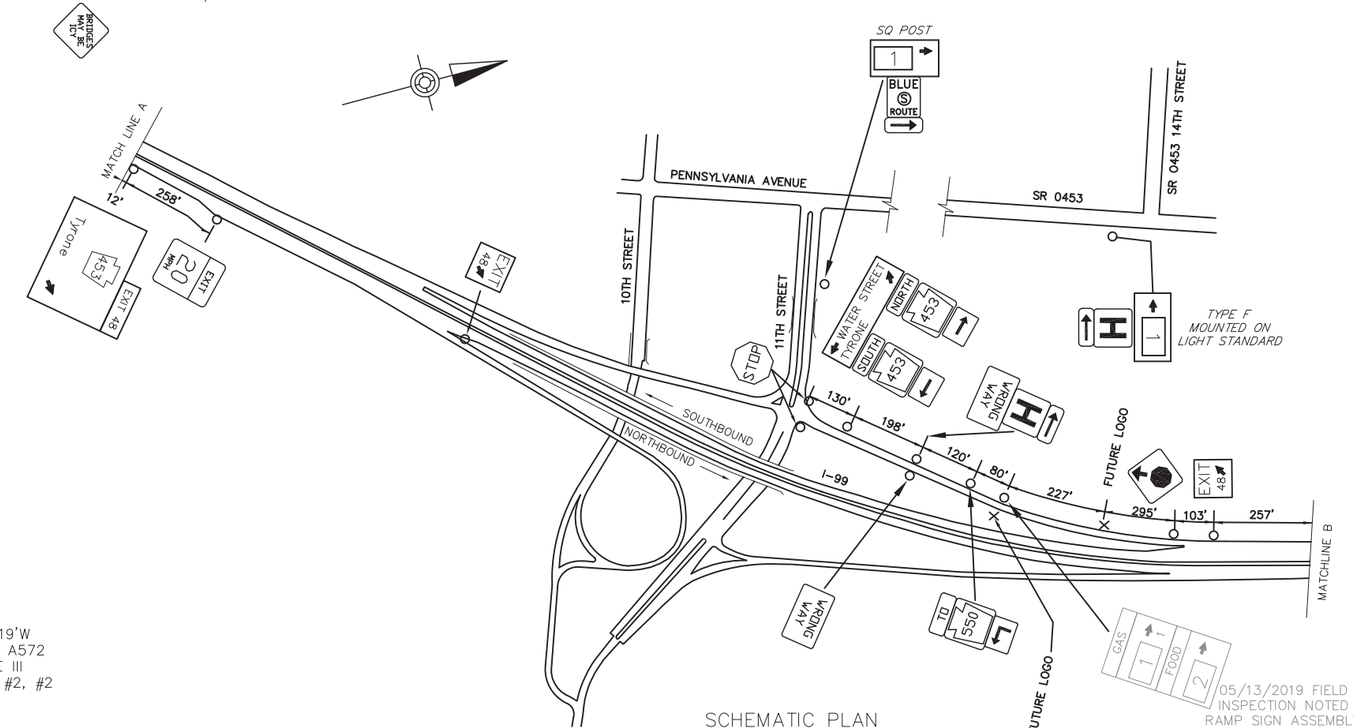

SCHEMATIC PLAN

NOT TO SCALE

EXIT 48 SPECIFIC INFORMATION PANEL			
LEGEND	DIRECTION	BUSINESS	LOGO. NO.
FOOD	SB	BURGER KING	2
GAS	SB	SHEETZ (DIESEL)	1

SB SIGNS

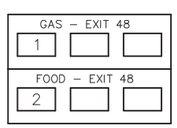

12'Hx19'W
W12x26 A572
TYPE III
B650 – #2, #2

NB NOT ELIGIBLE – INSUFFICIENT SPACE FOR PLACEMENT OF REQUIRED TRAILBLAZERS

INTERSTATE 99

TYRONE

EXIT 48

D:\2015\2015-215974-01\MKVPSE\AS-BUILT DRAWINGS\PENNDOT DISTRICT 09\BLAIR - 07\10-XX SHTXX-199_EXIT 48 PLAN
June/10/2019 4:13 PM