DISTRICT	COUNTY	ROUTE	PROJECT	SHEET
2-0	CLINTON	I-80		
	GREENE TOWNSHIP			
3-0	UNION	I-80		
	LEWIS TOWNSHIP			
	REVISIONS			

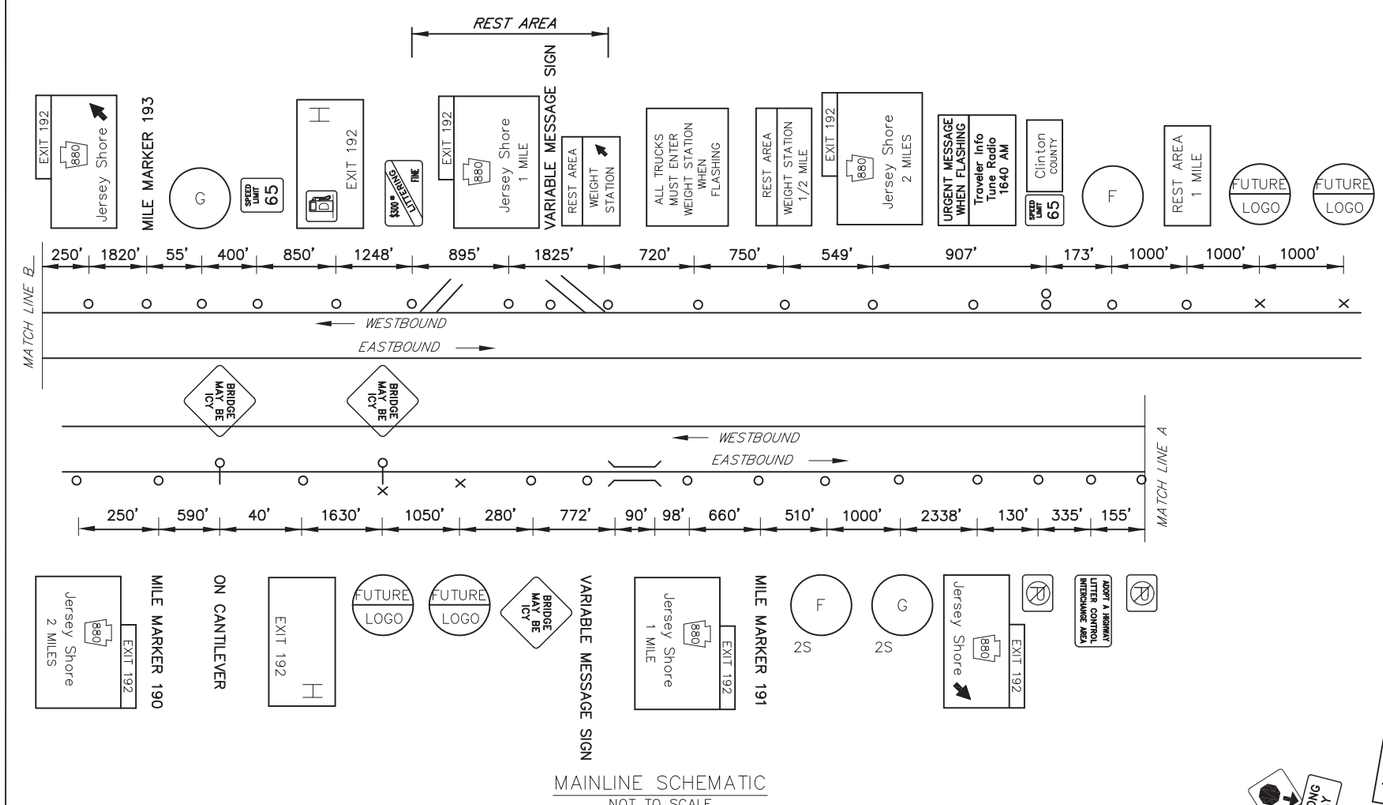

MAINLINE SCHEMATIC
NOT TO SCALE

TABULATION OF QUANTITIES		
ITEM	UNIT	QUANTITY
POST MOUNTED SIGNS, TYPE A, LOGO	SQ.FT.	–
POST MOUNTED SIGNS, TYPE B, LOGO	SQ.FT.	–
POST MOUNTED SIGNS, TYPE C, LOGO	SQ.FT.	–
BREAKAWAY SYSTEMS	EACH	–
* STEEL S OR W BEAM POSTS	LBS.	–
LOGO SIGN MOUNTING	EACH	–
FLAT SHEET PANEL REPLACEMENT	SQ.FT.	
EXTRUDED PANEL REPLACEMENT	SQ.FT.	
REMOVAL OF POST MOUNTED MOTORIST SERVICE SIGNS, TYPES B, C & F	L.S.	

* APPROXIMATE QUANTITY FOR INFORMATION ONLY

SYMBOLS

- ○ *Existing Sign to Remain*
- △ *Existing Sign to be Removed*
- □ *Existing Sign Reset as Shown*
- ● NEW SIGN
- × FUTURE SIGN
- Ø *Existing Utility Pole*

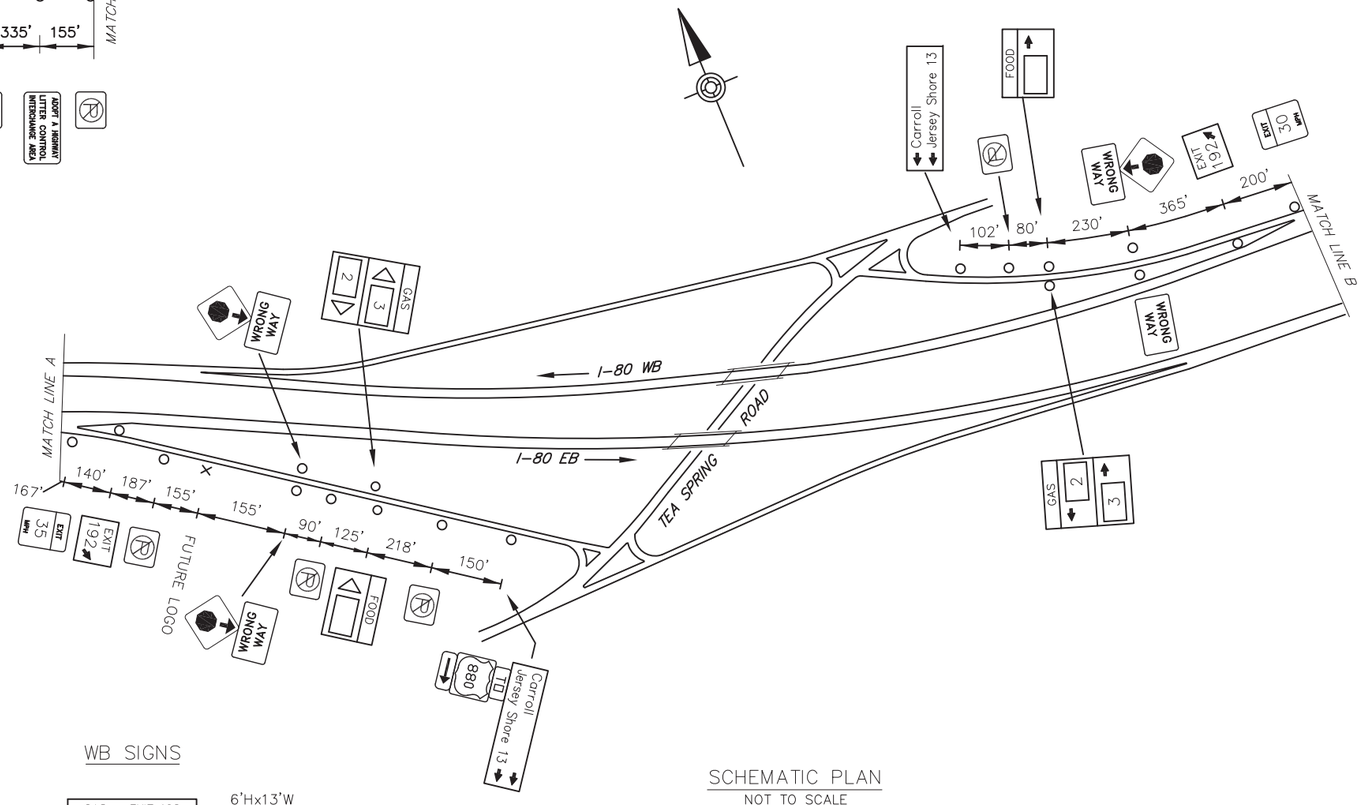

SCHEMATIC PLAN
NOT TO SCALE

LEGEND

2S – GUIDE RAIL

FREEWAY LANE CLOSURES & RESTRICTIONS ONLY PERMITTED BETWEEN 9:00 PM AND 6:00 AM MONDAY THRU FRIDAY. WORK ALONG FREEWAY PERMITTED BETWEEN 9:00 AM AND 2:30 PM, UNLESS OTHERWISE APPROVED BY ENGINEERING DISTRICT. DO NOT WORK DURING HOLIDAY PERIODS. IF APPLICABLE, REINSTALL GUIDERAIL AT END OF EACH DAY.

EXIT 192 SPECIFIC INFORMATION PANEL			
LEGEND	DIRECTION	BUSINESS	LOGO. NO.
FOOD	EB/WB		
GAS	EB/WB	VALERO (DIESEL)	2
		SUNOCO (24 HR DIESEL)	3

EB SIGNS

6'Hx13'W
FUTURE 14'H
W14x30
B650 – #1, #1

GAS – EXIT 192 | 2 | 3

10'Hx13'W
FUTURE 12'H
W10x26
3M TYPE III
B650 – #1, #1

FOOD – EXIT 192 | X | SPACES AVAILABLE 1-800-VISITPA

SPACES AVAILABLE LOGO

WB SIGNS

GAS – EXIT 192 | 2 | 3

6'Hx13'W
FUTURE 12'H
W12x26
B650 – #1, #1

FOOD – EXIT 192 | X |

10'Hx13'W
FUTURE 12'H
W8x21
3M TYPE III
B525 – #1, #1

07/30/2019 FIELD INSPECTION NOTED HEAVY SPALLING AND DETERIORATION AT BOTH FOUNDATIONS

INTERSTATE 80
JERSEY SHORE
EXIT 192

D:\2015_JOBS\215076-01\MVPSE\AS-BUILT DRAWINGS\PENNDOT DISTRICT 03\CLINTON - I80\I-XX SMTXX-I80_EXIT 192 PLAN
August 15, 2019 3:02 PM