DISTRICT	COUNTY	ROUTE	PROJECT	SHEET
5-0	SCHUYLKILL	I-81		
CASS AND BUTLER TOWNSHIPS				
REVISIONS				

TABULATION OF QUANTITIES		
ITEM	UNIT	QUANTITY
POST MOUNTED SIGNS, TYPE A, LOGO	SQ.FT.	
POST MOUNTED SIGNS, TYPE A, LOGO (MODIFIED)	SQ.FT.	–
POST MOUNTED SIGNS, TYPE C, LOGO	SQ.FT.	
BREAKAWAY SYSTEMS	EACH	–
* STEEL S OR W BEAM POSTS	LBS.	–
LOGO SIGN MOUNTING	EACH	–
LOGO SIGN MOUNTING, RESET	EACH	–
REMOVAL OF POST MOUNTED MOTORIST SERVICE SIGNS, TYPES A & E	EACH	–
REMOVAL OF POST MOUNTED MOTORIST SERVICE SIGNS, TYPES B, C & F	L.S.	

* APPROXIMATE QUANTITY FOR INFORMATION ONLY

SYMBOLS

- *Existing Sign to Remain*
- *Existing Sign to be Removed*
- *Existing Sign Reset as Shown*
- *Existing Sign Foundation*
- NEW SIGN
- FUTURE SIGN
- *Existing Utility Pole*

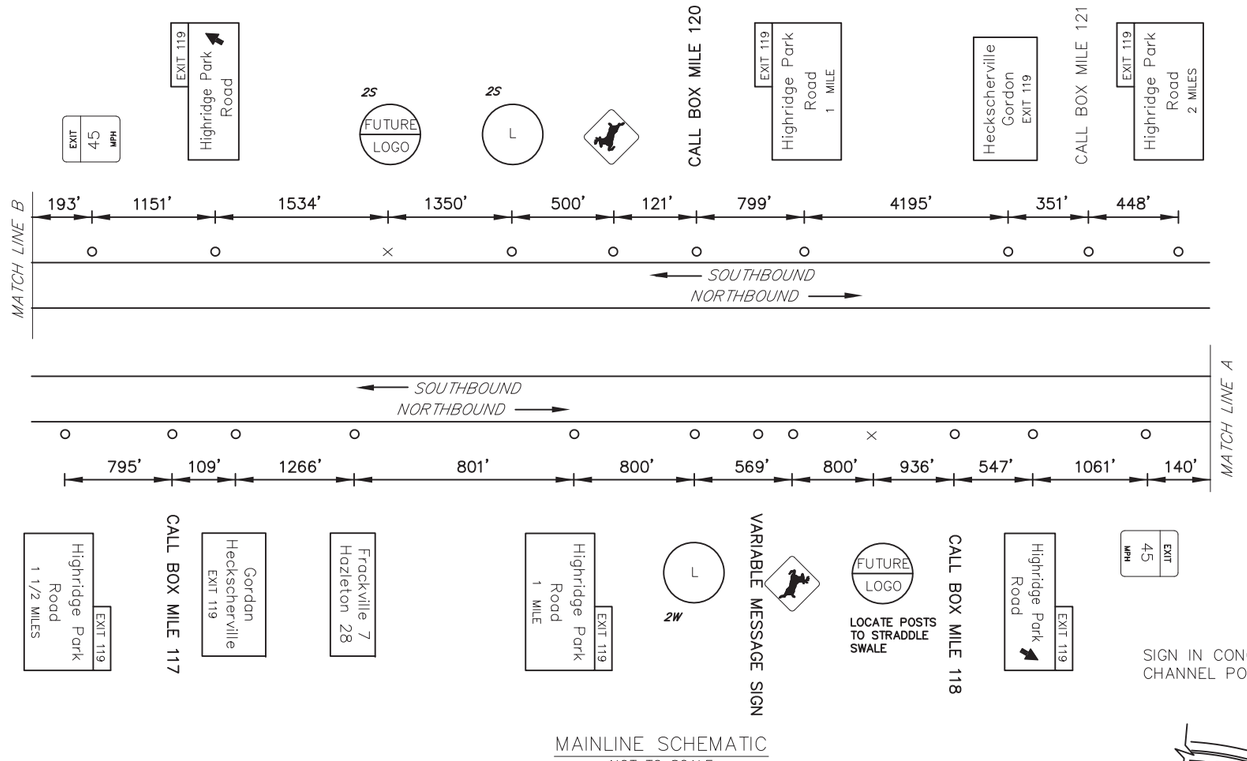

MAINLINE SCHEMATIC
NOT TO SCALE

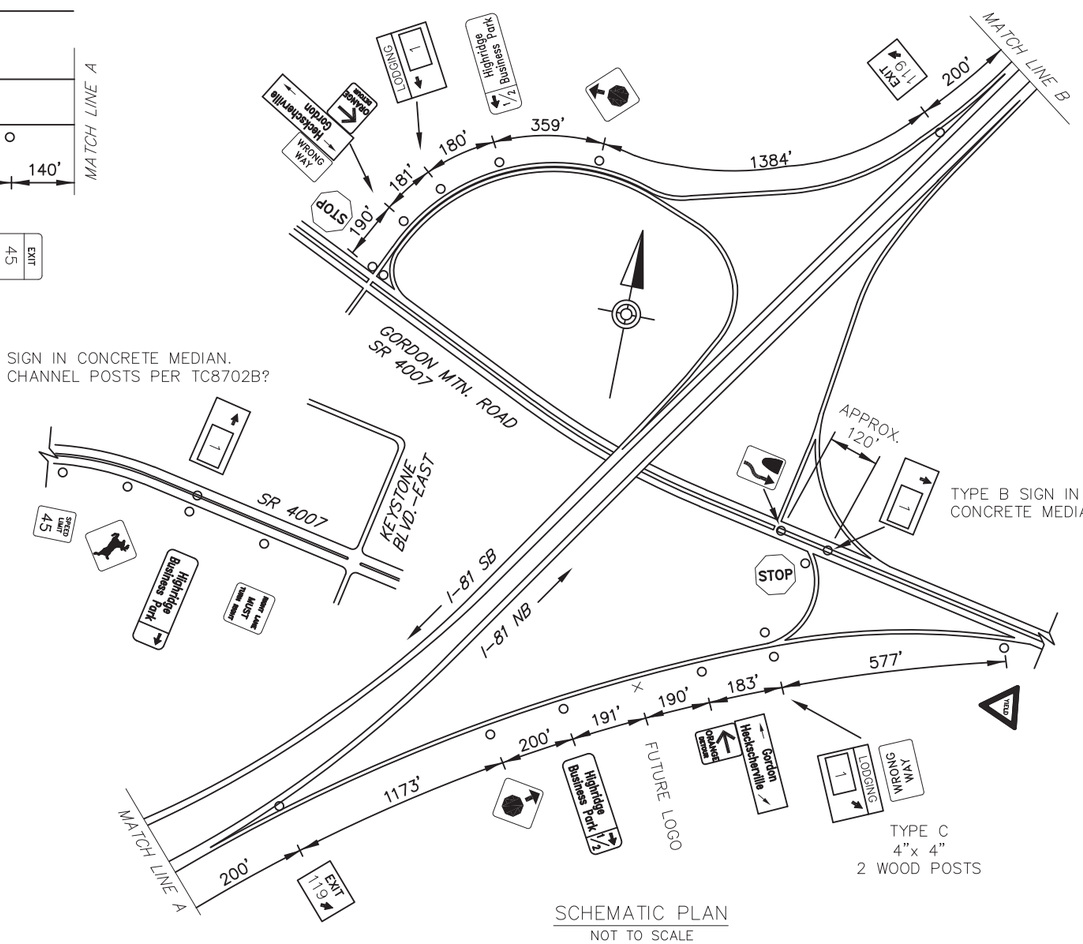

SCHEMATIC PLAN
NOT TO SCALE

LEGEND

2S/2W – GUIDE RAIL

FREEWAY LANE CLOSURES & RESTRICTIONS ONLY PERMITTED BETWEEN 9:00 PM AND 6:00 AM MONDAY THRU FRIDAY.
WORK ALONG FREEWAY PERMITTED BETWEEN 9:00 AM AND 2:30 PM, UNLESS OTHERWISE APPROVED BY ENGINEERING DISTRICT.
DO NOT WORK DURING HOLIDAY PERIODS.
IF APPLICABLE, REINSTALL GUIDERAIL AT END OF EACH DAY.

EXIT 119 SPECIFIC INFORMATION PANEL			
LEGEND	DIRECTION	BUSINESS	LOGO. NO.
LODGING	NB/SB	COUNTRY INN & SUITES	1

NB SIGNS

6'Hx19'W
FUTURE 10'H
W14x30 A572
B650 – #2, #1

SB SIGNS

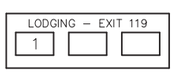

6'Hx19'W
FUTURE 12'H
W14x30 A572
AVERY TYPE IV
B650 – #2, #2

INTERSTATE 81

HIGHRIDGE PARK ROAD
EXIT 119

D:\2015_ADB\215076-01\WW\PSE\AS-BUILT DRAWINGS\PENNDOT DISTRICT 05\SCHUYLKILL - 533\10-XX_SHTXX IBL_EXIT 119 PLAN
October/3/2019 2:42 PM