DISTRICT	COUNTY	ROUTE	PROJECT	SHEET
8-0	FRANKLIN	I-81		

ANTRIM TOWNSHIP

REVISIONS

TABULATION OF QUANTITIES		
ITEM	UNIT	QUANTITY
POST MOUNTED SIGNS, TYPE A, LOGO	SQ.FT.	–
POST MOUNTED SIGNS, TYPE A, LOGO (MODIFIED)	SQ.FT.	–
POST MOUNTED SIGNS, TYPE C, LOGO	SQ.FT.	
BREAKAWAY SYSTEMS	EACH	–
* STEEL S OR W BEAM POSTS	LBS.	–
LOGO SIGN MOUNTING	EACH	–
LOGO SIGN MOUNTING, RESET	EACH	–
REMOVAL OF POST MOUNTED MOTORIST SERVICE SIGNS, TYPES A & E	EACH	
REMOVAL OF POST MOUNTED MOTORIST SERVICE SIGNS, TYPES B, C & F	L.S.	

* APPROXIMATE QUANTITY FOR INFORMATION ONLY

SYMBOLS

- ○ *Existing Sign to Remain*
- △ *Existing Sign to be Removed*
- □ *Existing Sign Reset as Shown*
- ● NEW SIGN
- × FUTURE SIGN
- Ø *Existing Utility Pole*

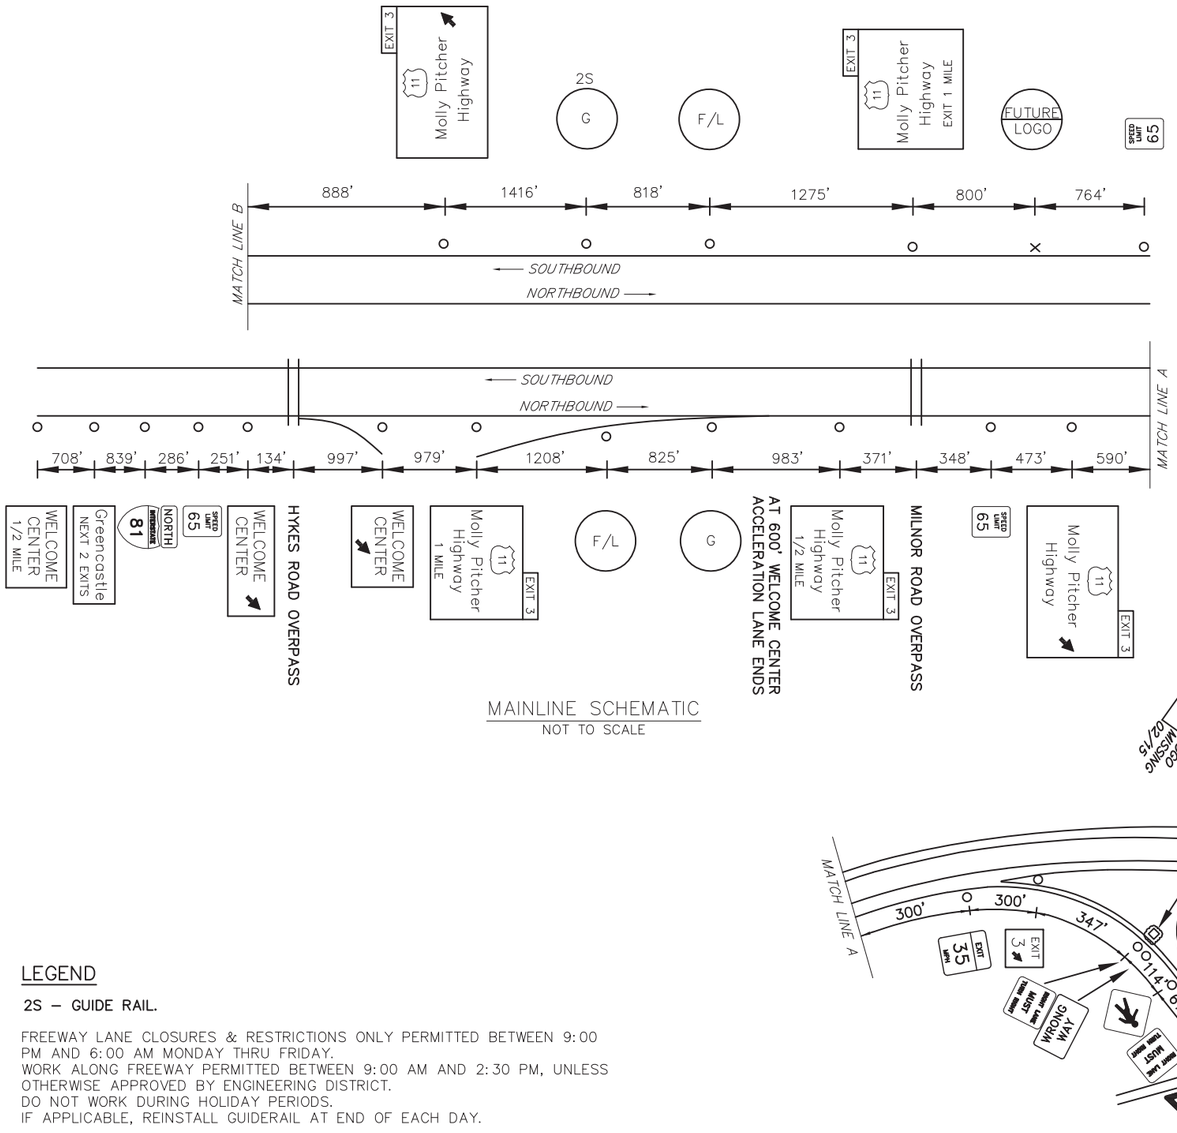

MAINLINE SCHEMATIC

NOT TO SCALE

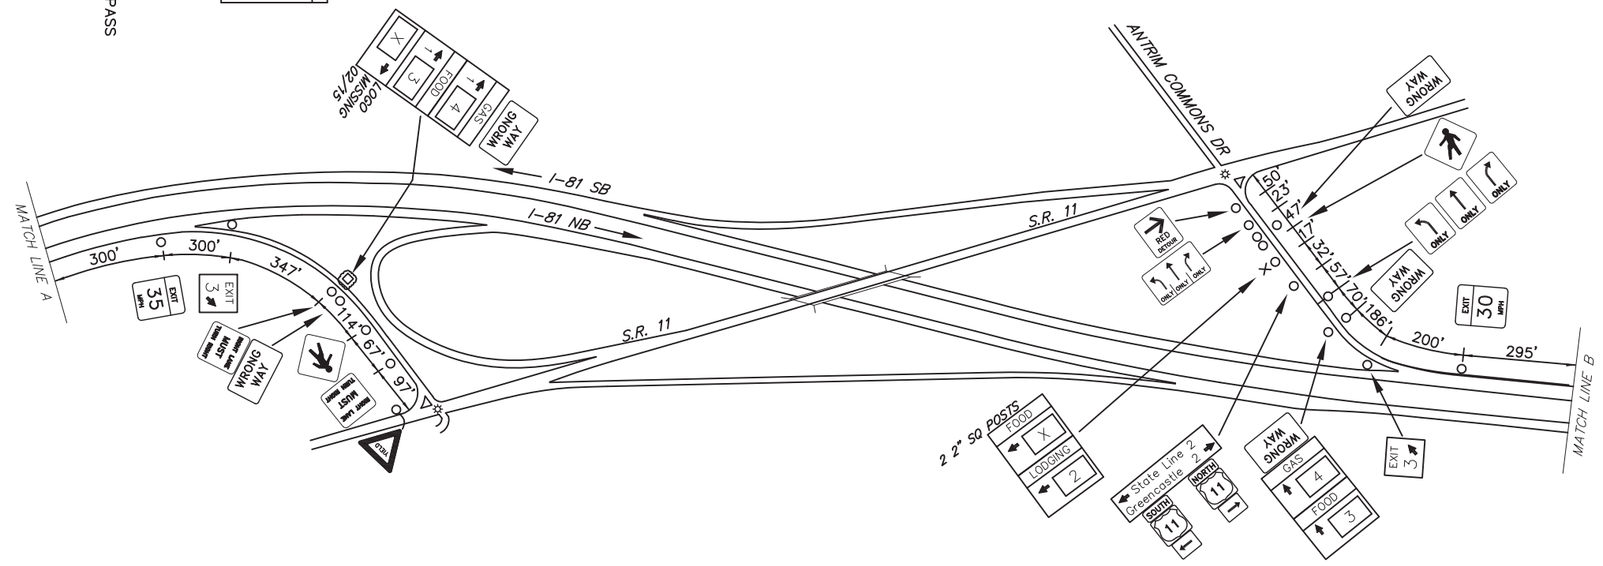

SCHEMATIC PLAN

NOT TO SCALE

LEGEND

2S – GUIDE RAIL.

FREEWAY LANE CLOSURES & RESTRICTIONS ONLY PERMITTED BETWEEN 9:00 PM AND 6:00 AM MONDAY THRU FRIDAY.
WORK ALONG FREEWAY PERMITTED BETWEEN 9:00 AM AND 2:30 PM, UNLESS OTHERWISE APPROVED BY ENGINEERING DISTRICT.
DO NOT WORK DURING HOLIDAY PERIODS.
IF APPLICABLE, REINSTALL GUIDERAIL AT END OF EACH DAY.

EXIT 3 SPECIFIC INFORMATION PANEL			
LEGEND	DIRECTION	BUSINESS	LOGO. NO.
GAS	NB/SB	SHEETZ	4
FOOD	NB/SB		
		SHEETZ	3
LODGING	NB/SB	COMFORT INN	2

NB SIGNS

SB SIGNS

6'Hx13'W
FUTURE 16'H
W14x30 A572
AVERY TYPE IV
B650 – #4, #4

GAS – EXIT 3 | 4 | |

GAS – EXIT 3 | 4 | |

6'Hx13'W
FUTURE 16'H
W18x40 A572
AVERY TYPE IV
B650 – #4, #4

12'Hx13'W
W8x21
AVERY TYPE IV
B525 – #2, #2

FOOD – EXIT 3 | 3 | |
LODGING – EXIT 3 | 2 | |

FOOD – EXIT 3 | 3 | |
LODGING – EXIT 3 | 2 | |

12'Hx13'W
W8x21
AVERY TYPE IV
B525 – #1, #1

INTERSTATE 81

MOLLY PITCHER HIGHWAY

EXIT 3

D:\2015_ED\85\225976-01\WVDOT\AS-BUILT DRAWINGS\FRANKLIN - 2016\16-XX SHTXX-I81_EXIT 3 PLAN
October/23/2019 3:03 PM