DISTRICT	COUNTY	ROUTE	PROJECT	SHEET
5-0	LEHIGH	I-78		
UPPER MACUNGIE TOWNSHIP				
REVISIONS				

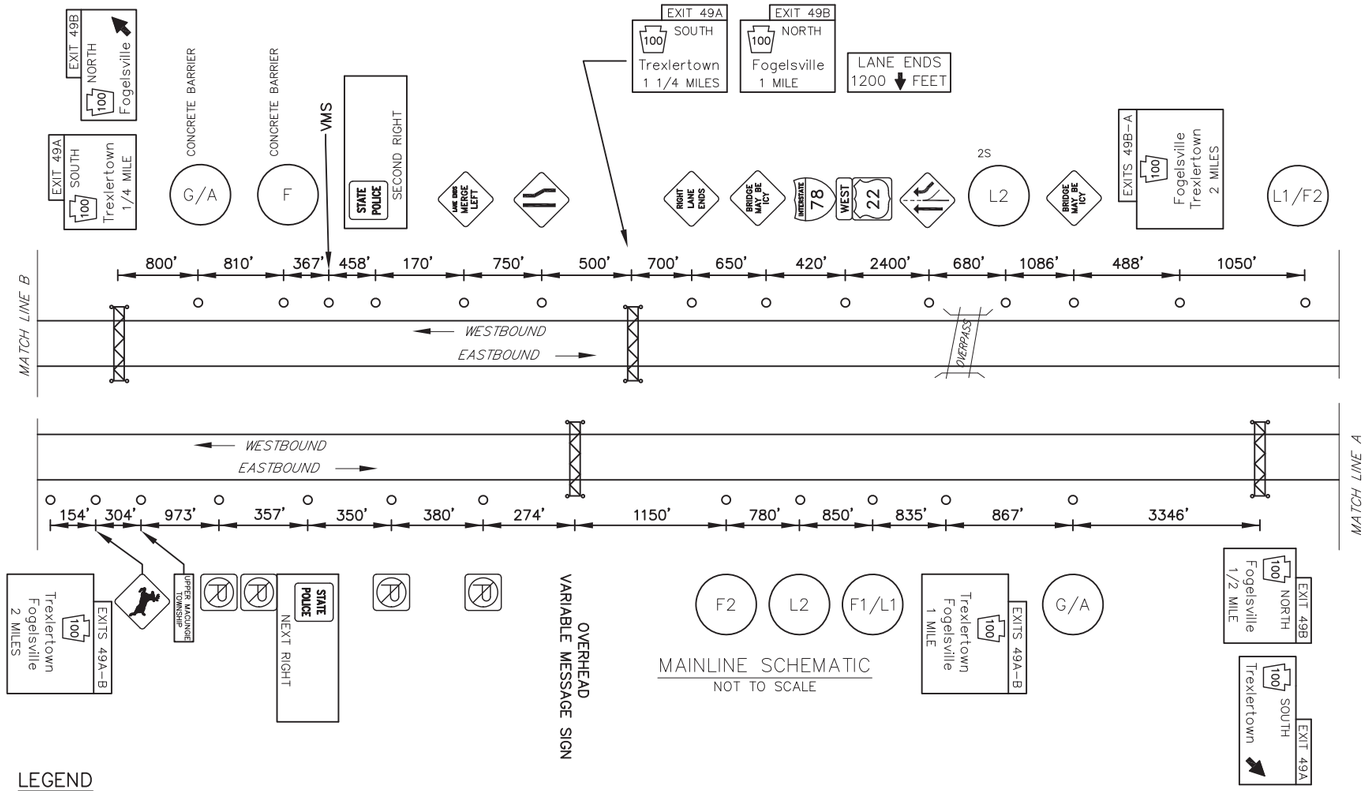

MAINLINE SCHEMATIC
NOT TO SCALE

LEGEND

2S – GUIDE RAIL

DO NOT CLOSE OR RESTRICT TRAVEL LANES
BETWEEN 6:00 AM AND 9:00 AM, AND
BETWEEN 3:00 PM AND 6:00 PM, MONDAY THRU FRIDAY.
DO NOT WORK DURING HOLIDAY PERIODS.

EXIT 49 SPECIFIC INFORMATION PANEL			
LEGEND	DIRECTION	BUSINESS	LOGO NO.
FOOD	49A EB/WB	BURGER KING	1
		TACO BELL	8
		YOCCO'S "HOT DOG KING"	9
	49B EB/WB		
		PIZZA HUT	5
		ARBY'S	10
		DUNKIN' DONUTS	21
	49B WB	LONG JOHN SILVER'S	11
LODGING	49A EB/WB		
		SLEEP INN	4
	49B EB/WB	HAWTHORN SUITES BY WYNDHAM	13
		MOTEL 6	18
	49B EB		
	49B WB	COMFORT INN	2
GAS	49A EB/WB		
		SUNOCO	12
		WAWA (24 Hours/Diesel)	14
ATTRACTION	49A EB/WB	CLOVER HILL WINERY	3
		VYNECREST WINERY	17

7/30/2018 FIELD VISIT
NOTED "COMFORT INN"
LOGO PANEL IS MISSING
AND SHOULD BE
REPLACED

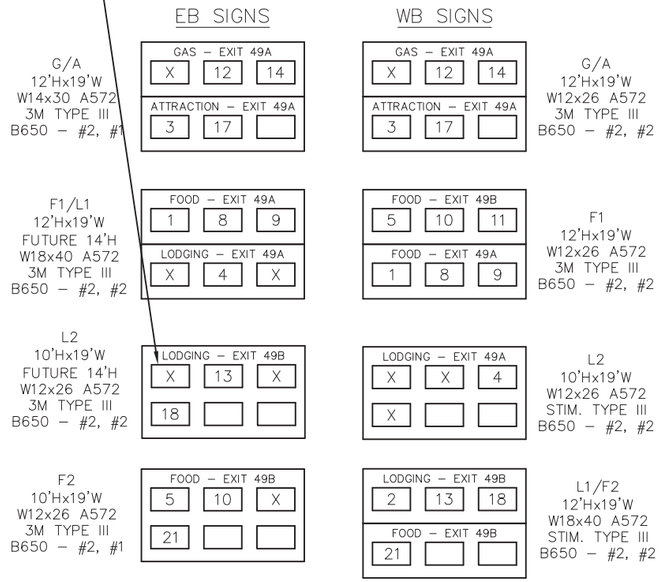

TABULATION OF QUANTITIES		
ITEM	UNIT	QUANTITY
POST MOUNTED SIGNS, TYPE A, LOGO	SQ.FT.	–
POST MOUNTED SIGNS, TYPE B, LOGO	SQ.FT.	–
POST MOUNTED SIGNS, TYPE C, LOGO	SQ.FT.	–
BREAKAWAY SYSTEMS	EACH	–
* STEEL S OR W BEAM POSTS	LBS.	–
LOGO SIGN MOUNTING	EACH	–
EXTRUDED PANEL REPLACEMENT	SQ.FT.	
REMOVAL OF POST MOUNTED MOTORIST SERVICE SIGNS, TYPES B, C & F	L.S.	

* APPROXIMATE QUANTITY FOR INFORMATION ONLY

SYMBOLS

- ○ *Existing Sign to Remain*
- △ *Existing Sign to be Removed*
- □ *Existing Sign Reset as Shown*
- ● NEW SIGN
- × FUTURE SIGN
- Ø *Existing Utility Pole*

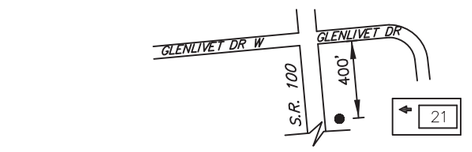

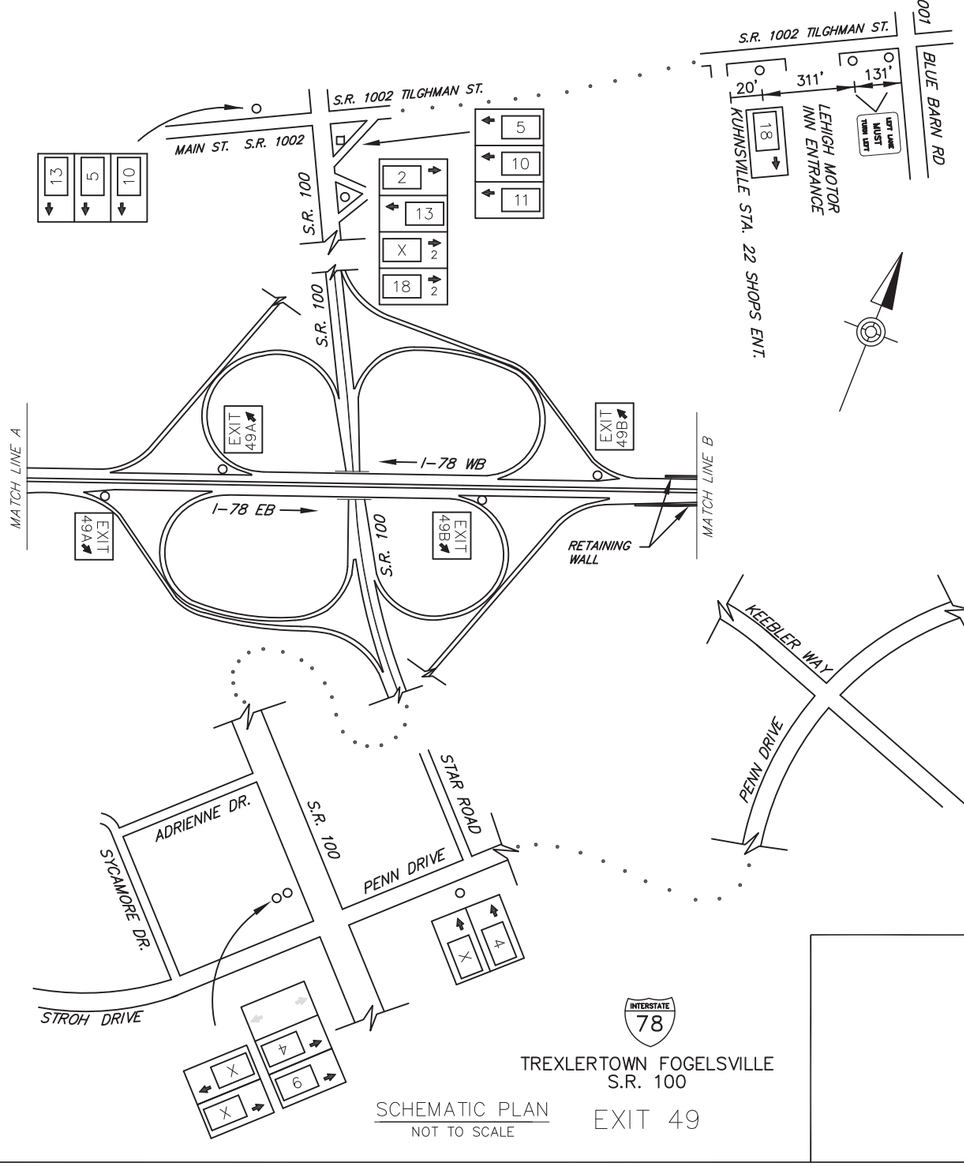

TREXLERTOWN FOGELSVILLE
S.R. 100

SCHEMATIC PLAN
NOT TO SCALE

EXIT 49

\\HBG-HASAN\DATA\PROJECTS\2015.0285\215076-01\WW\PSE\AS-BUILT DRAWINGS\PENNDOT DISTRICT 05\LEHIGH - 13\10-XX_SHTXX 178_EXIT 49 PLAN
May/29/2020 11:24 AM