| DISTRICT | COUNTY | ROUTE | PROJECT | SHEET |
|---|---|---|---|---|
| 2-0 | MIFFLIN | US 322 | | |

DERRY AND BROWN TOWNSHIPS AND BURNHAM BOROUGH

REVISIONS

| TABULATION OF QUANTITIES | | |
|---|---|---|
| ITEM | UNIT | QUANTITY |
| POST MOUNTED SIGNS, TYPE A, LOGO | SQ.FT. | |
| POST MOUNTED SIGNS, TYPE B, LOGO | SQ.FT. | |
| POST MOUNTED SIGNS, TYPE C, LOGO | SQ.FT. | |
| BREAKAWAY SYSTEMS | EACH | |
| * STEEL S OR W BEAM POSTS | LBS. | |
| LOGO SIGN MOUNTING | EACH | |
| REMOVAL OF POST MOUNTED MOTORIST SERVICE SIGNS, TYPES A & E | EACH | |
| REMOVAL OF POST MOUNTED MOTORIST SERVICE SIGNS, TYPES B, C & F | L.S. | |

* APPROXIMATE QUANTITY FOR INFORMATION ONLY

SYMBOLS

- ○ *Existing Sign to Remain*
- △ *Existing Sign to be Removed*
- □ *Existing Sign Reset as Shown*
- ● NEW SIGN
- × FUTURE SIGN
- Ø *Existing Utility Pole*

*WB NOT ELIGIBLE-INSUFFICIENT SPACE*

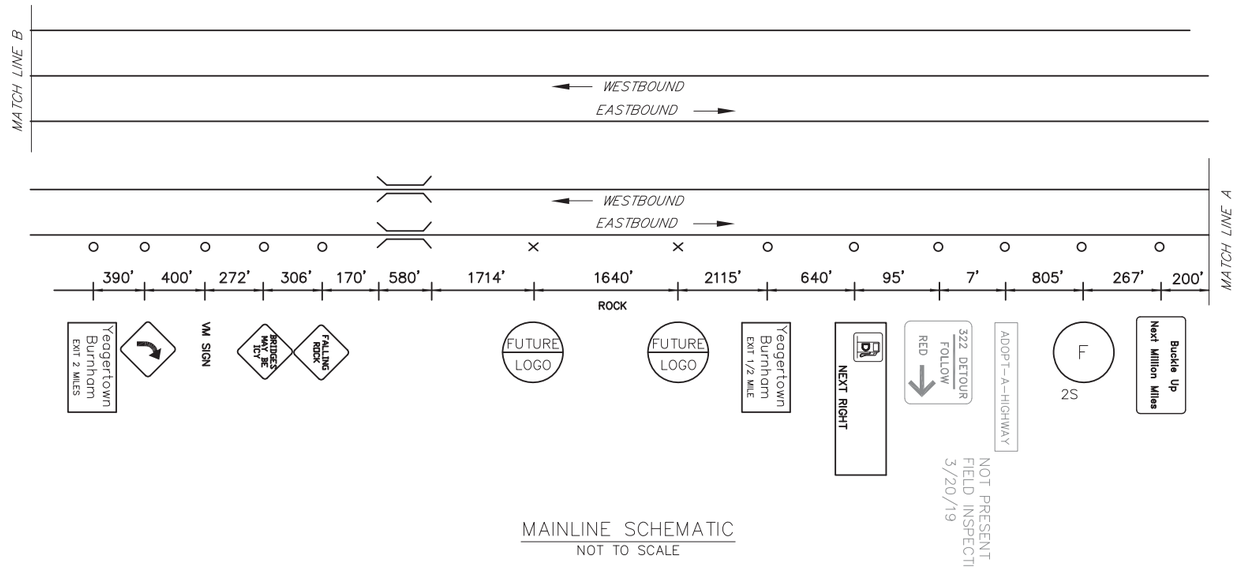


MAINLINE SCHEMATIC
NOT TO SCALE

NOT PRESENT DURING FIELD INSPECTION ON 3/20/19

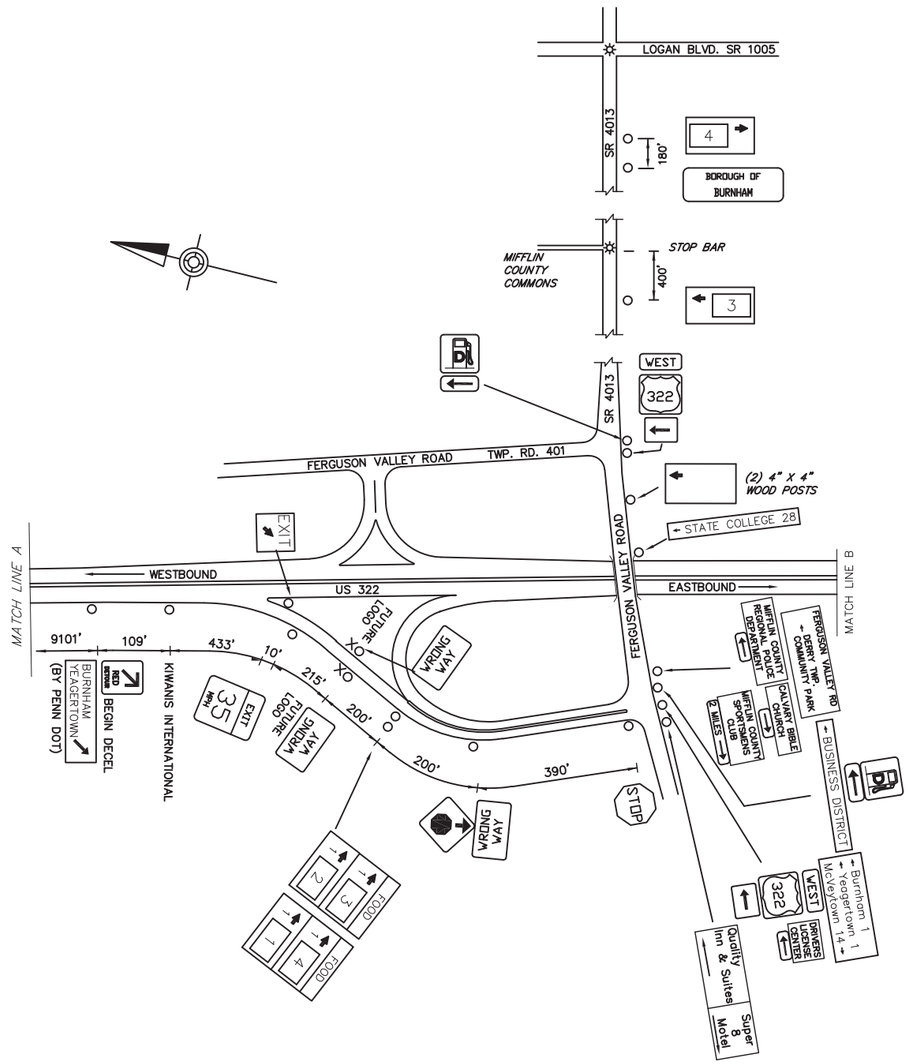


SCHEMATIC PLAN
NOT TO SCALE

BURNHAM/YEAGERTOWN

LEGEND

2S – GUIDE RAIL

| BURNHAM/YEAGERTOWN EXIT SPECIFIC INFORMATION PANEL | | | |
|---|---|---|---|
| LEGEND | DIRECTION | BUSINESS | LOGO NO. |
| FOOD | EB | SHEETZ | 1 |
| | | BURGER KING #10832 | 2 |
| | | SUBWAY | 3 |
| | | DUNKIN' DONUTS | 4 |

EB SIGNS

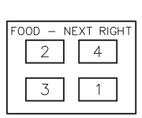


10'Hx13'W
W12x26 A36
3M TYPE III
B650 – #1, #4

\\HRG-HASJN\DATA\PROJECTS\2015\2015-215976-01\HV\PSE\AS-BUILT DRAWINGS\PENNDOT DISTRICT 02\MIFFLIN - 4410-XX SHTXX-322_EXIT YEAGERTOWN\BURNHAM PLAN
May/28/2020 3:06 PM