DISTRICT	COUNTY	ROUTE	PROJECT	SHEET
5-0	MONROE	I-80		
STROUD TOWNSHIP & STROUDSBURG BORO				
REVISIONS				

WB NOT ELIGIBLE – INSUFFICIENT SPACE

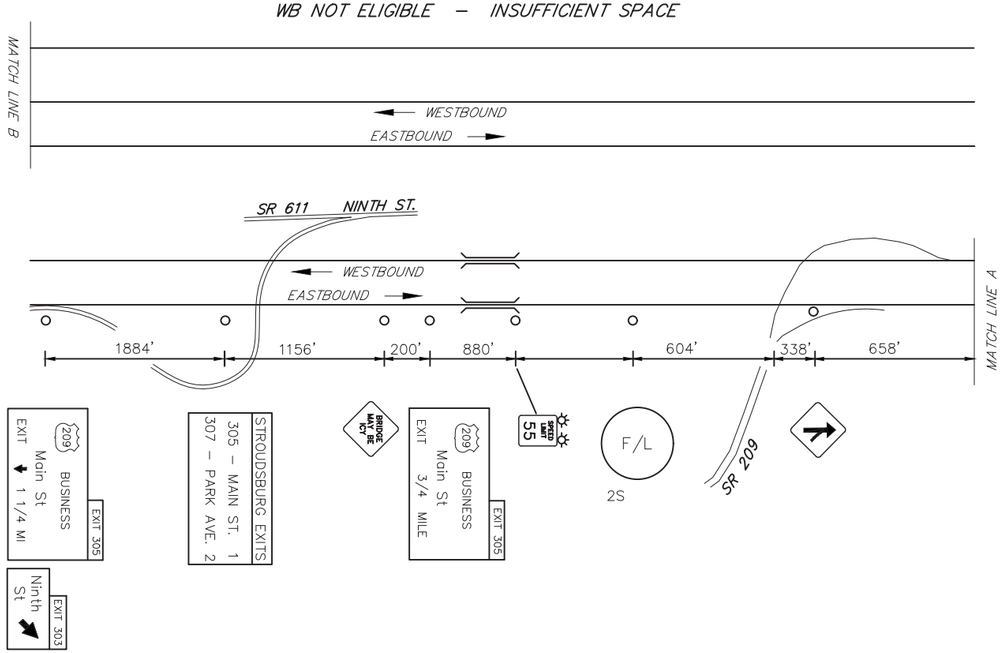

MAINLINE SCHEMATIC
NOT TO SCALE

TABULATION OF QUANTITIES		
ITEM	UNIT	QUANTITY
POST MOUNTED SIGNS, TYPE A, LOGO	SQ.FT.	
POST MOUNTED SIGNS, TYPE B, LOGO	SQ.FT.	
POST MOUNTED SIGNS, TYPE C, LOGO	SQ.FT.	
BREAKAWAY SYSTEMS	EACH	
* STEEL S OR W BEAM POSTS	LBS.	
LOGO SIGN MOUNTING	EACH	
FLAT SHEET PANEL REPLACEMENT	SQ.FT.	
EXTRUDED PANEL REPLACEMENT	SQ.FT.	
REMOVAL OF POST MOUNTED MOTORIST SERVICE SIGNS, TYPES B, C & F	L.S.	

* APPROXIMATE QUANTITY FOR INFORMATION ONLY

SYMBOLS

- ○ *Existing Sign to Remain*
- △ *Existing Sign to be Removed*
- □ *Existing Sign Reset as Shown*
- ● NEW SIGN
- × FUTURE SIGN
- Ø *Existing Utility Pole*

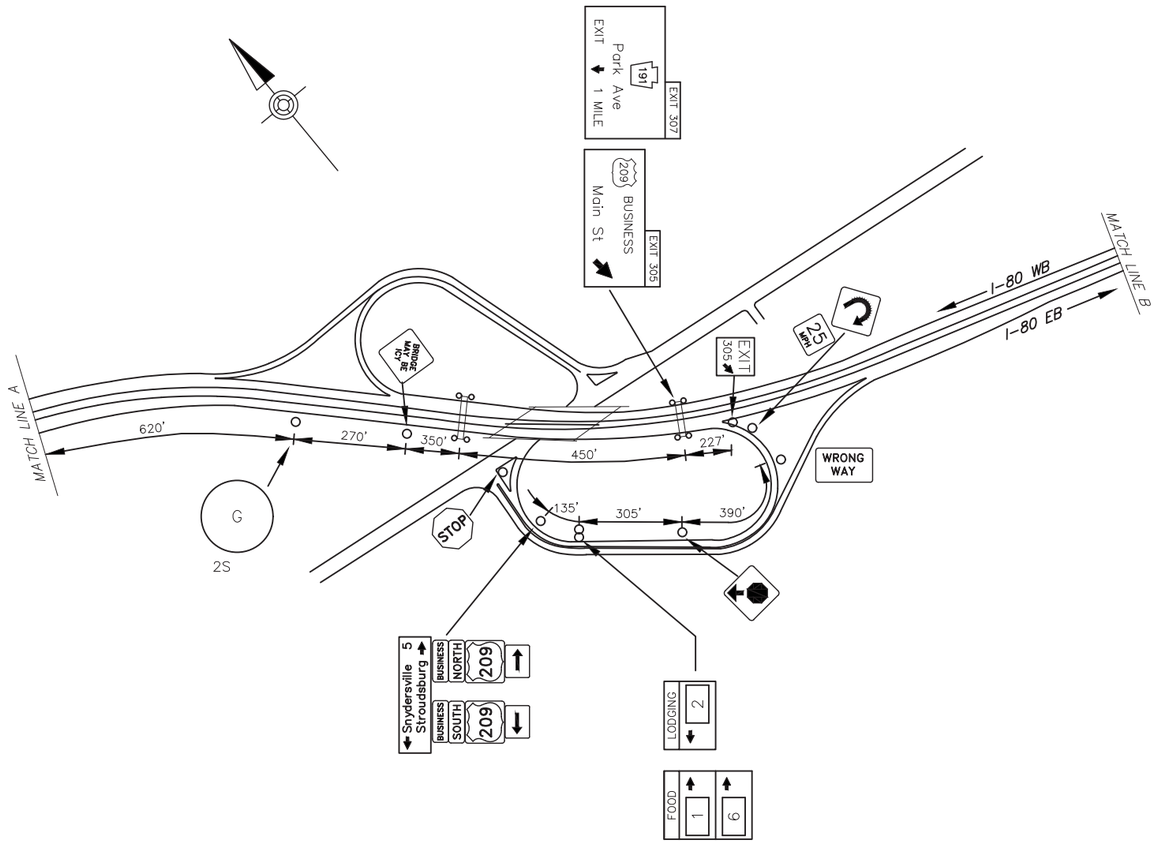

SCHEMATIC PLAN
NOT TO SCALE

LEGEND

2S – GUIDE RAIL

* – BUSINESS VISIBLE FROM RAMP

DO NOT CLOSE OR RESTRICT TRAVEL LANES
BETWEEN 6:00 AM TO 9:00 AM AND
BETWEEN 3:00 PM TO 6:00 PM MONDAY THRU FRIDAY.
DO NOT WORK DURING HOLIDAY PERIODS.

EXIT 305 SPECIFIC INFORMATION PANEL			
LEGEND	SIGN NUMBER	BUSINESS	LOGO NO.
GAS	EB	EXXON (DIESEL) *	5
FOOD	EB	PERKINS	1
		STARBUCKS	6
LODGING	EB	HOLIDAY INN EXPRESS	2

EB SIGNS

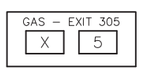

6'Hx13'W
FUTURE 12'H
W14x30 A572
3M TYPE III
B650 – #1, #1

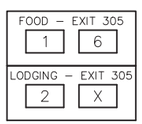

12'Hx13'W
FUTURE 14'H
W14x30 A572
3M TYPE III
B650 – #2, #1

INTERSTATE 80

MAIN STREET
EXIT 305

D:\2015_JOBS\215076-01\WW\PSE\AS-BUILT DRAWINGS\PENNDOT DISTRICT 05\MONROE - 45\10-XX SHTXX-180_EXIT 305 PLAN
July/01/2020 12:05 PM