DISTRICT	COUNTY	ROUTE	PROJECT	SHEET
8-0	ADAMS	US 15		
MOUNT JOY & STRABAN TOWNSHIP				
REVISIONS				

TABULATION OF QUANTITIES		
ITEM	UNIT	QUANTITY
POST MOUNTED SIGNS, TYPE A, LOGO	SQ.FT.	
POST MOUNTED SIGNS, TYPE B, LOGO	SQ.FT.	
POST MOUNTED SIGNS, TYPE C, LOGO	SQ.FT.	
BREAKAWAY SYSTEMS	EACH	
* STEEL S OR W BEAM POSTS	LBS.	
LOGO SIGN MOUNTING	EACH	
REMOVAL OF POST MOUNTED MOTORIST SERVICE SIGNS, TYPES B, C & F	L.S.	

* APPROXIMATE QUANTITY FOR INFORMATION ONLY

SYMBOLS

- ○ *Existing Sign to Remain*
- △ *Existing Sign to be Removed*
- □ *Existing Sign Reset as Shown*
- ● NEW SIGN
- × FUTURE SIGN
- Ø *Existing Utility Pole*

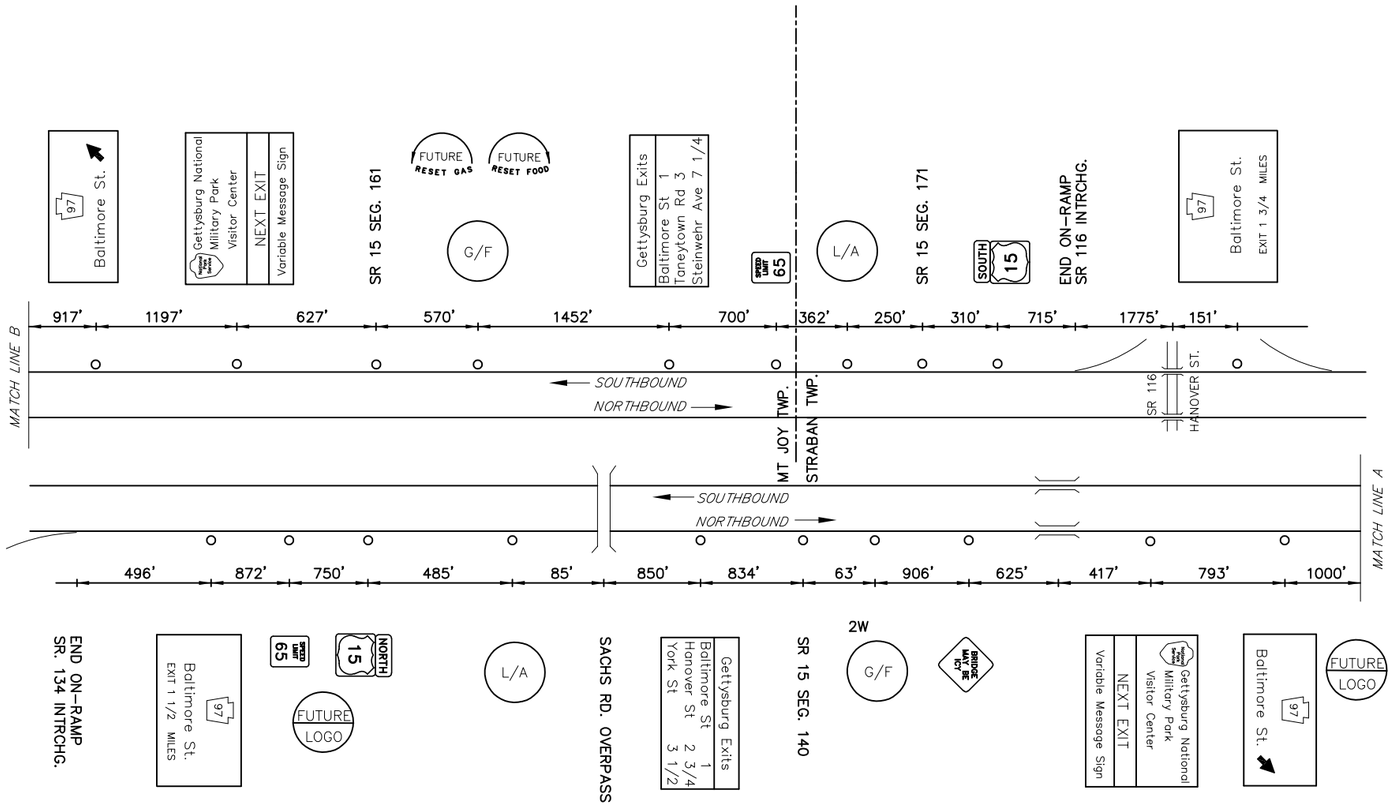

MAINLINE SCHEMATIC
NOT TO SCALE

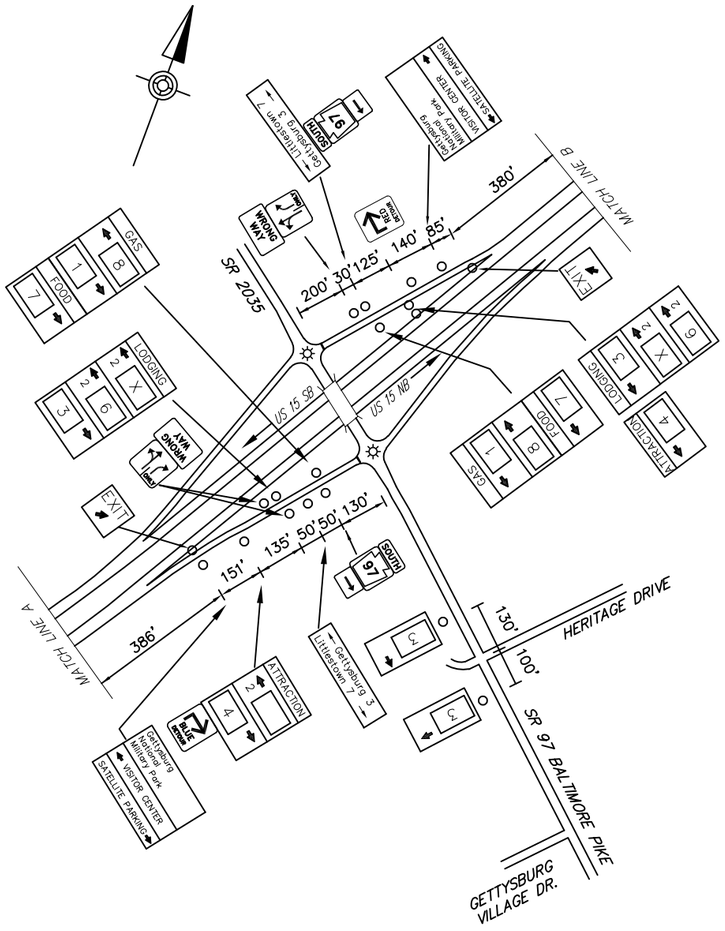

SCHEMATIC PLAN
NOT TO SCALE

LEGEND

2W – GUIDE RAIL

FREEWAY LANE CLOSURES & RESTRICTIONS ONLY PERMITTED BETWEEN 9:00 PM AND 6:00 AM MONDAY THRU FRIDAY.
DO NOT WORK DURING HOLIDAY PERIODS.

BALTIMORE ST. EXIT SPECIFIC INFORMATION PANEL			
LEGEND	DIRECTION	BUSINESS	LOGO NO.
GAS	NB/SB	SHEETZ (DIESEL)	1
		SUNOCO (DIESEL)	8
FOOD	NB/SB	SHEETZ	7
LODGING	NB/SB		
		COUNTRY INN & SUITES	3
		1863 INN OF GETTYSBURG	6
ATTRACTION	NB/SB	THE OUTLET SHOPPES AT GETTYSBURG	4

NB SIGNS

16'Hx13'W
W14x30 A572
3M TYPE III
B650 – #1, #1

GAS–NEXT RIGHT: 1 8
FOOD–NEXT RIGHT: 7

12'Hx19'W
FUTURE 13'H
W12x26 A572
3M TYPE III
B650 – #2, #2

LODGING – NEXT RIGHT: X 3 6
ATTRACTION – NEXT RIGHT: 4 X

SB SIGNS

GAS–NEXT RIGHT: 1 8
FOOD–NEXT RIGHT: 7

12'Hx13'W
13.5'H TOP SECTIONS
FUTURE 16'H
W12x26 A572
3M TYPE III
B650 – #1, #1

LODGING–NEXT RIGHT: X 3 6
ATTRACTION–NEXT RIGHT: 4

16'Hx13'W
FUTURE 17'H
W14x30
3M TYPE III
B650 – #2, #2

15

SR 97 / SR 2035

BALTIMORE ST.

\\DAWODDCC\DATA\PROJECTS\2015JOBS\215076-01\HW\PSE\AS-BUILT DRAWINGS\PENNDOT DISTRICT 08\ADAMS - 01\10-XX_SHTXX US15 BALTIMORE ST PLAN
January/17/2022 1:07 PM