DISTRICT	COUNTY	ROUTE	PROJECT	SHEET
11-0	ALLEGHENY	PA-28	XXX-XX	X OF X
EAST DEER AND FRAZER TOWNSHIPS				
REVISIONS				

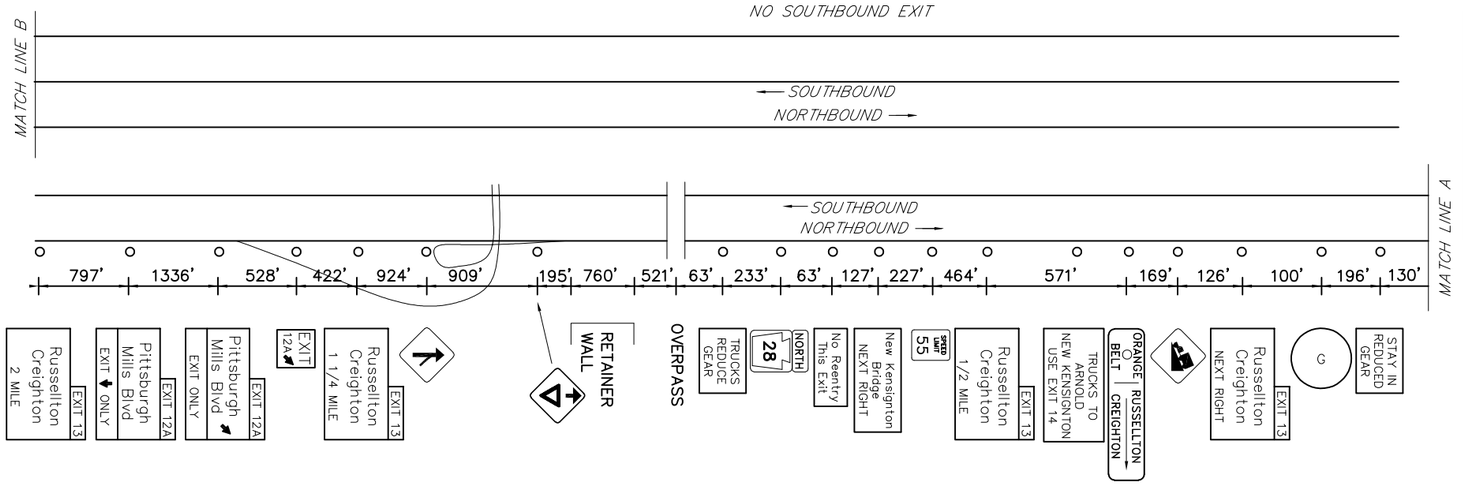

MAINLINE SCHEMATIC
NOT TO SCALE

TABULATION OF QUANTITIES		
ITEM	UNIT	QUANTITY
POST MOUNTED SIGNS, TYPE A, LOGO	SQ.FT.	–
POST MOUNTED SIGNS, TYPE B, LOGO	SQ.FT.	–
POST MOUNTED SIGNS, TYPE C, LOGO	SQ.FT.	–
BREAKAWAY SYSTEMS	EACH	–
* STEEL S OR W BEAM POSTS	LBS.	–
LOGO SIGN MOUNTING	EACH	–
RESET POST MOUNTING SIGNS, TYPE A, LOGO	EACH	–
REMOVAL OF POST MOUNTED MOTORIST SERVICE SIGNS, TYPES B, C & F	L.S.	–

* APPROXIMATE QUANTITY FOR INFORMATION ONLY

SYMBOLS

- ○ *Existing Sign to Remain*
- △ *Existing Sign to be Removed*
- □ *Existing Sign Reset as Shown*
- ● NEW SIGN
- × FUTURE SIGN
- Ø *Existing Utility Pole*

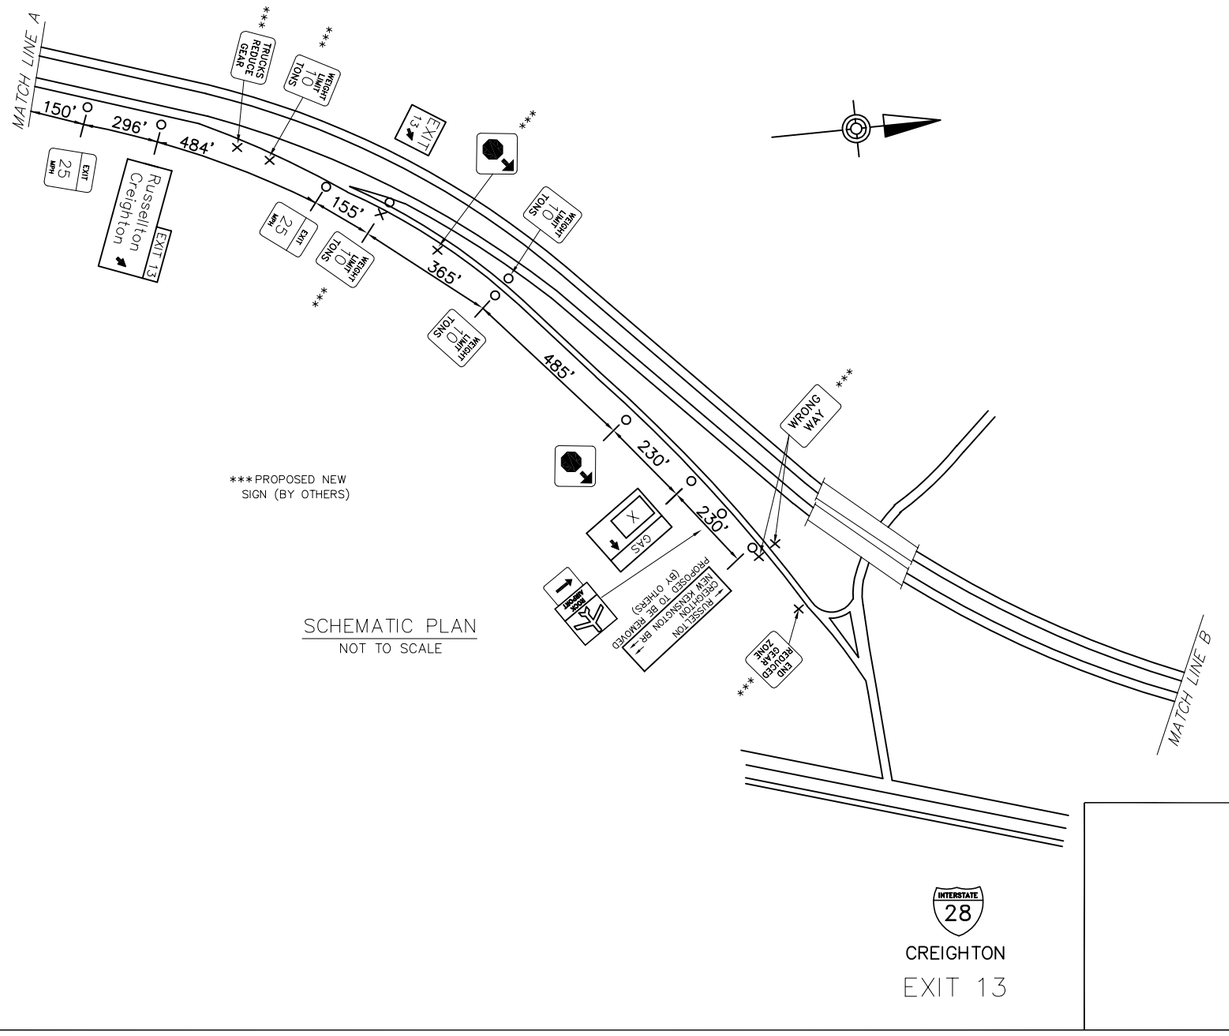

***PROPOSED NEW SIGN (BY OTHERS)

SCHEMATIC PLAN
NOT TO SCALE

EXIT 13 SPECIFIC INFORMATION PANEL			
LEGEND	DIRECTION	BUSINESS	LOGO NO.
GAS	NB		

NB SIGNS

6'Hx13'W
FUTURE 16'H
W14x30
SBM-650

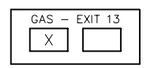

\\DRWDDLCC\DATA\PROJECTS\2015_DIST\215076-01\WV\PSEL\AS-BUILT DRAWINGS\PENNDOT DISTRICT 11\ALLEGHENY - 02\28_EXIT 13 PLAN
January/19/2022 2:19 PM