DISTRICT	COUNTY	ROUTE	PROJECT	SHEET
11-0	BEAVER	I-376		
HOPEWELL TOWNSHIP				
11-0	ALLEGHENY			
MOON & FINDLAY TOWNSHIPS				
REVISIONS				

TABULATION OF QUANTITIES		
ITEM	UNIT	QUANTITY
POST MOUNTED SIGNS, TYPE A, LOGO	SQ.FT.	
POST MOUNTED SIGNS, TYPE B, LOGO	SQ.FT.	
BREAKAWAY SYSTEMS	EACH	
* STEEL W BEAM BREAKAWAY POSTS	LBS.	
LOGO SIGN MOUNTING	EACH	
BREAKAWAY SYSTEM SUPPLIED BY TRUST	EACH	
REMOVAL OF POST MOUNTED MOTORIST SERVICE SIGNS, TYPES B, C & F	L.S.	—

* APPROXIMATE QUANTITY FOR INFORMATION ONLY

SYMBOLS

- ○ *Existing Sign to Remain*
- △ *Existing Sign to be Removed*
- □ *Existing Sign Reset as Shown*
- ● NEW SIGN
- × FUTURE SIGN
- Ø *Existing Utility Pole*

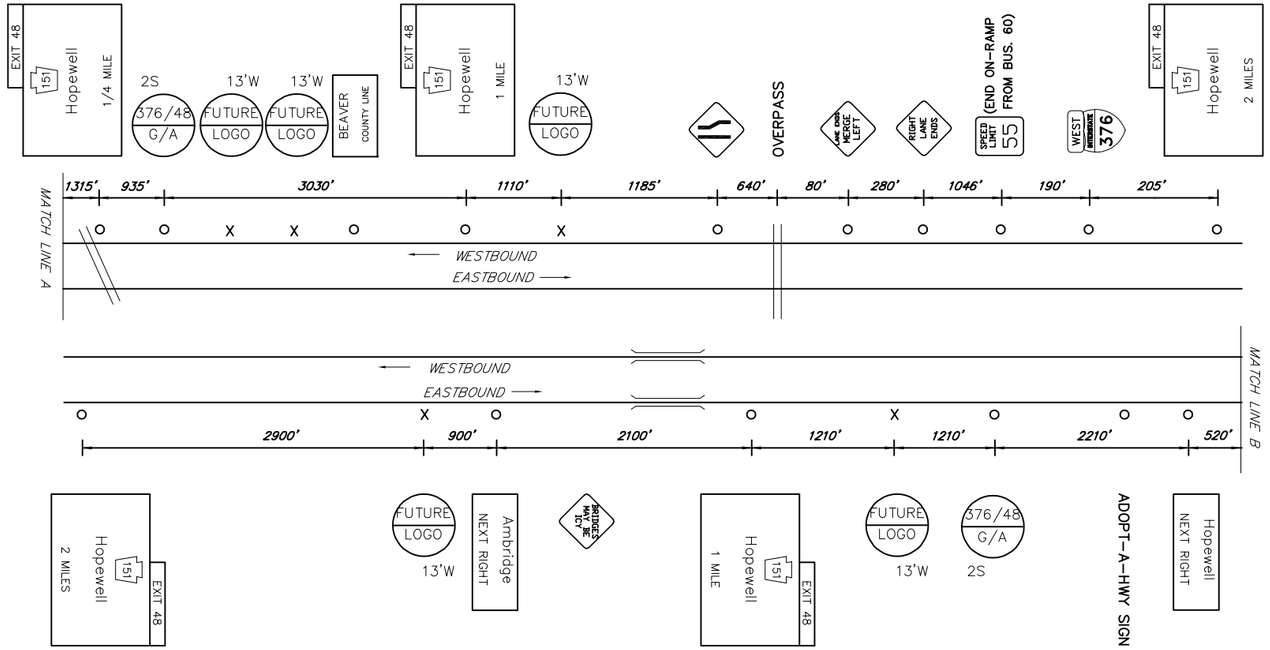

MAINLINE SCHEMATIC
NOT TO SCALE

EXIT 48 SPECIFIC INFORMATION PANEL			
LEGEND	DIRECTION	BUSINESS	LOGO NO.
GAS	EB/WB	AMOCO	1
ATTRACTION	EB/WB	HOPEWELL BUSINESS PARK	2

12'Hx13'W
W8x21 A572
B525 – #1, #1

WB SIGNS

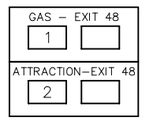

EB SIGNS

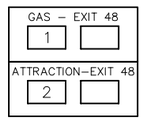

12'Hx13'W
W8x21 A572
B525 – #1, #1

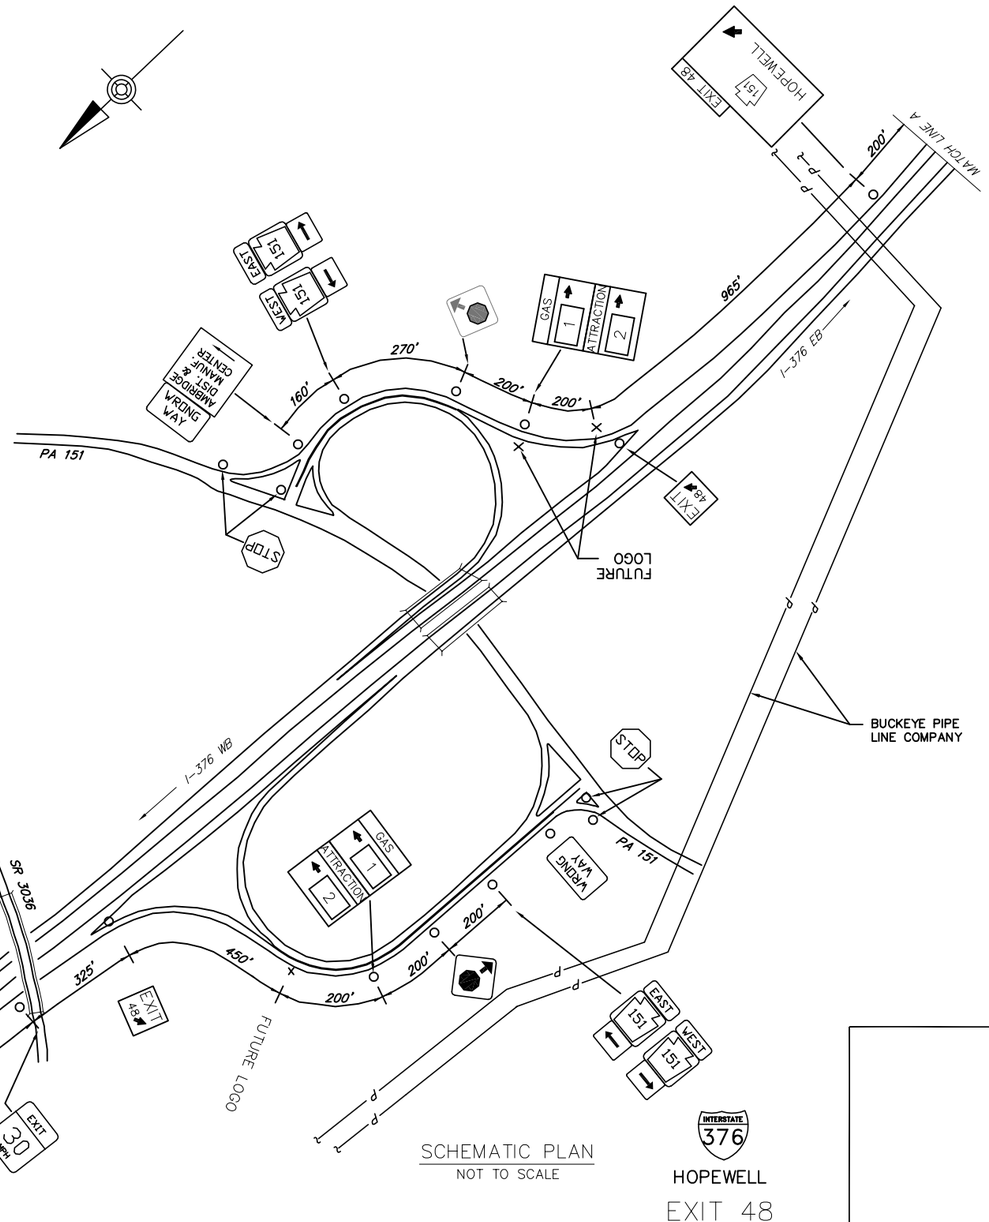

SCHEMATIC PLAN
NOT TO SCALE

EXIT 48
(OLD PA 60 EXIT 9)

\\DAVIDDJC\DATA\PROJECTS\2015JOBS\215076-01\HV\PSE\AS-BUILT DRAWINGS\PENNDOT DISTRICT 11\BEAVER - 04\10-XX SHTXX-I376_EXIT 48 PLAN
January/17/2022 1:09 PM