DISTRICT	COUNTY	ROUTE	PROJECT	SHEET
10-0	ARMSTRONG	US-422		

EAST FRANKLIN AND NORTH BUFFALO TOWNSHIPS

REVISIONS

TABULATION OF QUANTITIES		
ITEM	UNIT	QUANTITY
POST MOUNTED SIGNS, TYPE A, LOGO	SQ.FT.	
POST MOUNTED SIGNS, TYPE B, LOGO	SQ.FT.	
BREAKAWAY SYSTEMS	EACH	
* STEEL W BEAM BREAKAWAY POSTS	LBS.	
LOGO SIGN MOUNTING	EACH	
REMOVAL OF POST MOUNTED MOTORIST SERVICE SIGNS, TYPES A & E	EACH	
REMOVAL OF POST MOUNTED MOTORIST SERVICE SIGNS, TYPES B, C & F	L.S.	

* APPROXIMATE QUANTITY FOR INFORMATION ONLY

SYMBOLS

- ○ *Existing Sign to Remain*
- △ *Existing Sign to be Removed*
- □ *Existing Sign Reset as Shown*
- ● NEW SIGN
- × FUTURE SIGN
- Ø *Existing Utility Pole*

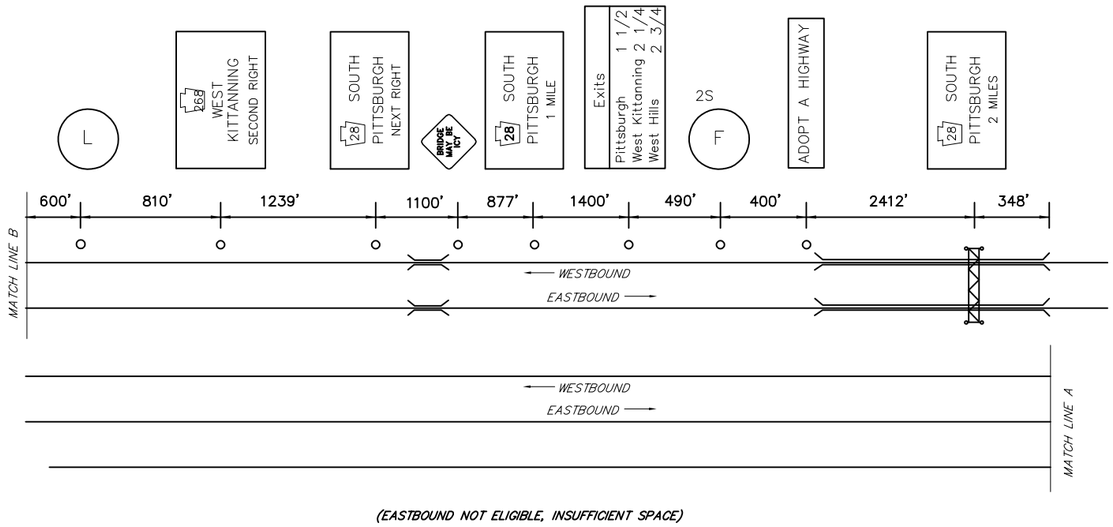

(EASTBOUND NOT ELIGIBLE, INSUFFICIENT SPACE)

MAINLINE SCHEMATIC
NOT TO SCALE

MOD. TYPE C –
ONE 6"x 6" WOOD POST
PER COLUMN OF LOGOS

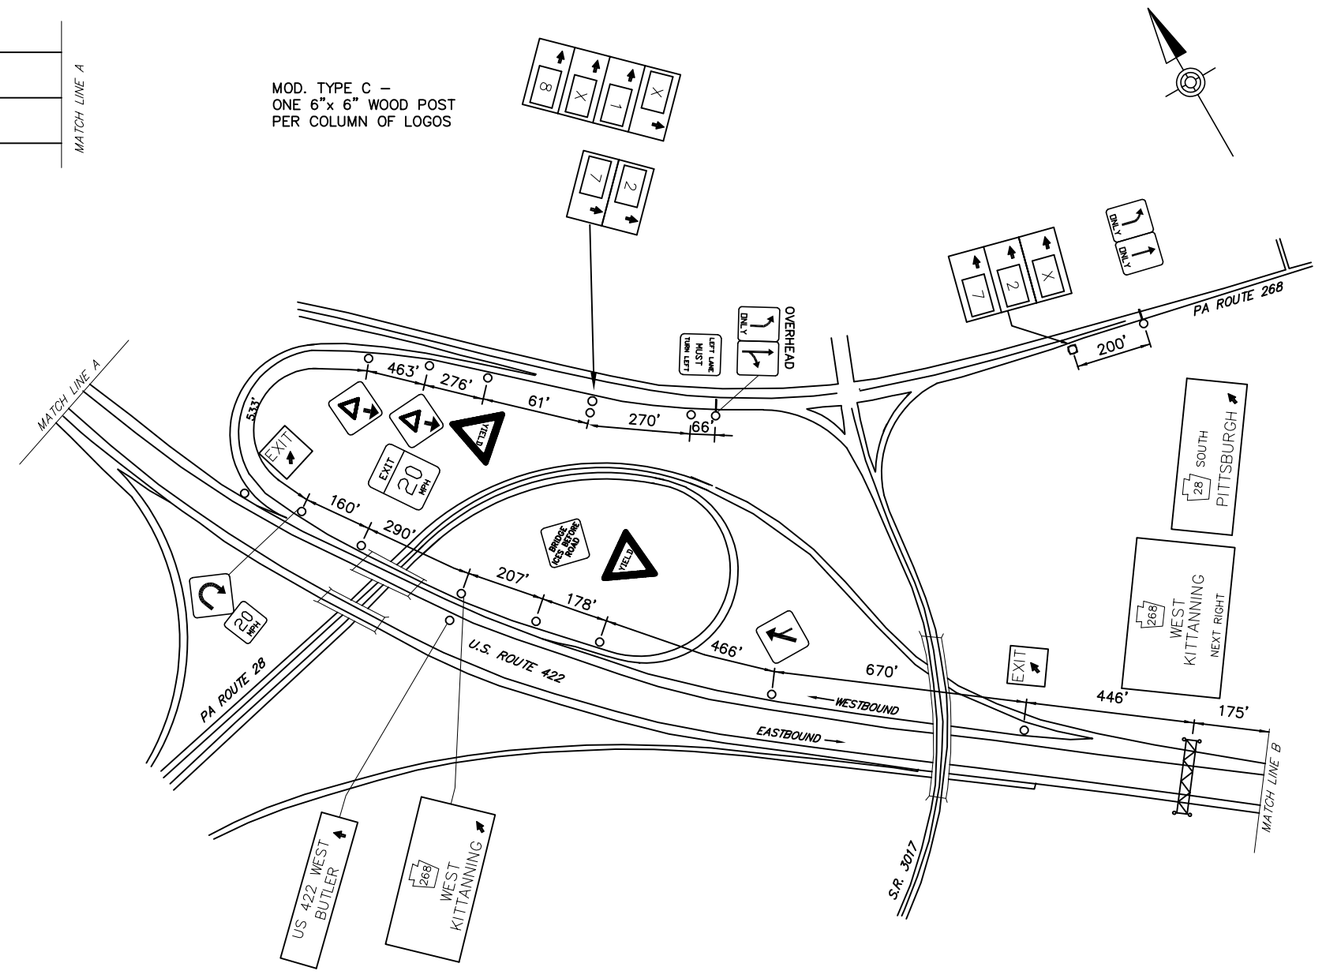

SCHEMATIC PLAN
NOT TO SCALE

W KITANNING SPECIFIC INFORMATION PANEL			
LEGEND	DIRECTION	BUSINESS	LOGO NO.
FOOD	WB	McDONALD'S NO. 5637	1
		WENDY'S NO. 048	2
		KFC	7
		TACO BELL	8
LODGING	WB		

WB SIGNS

6'H x 13'W
FUTURE 14'H
W8x21 A572
TYPE III
B525 – #1, #2

LODGING – SECOND RIGHT
X

10'H x 19'W
W10x22 A572
TYPE III
B650 – #2, #2

FOOD – SECOND RIGHT

1	2	7
8	X	

422

W. KITTANNING

\\DAVOD2C\DATA\PROJECTS\2015\D3810\215976-R0\MV\PSE\AS-BUILT DRAWINGS\PENNDOT DISTRICT 10\ARMSTRONG - 03\10-XX SHTXX-US422_WEST KITTANING_PLAN
January/20/2022 3:56 PM