DISTRICT	COUNTY	ROUTE	PROJECT	SHEET
11-0	ALLEGHENY	I-79		
CITY OF BRIDGEVILLE, SOUTH FAYETTE & COLLIER TWPS.				
REVISIONS				

TABULATION OF QUANTITIES		
ITEM	UNIT	QUANTITY
POST MOUNTED SIGNS, TYPE A, LOGO	SQ.FT.	-
POST MOUNTED SIGNS, TYPE B, LOGO	SQ.FT.	-
POST MOUNTED SIGNS, TYPE C, LOGO	SQ.FT.	-
BREAKAWAY SYSTEMS	EACH	-
* STEEL S OR W BEAM POSTS	LBS.	-
LOGO SIGN MOUNTING	EACH	-

* APPROXIMATE QUANTITY FOR INFORMATION ONLY

SYMBOLS

- ○ *Existing Sign to Remain*
- △ *Existing Sign to be Removed*
- □ *Existing Sign Reset as Shown*
- ● NEW SIGN
- × FUTURE SIGN
- Ø *Existing Utility Pole*

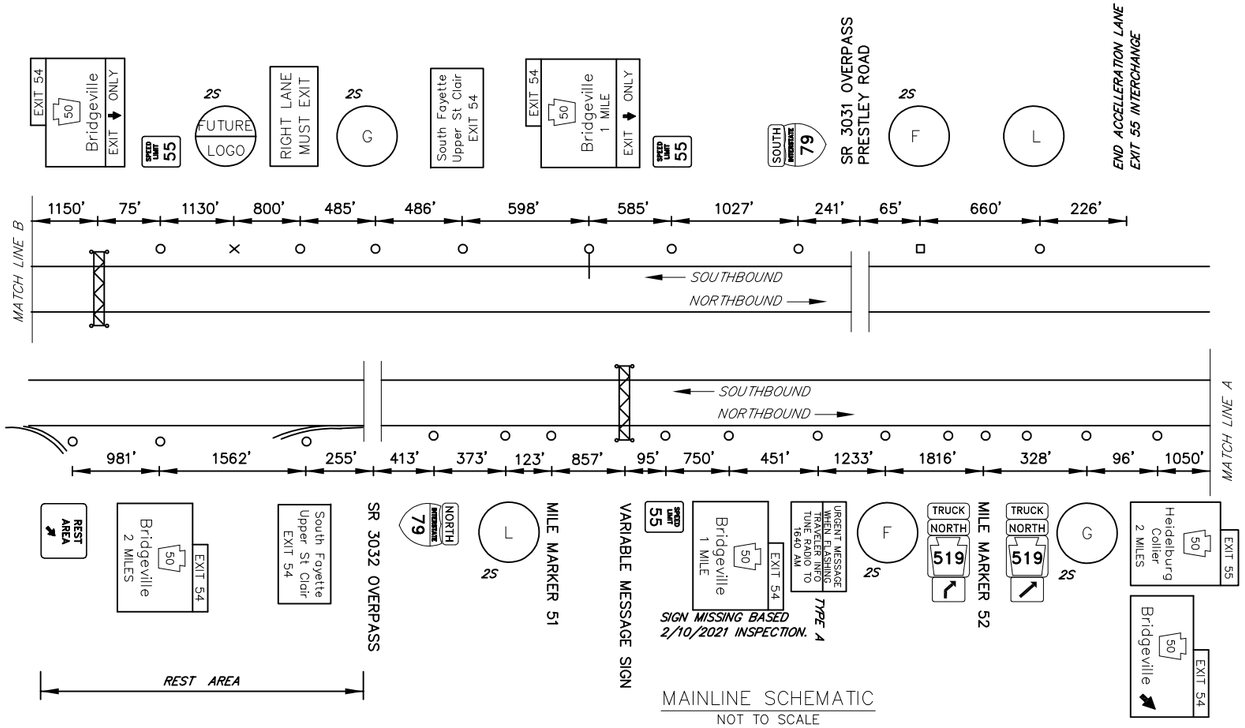

MAINLINE SCHEMATIC
NOT TO SCALE

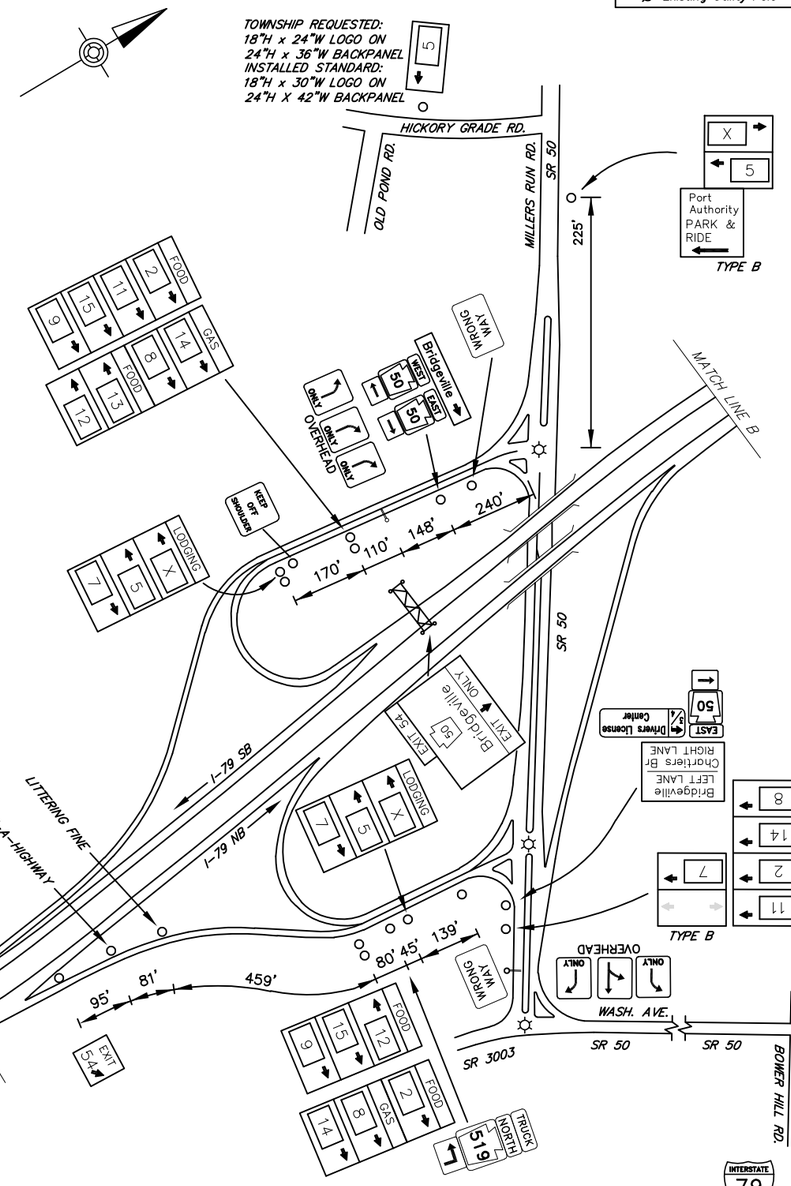

SCHEMATIC PLAN
NOT TO SCALE

LEGEND

2S – GUIDE RAIL

EXIT 54 SPECIFIC INFORMATION PANEL			
LEGEND	DIRECTION	BUSINESS	LOGO NO.
GAS	NB/SB	GETGO (24 HRS/DIESEL)	8
		SHEETZ (DIESEL)	14
FOOD	NB/SB	McDONALD'S (24 HRS)	2
		STARBUCKS	9
		GETGO	11
		DUNKIN' DONUTS	12
		SHEETZ (24 HRS)	15
	SB	FIVE GUYS	13
LODGING	NB/SB	HOLIDAY INN EXPRESS	7
		HAMPTON INN	5

NB SIGNS		SB SIGNS	
6'Hx13'W FUTURE 16' W10x26 A572 3M TYPE III SBM-650	GAS – EXIT 54: 8 14; H; ST CLAIR	GAS – EXIT 54: 8 14	6'Hx13'W FUTURE 16'H W18x40 3M TYPE III SBM-650
10'Hx13'W W8x15 A36 3M TYPE III B525 – #2, #2	FOOD – EXIT 54: 2 12; 15 9	FOOD – EXIT 54: 2 11; 15 9; 13 12	14'Hx13'W W8x21 A572 3M TYPE III B525 – #2, #2
10'Hx13'W FUTURE 16' W10x26 A572 3M TYPE III SBM-650	LODGING – EXIT 54: X 7; 5	LODGING – EXIT 54: 5 7	6'Hx13'W FUTURE 16'H W10x26 A572 3M TYPE III SBM-650

\\DAVID2.CC.\DATA\PROJECTS\2015\D11R5\D15076-01\WV\PSE\AS-BUILT DRAWINGS\PENNDOT DISTRICT 11\ALLEGHENY - I79\10-XX SHTX I79_EXIT 54 PLAN
January/18/2022 4:34 PM