DISTRICT	COUNTY	ROUTE	PROJECT	SHEET
2-0	CLEARFIELD	I-80		
	SANDY TOWNSHIP			
10-0	JEFFERSON			
	WASHINGTON TOWNSHIP			
	REVISIONS			

TABULATION OF QUANTITIES		
ITEM	UNIT	QUANTITY
POST MOUNTED SIGNS, TYPE A, LOGO	SQ.FT.	
POST MOUNTED SIGNS, TYPE B, LOGO	SQ.FT.	
POST MOUNTED SIGNS, TYPE C, LOGO	SQ.FT.	
BREAKAWAY SYSTEMS	EACH	
* STEEL S OR W BEAM POSTS	LBS.	
LOGO SIGN MOUNTING	EACH	
REMOVAL OF POST MOUNTED MOTORIST SERVICE SIGNS, TYPES B, C & F	L.S.	

* APPROXIMATE QUANTITY FOR INFORMATION ONLY

SYMBOLS

- ○ *Existing Sign to Remain*
- △ *Existing Sign to be Removed*
- □ *Existing Sign Reset as Shown*
- ● NEW SIGN
- × FUTURE SIGN
- Ø *Existing Utility Pole*

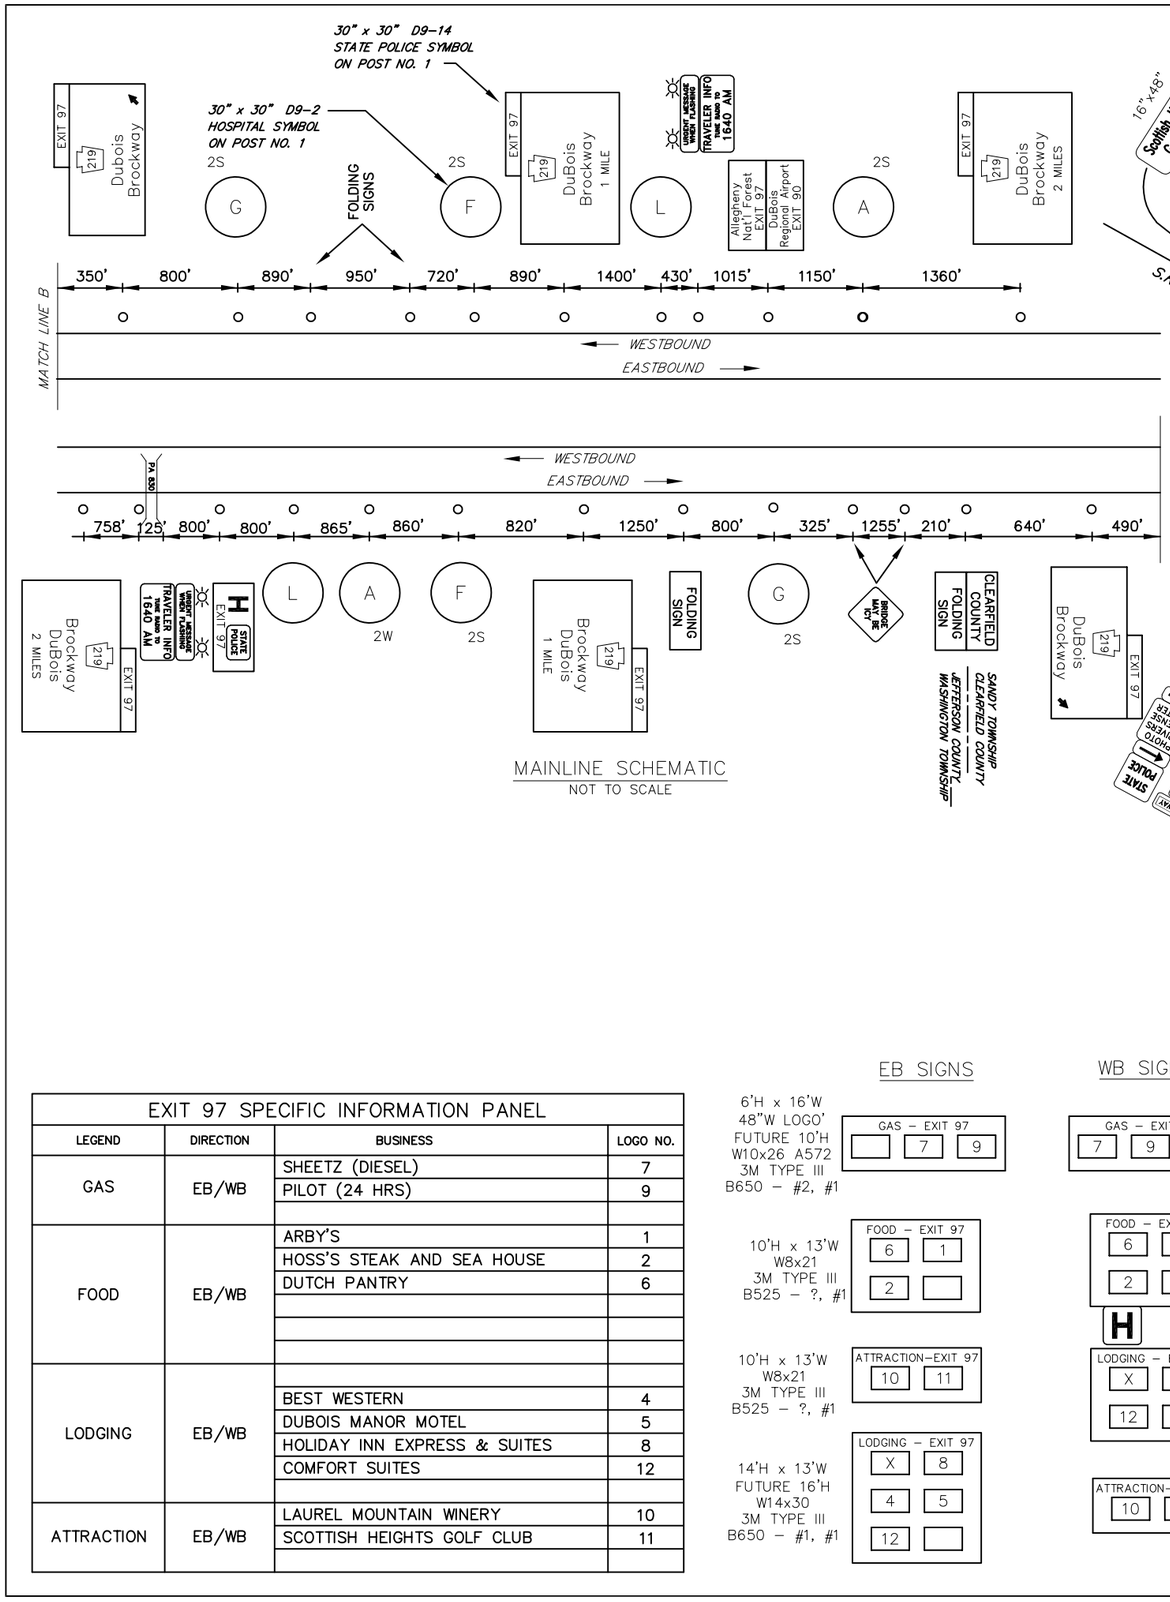

MAINLINE SCHEMATIC
NOT TO SCALE

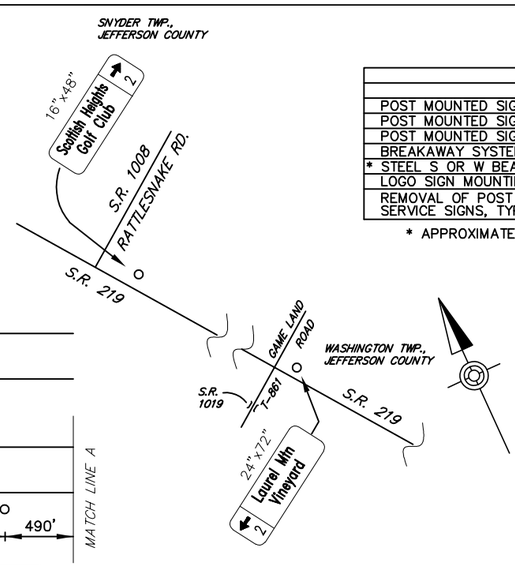

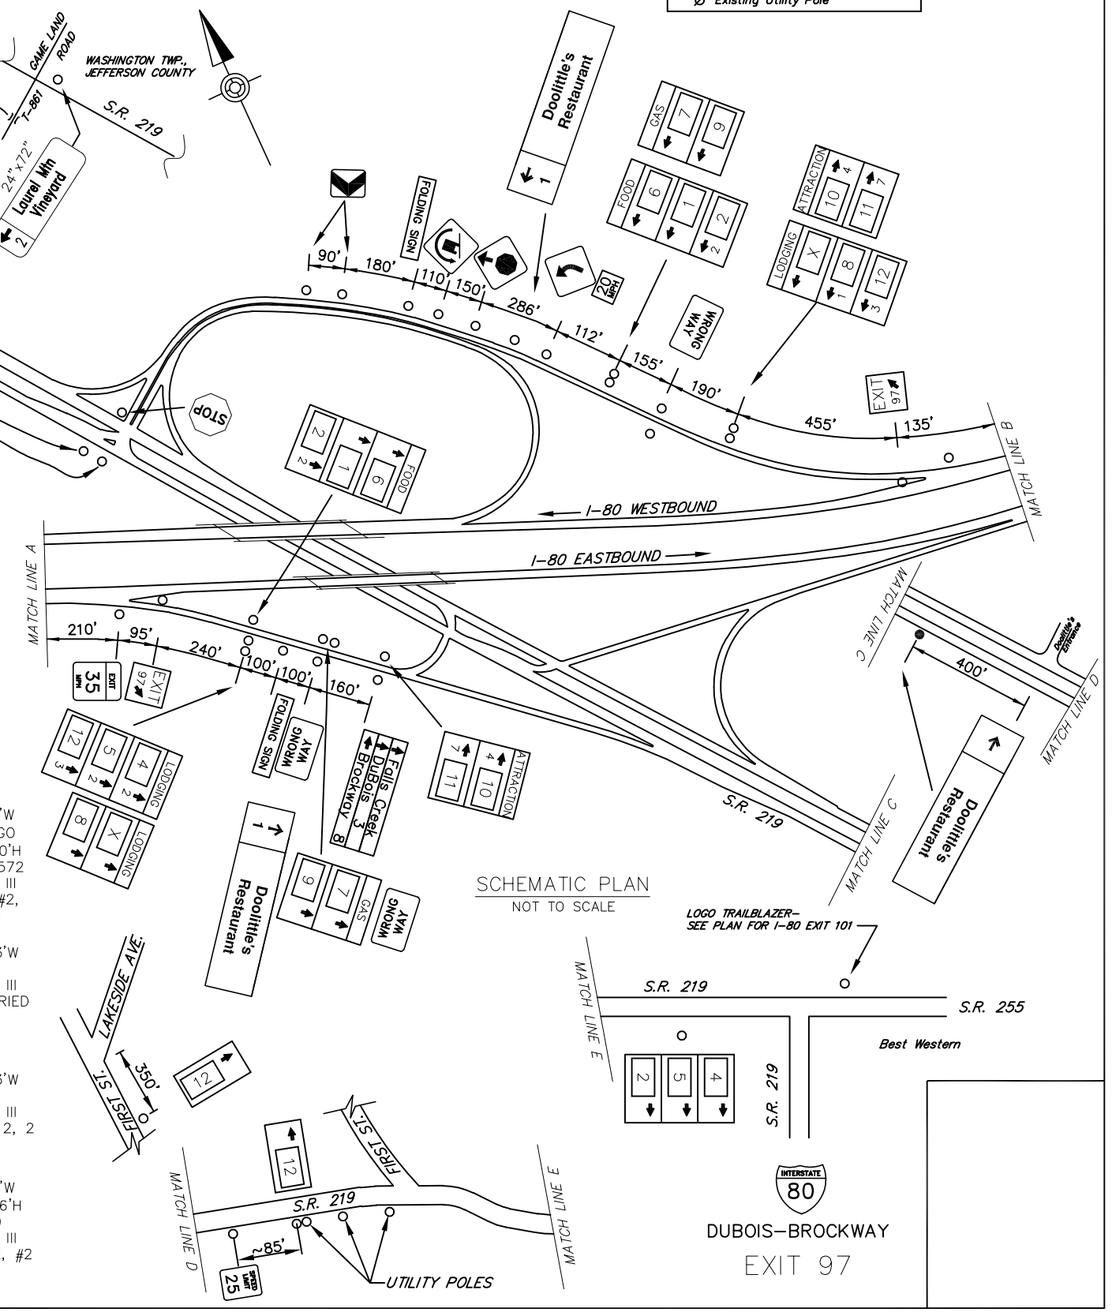

SCHEMATIC PLAN
NOT TO SCALE

LOGO TRAILBLAZER-
SEE PLAN FOR I-80 EXIT 101

EXIT 97 SPECIFIC INFORMATION PANEL			
LEGEND	DIRECTION	BUSINESS	LOGO NO.
GAS	EB/WB	SHEETZ (DIESEL)	7
		PILOT (24 HRS)	9
FOOD	EB/WB	ARBY'S	1
		HOSS'S STEAK AND SEA HOUSE	2
		DUTCH PANTRY	6
LODGING	EB/WB		
		BEST WESTERN	4
		DUBOIS MANOR MOTEL	5
		HOLIDAY INN EXPRESS & SUITES	8
		COMFORT SUITES	12
ATTRACTION	EB/WB	LAUREL MOUNTAIN WINERY	10
		SCOTTISH HEIGHTS GOLF CLUB	11

EB SIGNS

6'H x 16'W
48"W LOGO'
FUTURE 10'H
W10x26 A572
3M TYPE III
B650 – #2, #1

10'H x 13'W
W8x21
3M TYPE III
B525 – ?, #1

10'H x 13'W
W8x21
3M TYPE III
B525 – ?, #1

14'H x 13'W
FUTURE 16'H
W14x30
3M TYPE III
B650 – #1, #1

WB SIGNS

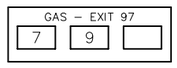

6'H x 16'W
48"W LOGO
FUTURE 10'H
W10x26 A572
3M TYPE III
B650 – #2,
BURIED

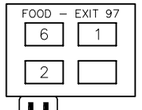

10'H x 13'W
W8x21
3M TYPE III
BRKTS–BURIED

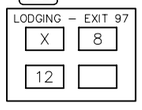

10'H x 13'W
W8x18
3M TYPE III
SBBK5M – 2, 2

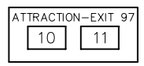

6'H x 13'W
FUTURE 16'H
W14x30
3M TYPE III
B650 – #2, #2

\\DAV3DJCC\DATA\PROJECTS\2015\D0103\D150776-01\WORKFILES\AS-BUILT DRAWINGS\PENNDOT DISTRICT 02\CLEARFIELD - 17\10-XX SHTRK-RRR_EXIT 97 PLAN
January/19/2022 12:56 PM