| DISTRICT | COUNTY | ROUTE | PROJECT | SHEET |
|---|---|---|---|---|
| 8-0 | FRANKLIN | I-81 | | |
| GUILFORD TWP. & CHAMBERSBURG BORO | | | | |
| REVISIONS | | | | |

| TABULATION OF QUANTITIES | | |
|---|---|---|
| ITEM | UNIT | QUANTITY |
| POST MOUNTED SIGNS, TYPE A, LOGO | SQ.FT. | |
| POST MOUNTED SIGNS, TYPE A, LOGO (MODIFIED) | SQ.FT. | |
| POST MOUNTED SIGNS, TYPE C, LOGO | SQ.FT. | |
| BREAKAWAY SYSTEMS | EACH | |
| * STEEL S OR W BEAM POSTS | LBS. | |
| LOGO SIGN MOUNTING | EACH | |
| LOGO SIGN MOUNTING, RESET | EACH | |
| REMOVAL OF POST MOUNTED MOTORIST SERVICE SIGNS, TYPES A & E | EACH | – |
| REMOVAL OF POST MOUNTED MOTORIST SERVICE SIGNS, TYPES B, C & F | L.S. | |

* APPROXIMATE QUANTITY FOR INFORMATION ONLY

**SYMBOLS**

- ○ *Existing Sign to Remain*
- △ *Existing Sign to be Removed*
- □ *Existing Sign Reset as Shown*
- ● NEW SIGN
- × FUTURE SIGN
- Ø *Existing Utility Pole*

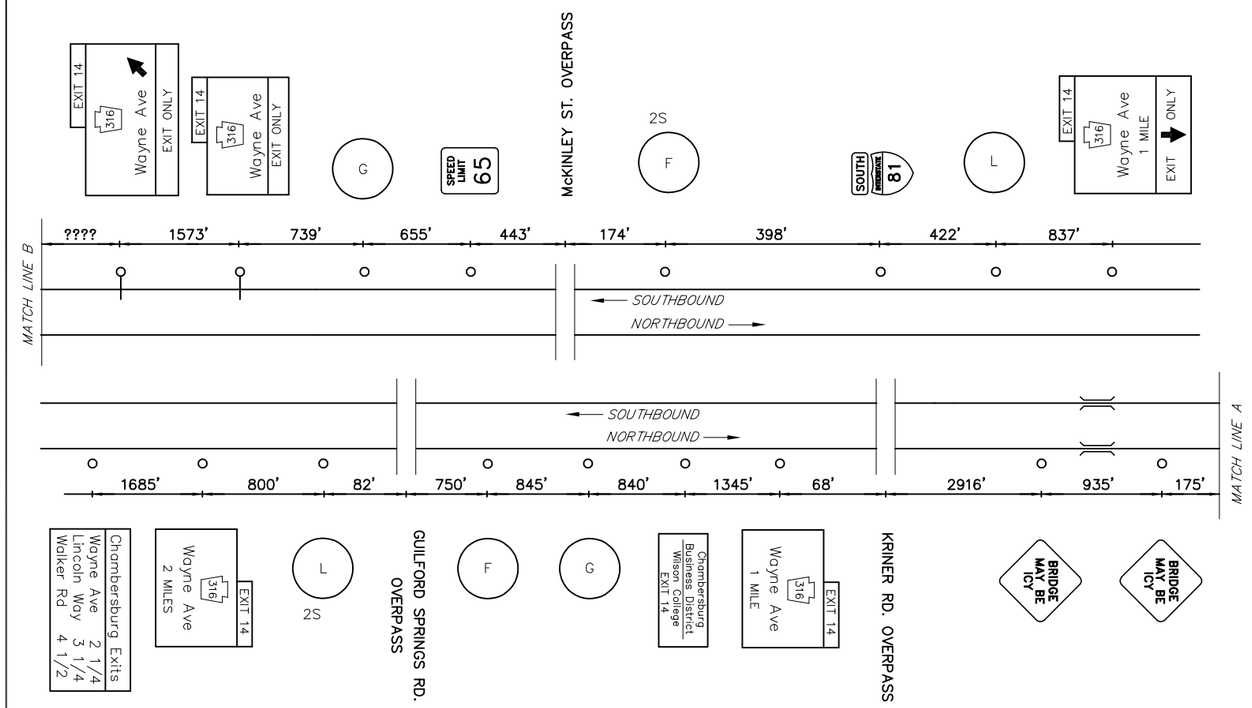


MAINLINE SCHEMATIC
NOT TO SCALE

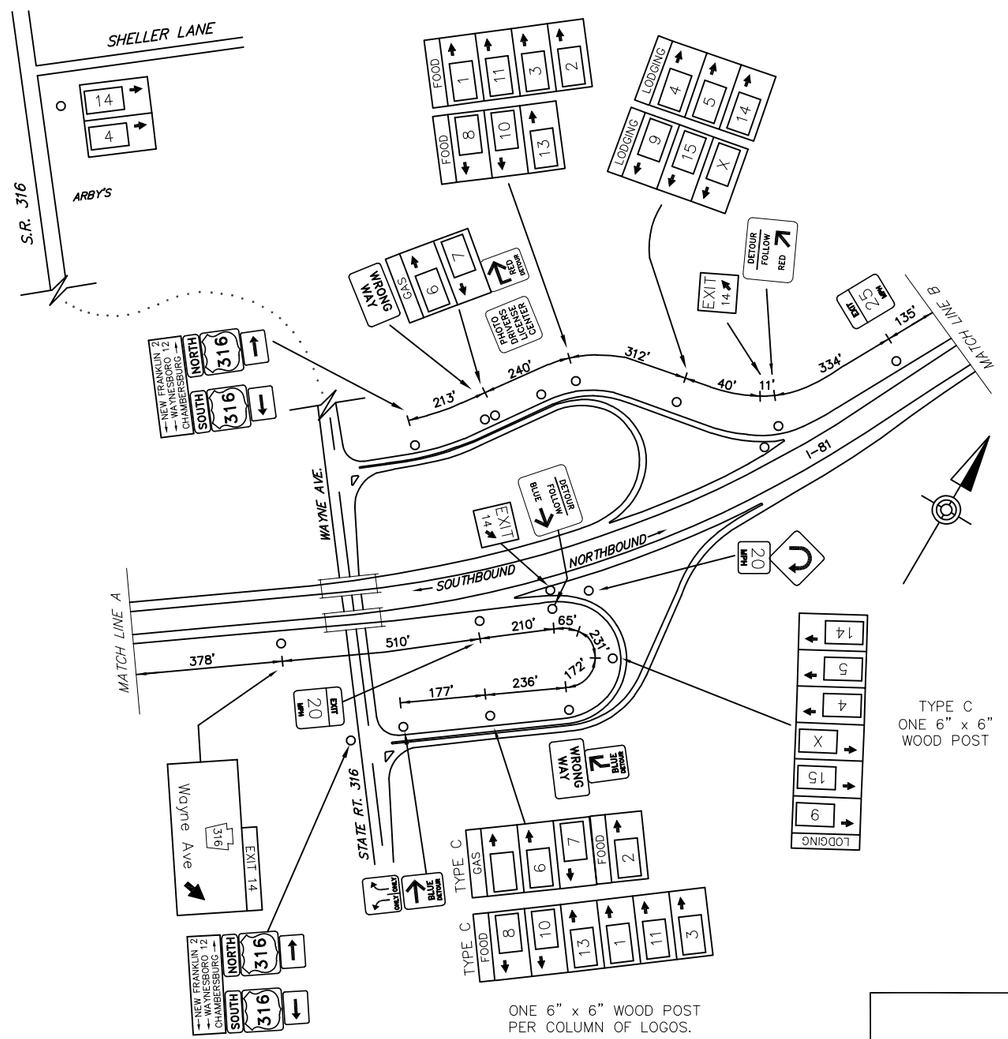


SCHEMATIC PLAN
NOT TO SCALE

INTERSTATE 81

WAYNE AVENUE

EXIT 14

## LEGEND

2S – GUIDE RAIL.

FREEWAY LANE CLOSURES & RESTRICTIONS ONLY PERMITTED BETWEEN 9:00 PM AND 6:00 AM MONDAY THRU FRIDAY. WORK ALONG FREEWAY PERMITTED BETWEEN 9:00 AM AND 2:30 PM, UNLESS OTHERWISE APPROVED BY ENGINEERING DISTRICT. DO NOT WORK DURING HOLIDAY PERIODS. IF APPLICABLE, REINSTALL GUIDERAIL AT END OF EACH DAY.

| EXIT 14 SPECIFIC INFORMATION PANEL | | | |
|---|---|---|---|
| LEGEND | DIRECTION | BUSINESS | LOGO NO. |
| GAS | NB/SB | SHEETZ (DIESEL) | 7 |
| | | SUNOCO | 6 |
| | | | |
| FOOD | NB/SB | WENDY'S | 3 |
| | | BOB EVANS RESTAURANT | 8 |
| | | CRACKER BARREL | 10 |
| | | APPLEBEE'S | 11 |
| | | ARBY'S | 13 |
| | | STARBUCKS | 1 |
| | | DUNKIN' | 2 |
| | | | |
| LODGING | NB/SB | ECONO LODGE | 4 |
| | | RED ROOF INN | 5 |
| | | HAMPTON INN | 9 |
| | | HOLIDAY INN EXPRESS & SUITES | 14 |
| | | RED CARPET INN | 15 |
| | | | |

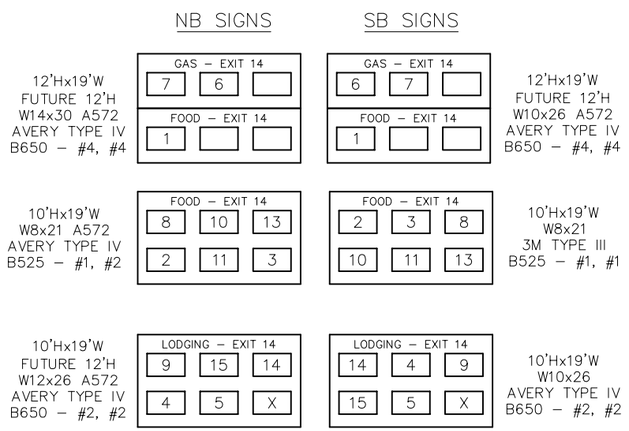


\\DAVIDDC\DATA\PROJECTS\0015.0283\325076-01\MV\PSE\AS-BUILT DRAWINGS\PENNDOT DISTRICT 08\FRANKLIN - 28\10-XX SHTXX-I81_EXIT 14 PLAN
January/17/2022 2:51 PM