DISTRICT	COUNTY	ROUTE	PROJECT	SHEET
8-0	FRANKLIN	I-81		

GREENE TOWNSHIP AND CHAMBERSBURG BORO

REVISIONS

TABULATION OF QUANTITIES		
ITEM	UNIT	QUANTITY
POST MOUNTED SIGNS, TYPE A, LOGO	SQ.FT.	
POST MOUNTED SIGNS, TYPE B, LOGO	SQ.FT.	
POST MOUNTED SIGNS, TYPE C, LOGO	SQ.FT.	
BREAKAWAY SYSTEMS	EACH	
* STEEL S OR W BEAM POSTS	LBS.	
LOGO SIGN MOUNTING	EACH	
EXTRUDED PANEL REPLACEMENT	SQ.FT.	
REMOVAL OF POST MOUNTED MOTORIST SERVICE SIGNS, TYPES B, C & F	L.S.	

* APPROXIMATE QUANTITY FOR INFORMATION ONLY

SYMBOLS

- ○ *Existing Sign to Remain*
- △ *Existing Sign to be Removed*
- □ *Existing Sign Reset as Shown*
- ● NEW SIGN
- × FUTURE SIGN
- Ø *Existing Utility Pole*

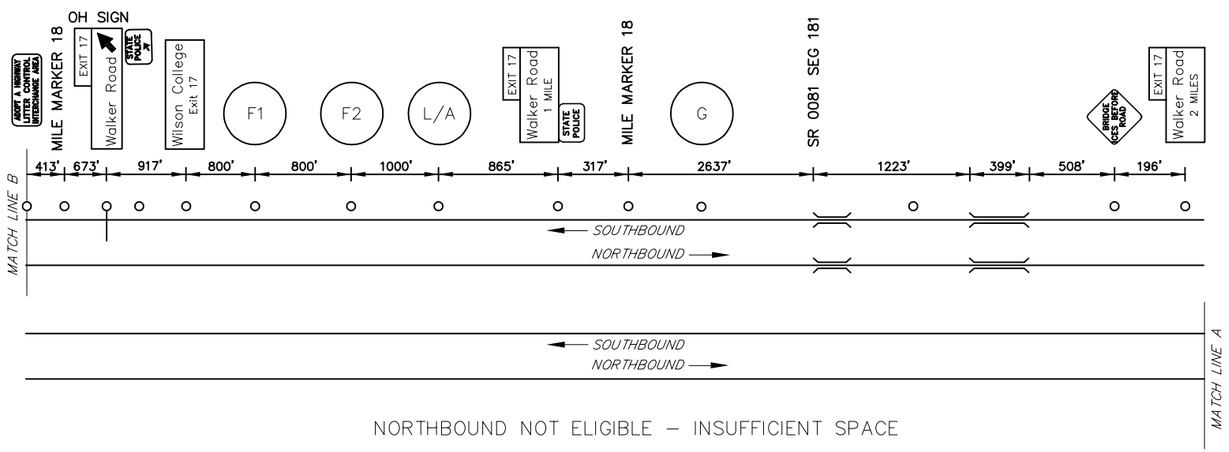

NORTHBOUND NOT ELIGIBLE – INSUFFICIENT SPACE

MAINLINE SCHEMATIC
NOT TO SCALE

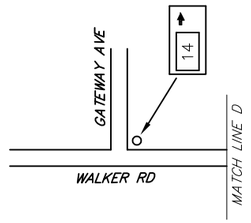

FREEWAY LANE CLOSURES & RESTRICTIONS ONLY PERMITTED BETWEEN 9:00 PM AND 6:00 AM MONDAY THRU FRIDAY. WORK ALONG FREEWAY PERMITTED BETWEEN 9:00 AM AND 2:30 PM, UNLESS OTHERWISE APPROVED BY ENGINEERING DISTRICT. DO NOT WORK DURING HOLIDAY PERIODS. IF APPLICABLE, REINSTALL GUIDERAIL AT END OF EACH DAY.

EXIT 17 SPECIFIC INFORMATION PANEL			
LEGEND	DIRECTION	BUSINESS	LOGO NO.
GAS	SB	SHEETZ (DIESEL)	1
FOOD	SB	FUDDRUCKER'S	2
		PANERA BREAD	6
		RED ROBIN	7
		SUBWAY	9
		OLIVE GARDEN	10
		CHICK-FIL-A (CLOSED SUNDAY)	12
		LONGHORN STEAKHOUSE	15
LODGING	SB	COUNTRY INN & SUITES	4
		SPRINGHILL SUITES	14
ATTRACTION	SB	CLUGGY'S AMUSEMENT CENTER	3

SB SIGNS

F1
10'Hx19'W
FUTURE 12'H
W14 X 30
3M TYPE IX LEGEND
TYPE III BACKGROUND
B650 – #2, #2

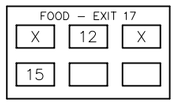

F2
10'Hx19'W
FUTURE 12'H
W12 X 26
3M TYPE IX LEGEND
TYPE III BACKGROUND
B650 – #2, #2

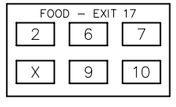

12'Hx19'W
W12 X 26
3M TYPE IX LEGEND
TYPE III BACKGROUND
B650 – #1, #2

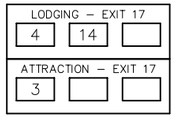

6'Hx19'W
FUTURE 12'H
W8 X 21 A572
AVERY TYPE IV
BACKGROUND
B525 – #4, #4

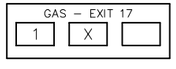

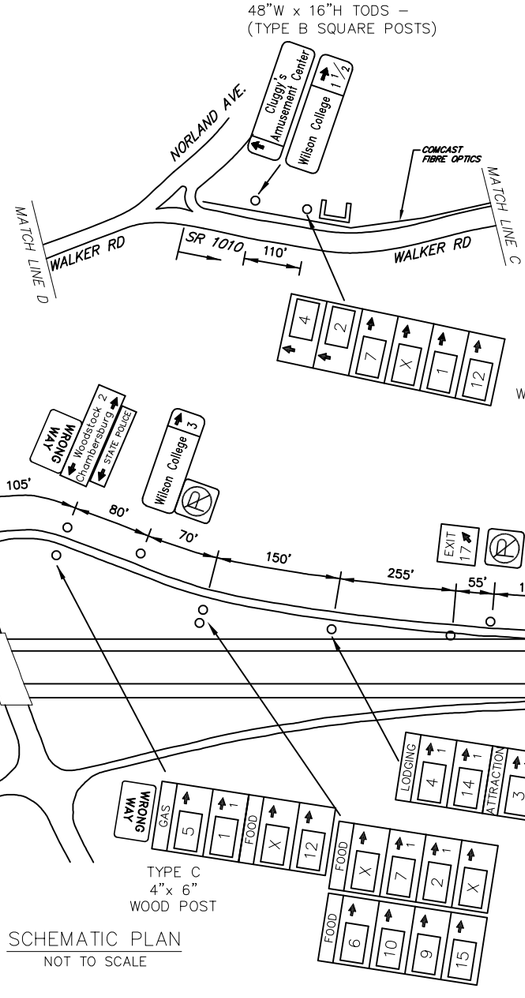

SCHEMATIC PLAN
NOT TO SCALE

INTERSTATE 81

WALKER ROAD
EXIT 17

\\DAVIDDCC\DATA\PROJECTS\2015\08ER\315076-01\HV\PSE\AS-BUILT DRAWINGS\PENNDOT DISTRICT 08\FRANKLIN - 28\10-XX SHTXX-I81_EXIT 17 PLAN
January/18/2022 11:34 AM