DISTRICT	COUNTY	ROUTE	PROJECT	SHEET
8-0	CUMBERLAND	I-81		

HAMPDEN & EAST PENNSBORO TOWNSHIPS

REVISIONS

TABULATION OF QUANTITIES		
ITEM	UNIT	QUANTITY
POST MOUNTED SIGNS, TYPE A, LOGO	SQ.FT.	--
POST MOUNTED SIGNS, TYPE B, LOGO	SQ.FT.	--
POST MOUNTED SIGNS, TYPE C, LOGO	SQ.FT.	--
BREAKAWAY SYSTEMS	EACH	--
* STEEL S OR W BEAM POSTS	LBS.	--
RESET POST MOUNTED SIGNS, TYPE B, LOGO, MODIFIED	EACH	-
RESET POST MOUNTED SIGNS, TYPE C, LOGO, MODIFIED	EACH	-
LOGO SIGN MOUNTING	EACH	--

* APPROXIMATE QUANTITY FOR INFORMATION ONLY

SYMBOLS

- ○ Existing Sign to Remain
- △ Existing Sign to be Removed
- □ Existing Sign Reset as Shown
- ◪ Existing Sign Foundation
- ● NEW SIGN
- × FUTURE SIGN
- Ø Existing Utility Pole

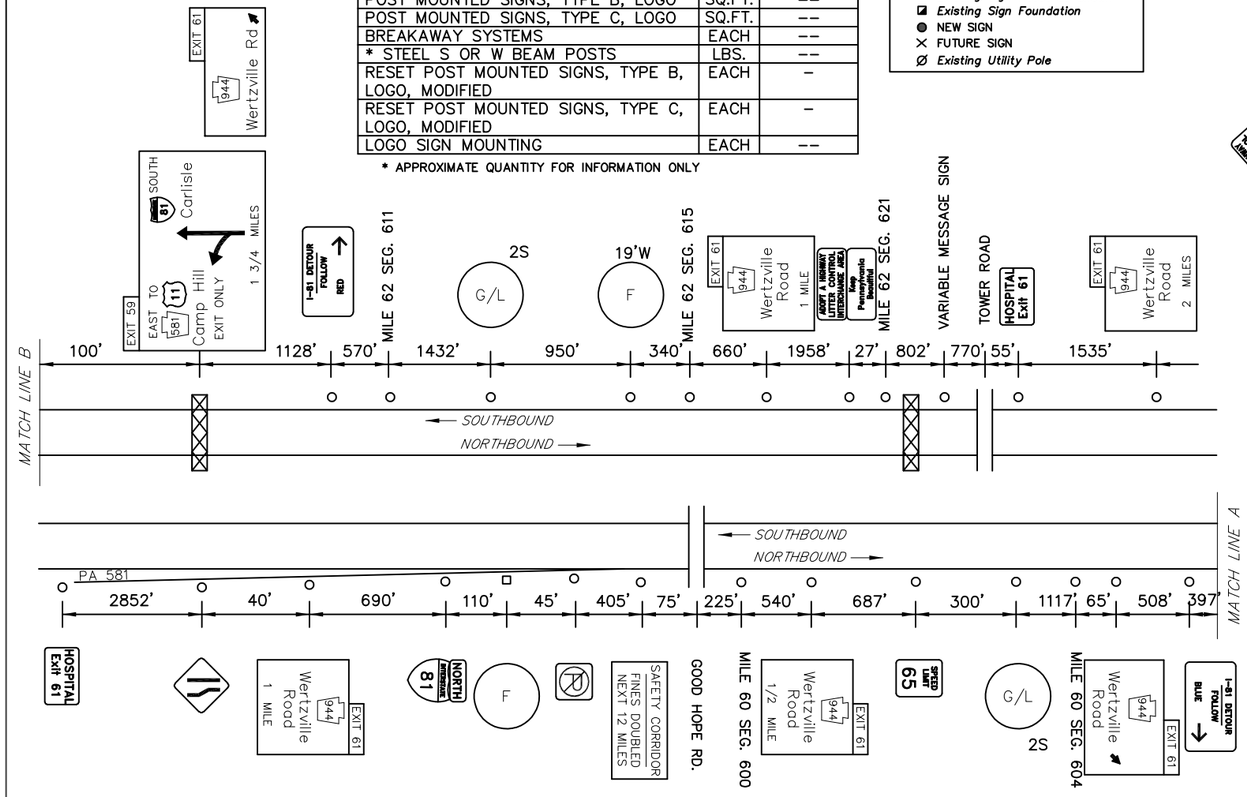

MAINLINE SCHEMATIC
NOT TO SCALE

LEGEND

2S – GUIDE RAIL

FREEWAY LANE CLOSURES & RESTRICTIONS
ONLY PERMITTED BETWEEN 9:00 PM AND
6:00 AM MONDAY THRU FRIDAY.
DO NOT WORK DURING HOLIDAY PERIODS.

EXIT 61 SPECIFIC INFORMATION PANEL			
LEGEND	DIRECTION	BUSINESS	LOGO NO.
GAS	NB/SB	TURKEY HILL	1
		GIANT GASOLINE	5
		WEIS MARKETS	8
FOOD	NB/SB	AL'S OF HAMPDEN/ PIZZA BOY BREWING	10
		BURGER KING	6
		TACO BELL	9
LODGING	NB/SB	HOLIDAY INN EXPRESS & SUITES	2
		BEST WESTERN PLUS	4

NB SIGNS

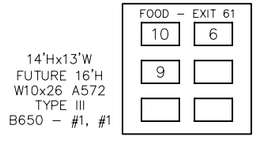

SB SIGNS

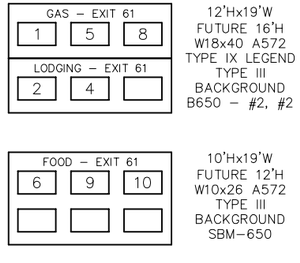

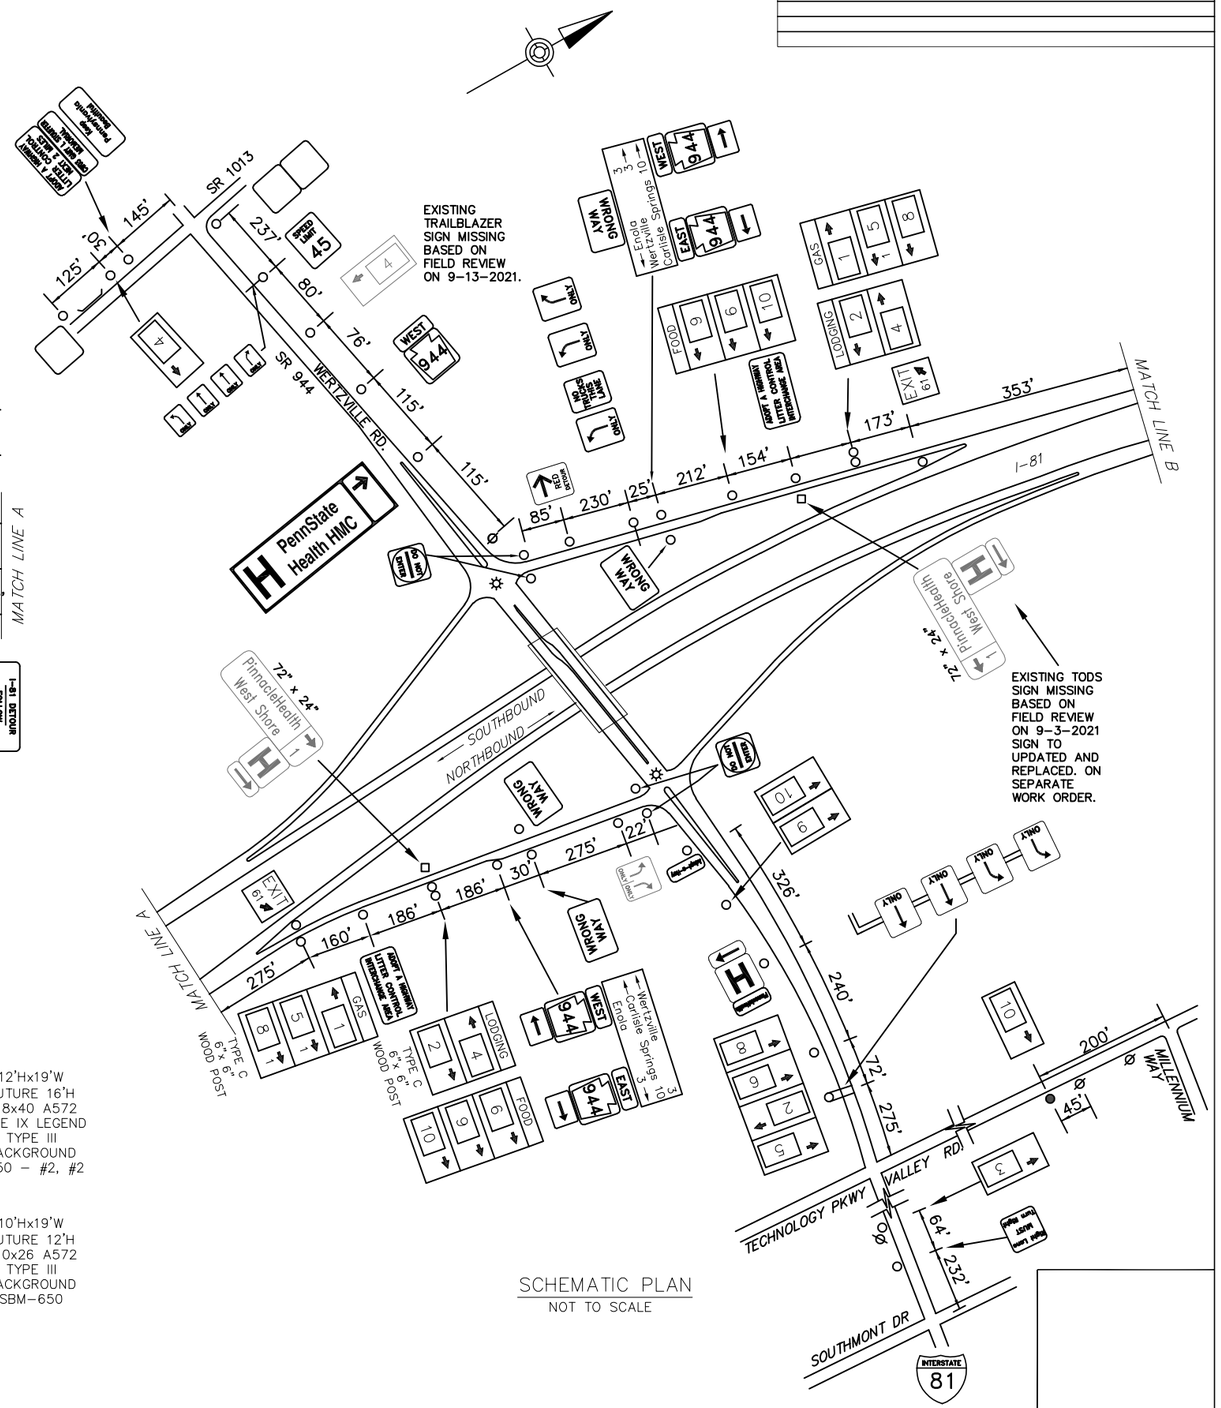

SCHEMATIC PLAN
NOT TO SCALE

\\DRAWDIR\\DATA\PROJECTS\2015_ADBS\215976-01\MKV\PSE\AS-BUILT DRAWINGS\PENNDOT DISTRICT 08\CUMBERLAND - 21\15-XX SHTXX 181_EXIT 61 PLAN
January/19/2022 1045 AM