DISTRICT	COUNTY	ROUTE	PROJECT	SHEET
8-0	CUMBERLAND	I-81		
EAST PENNSBORO TOWNSHIP				
REVISIONS				

TABULATION OF QUANTITIES		
ITEM	UNIT	QUANTITY
POST MOUNTED SIGNS, TYPE A, LOGO	SQ.FT.	–
POST MOUNTED SIGNS, TYPE A, LOGO (MODIFIED)	SQ.FT.	–
POST MOUNTED SIGNS, TYPE C, LOGO	SQ.FT.	–
BREAKAWAY SYSTEMS	EACH	–
* STEEL S OR W BEAM POSTS	LBS.	–
LOGO SIGN MOUNTING	EACH	–
LOGO SIGN MOUNTING, RESET	EACH	–
REMOVAL OF POST MOUNTED MOTORIST SERVICE SIGNS, TYPES A & E	EACH	–
REMOVAL OF POST MOUNTED MOTORIST SERVICE SIGNS, TYPES B, C & F	L.S.	–

* APPROXIMATE QUANTITY FOR INFORMATION ONLY

SYMBOLS

- ○ *Existing Sign to Remain*
- △ *Existing Sign to be Removed*
- □ *Existing Sign Reset as Shown*
- ● NEW SIGN
- × FUTURE SIGN
- Ø *Existing Utility Pole*

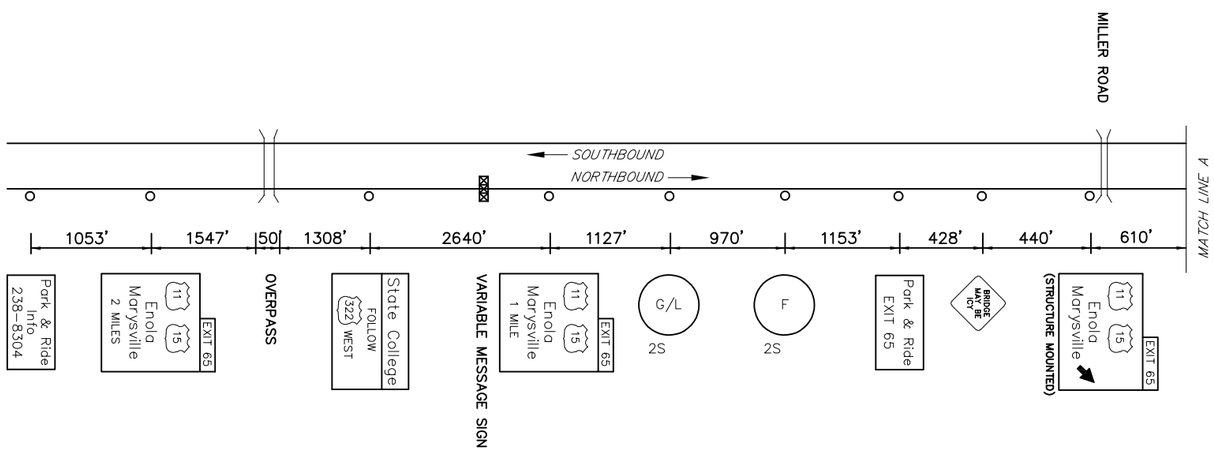

MAINLINE SCHEMATIC
NOT TO SCALE

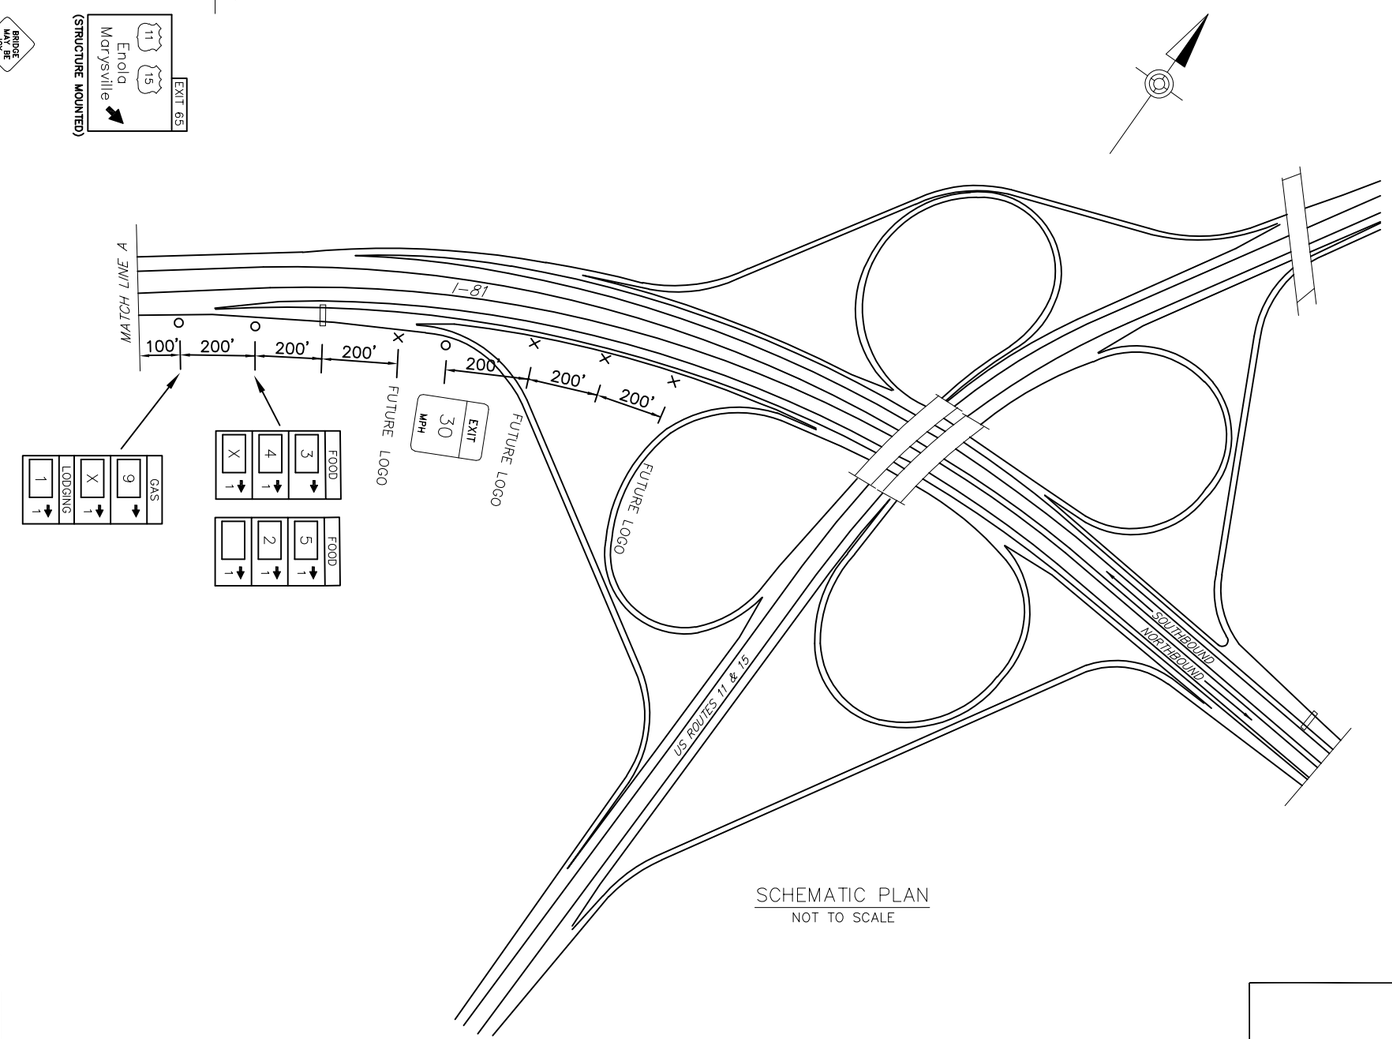

SCHEMATIC PLAN
NOT TO SCALE

LEGEND

2S – GUIDE RAIL

FREEWAY LANE CLOSURES & RESTRICTIONS ONLY PERMITTED BETWEEN 9:00 PM AND 6:00 AM MONDAY THRU FRIDAY.
WORK ALONG FREEWAY PERMITTED BETWEEN 9:00 AM AND 2:30 PM, UNLESS OTHERWISE APPROVED BY ENGINEERING DISTRICT.
DO NOT WORK DURING HOLIDAY PERIODS.
IF APPLICABLE, REINSTALL GUIDERAIL AT END OF EACH DAY.

EXIT 65 SPECIFIC INFORMATION PANEL			
LEGEND	DIRECTION	BUSINESS	LOGO NO.
GAS	NB		
		SUNOCO (DIESEL)	9
FOOD	NB	WENDY'S	3
		McDONALD'S	4
		DQ GRILL & CHILL	2
		DUNKIN' DONUTS (OPEN 24 HOURS)	5
LODGING	NB	QUALITY INN	1

NB SIGNS

14'Hx13'W
W12x26
AVERY TYPE IV
B650 – #1, #1

FOOD – EXIT 65	
3	4
X	5
2	

12'Hx13'W
W12x26
B650 – #1, #1

GAS – EXIT 65	
X	9
LODGING – EXIT 65	
1	

INTERSTATE 81

ENOLA – MARYSVILLE

EXIT 65

\\DAVOIDJCC\DATA\PROJECTS\2015\JOBS\215076-01\HV\PSE\AS-BUILT DRAWINGS\PENNDOT DISTRICT 08\CUMBERLAND - 21\10-XX SHTXX IRL_EXIT 65 PLAN
January/21/2022 10:48 AM