DISTRICT	COUNTY	ROUTE	PROJECT	SHEET
6-0	BUCKS	US-1		

MIDDLETOWN, FALLS, LOWER MAKEFORD TOWNSHIPS

REVISIONS

TABULATION OF QUANTITIES		
ITEM	UNIT	QUANTITY
POST MOUNTED SIGNS, TYPE A, LOGO	SQ.FT.	
POST MOUNTED SIGNS, TYPE B, LOGO	SQ.FT.	
POST MOUNTED SIGNS, TYPE C, LOGO	SQ.FT.	
BREAKAWAY SYSTEMS	EACH	
* STEEL S OR W BEAM POSTS	LBS.	
LOGO SIGN MOUNTING	EACH	
REMOVAL OF POST MOUNTED MOTORIST SERVICE SIGNS, TYPES B, C & F	L.S.	

* APPROXIMATE QUANTITY FOR INFORMATION ONLY

SYMBOLS

- ○ Existing Sign to Remain
- △ Existing Sign to be Removed
- □ Existing Sign Reset as Shown
- ● NEW SIGN
- × FUTURE SIGN
- Ø Existing Utility Pole

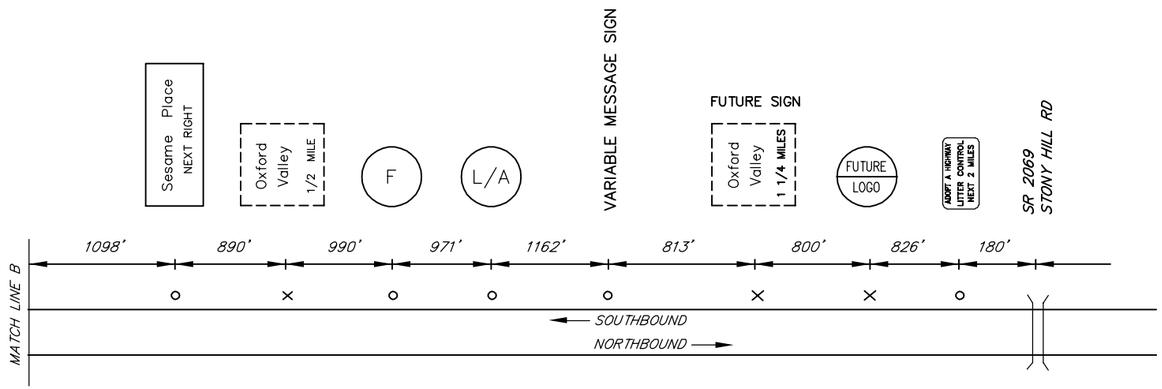

NB NOT ELIGIBLE – INSUFFICIENT SPACE

MAINLINE SCHEMATIC
NOT TO SCALE

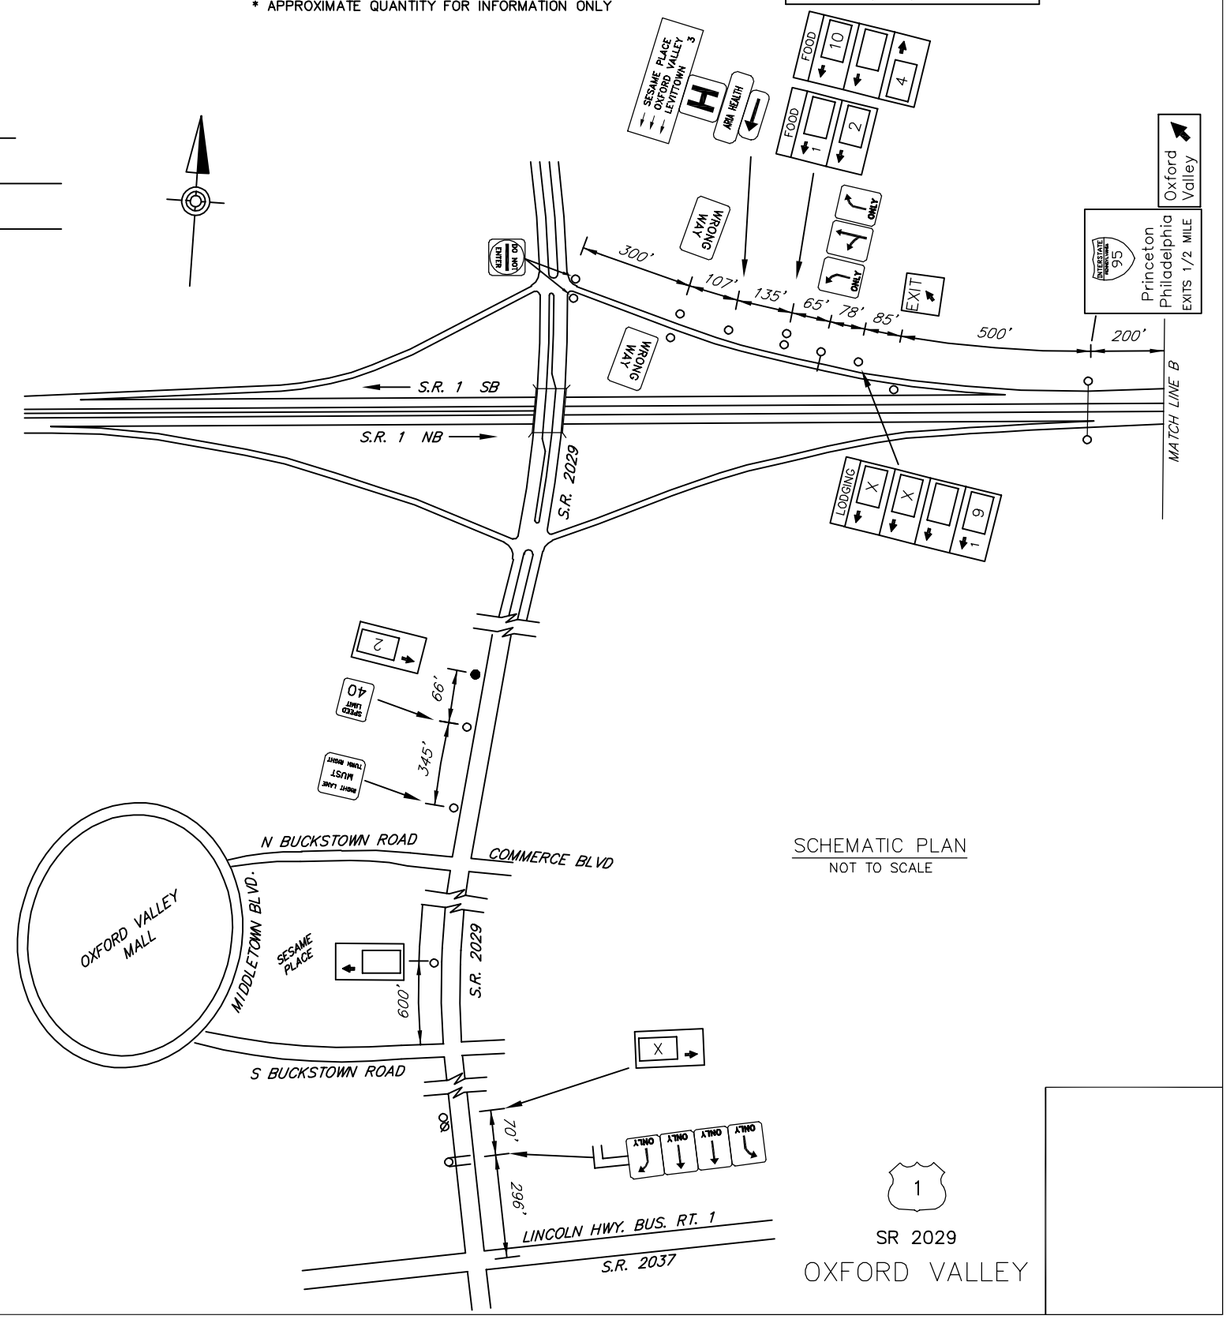

SCHEMATIC PLAN
NOT TO SCALE

OXFORD VALLEY EXIT SPECIFIC INFORMATION PANEL			
LEGEND	DIRECTION	BUSINESS	LOGO NO.
FOOD	SB	STARBUCKS COFFEE	4
		TACO BELL	10
		RAISING CANE'S CHICKEN FINGERS	2
LODGING	SB		
		SPRINGHILL SUITES–MARRIOTT	9
ATTRACTION	SB		

SB SIGNS

10'Hx13'W
FUTURE 16'H
W14x30 A572
B650 – #2, #2

FOOD–NEXT RIGHT	
4	10
2	X

16'Hx13'W
W14x30 A572
3M TYPE III
B650 – #1, #1

LODGING–NEXT RIGHT	
X	
	9
ATTRACTION–NEXT RIGHT	
X	

1

SR 2029

OXFORD VALLEY

\\DAVIDDCC\DATA\PROJECTS\2015JOBS\215076-01\HW\PSE\AS-BUILT DRAWINGS\PENNDOT DISTRICT 06\BUCKS - 09\10-XX SHTXX-US1_OXFORD VALLEY EXIT PLAN
November/23/2022 9:15 AM