DISTRICT	COUNTY	ROUTE	PROJECT	SHEET
3-0	TIOGA	US 15		

RICHMOND TOWNSHIP AND MANSFIELD BORO

REVISIONS

TABULATION OF QUANTITIES		
ITEM	UNIT	QUANTITY
POST MOUNTED SIGNS, TYPE A, LOGO	SQ.FT.	
POST MOUNTED SIGNS, TYPE A, LOGO (MODIFIED)	SQ.FT.	–
POST MOUNTED SIGNS, TYPE B, LOGO	SQ.FT.	
BREAKAWAY SYSTEMS	EACH	–
* STEEL S OR W BEAM POSTS	LBS.	–
LOGO SIGN MOUNTING	EACH	–
LOGO SIGN MOUNTING, RESET	EACH	–
REMOVAL OF POST MOUNTED MOTORIST SERVICE SIGNS, TYPES A & E	EACH	

* APPROXIMATE QUANTITY FOR INFORMATION ONLY

SYMBOLS

- ○ *Existing Sign to Remain*
- △ *Existing Sign to be Removed*
- □ *Existing Sign Reset as Shown*
- ● NEW SIGN
- × FUTURE SIGN
- Ø *Existing Utility Pole*

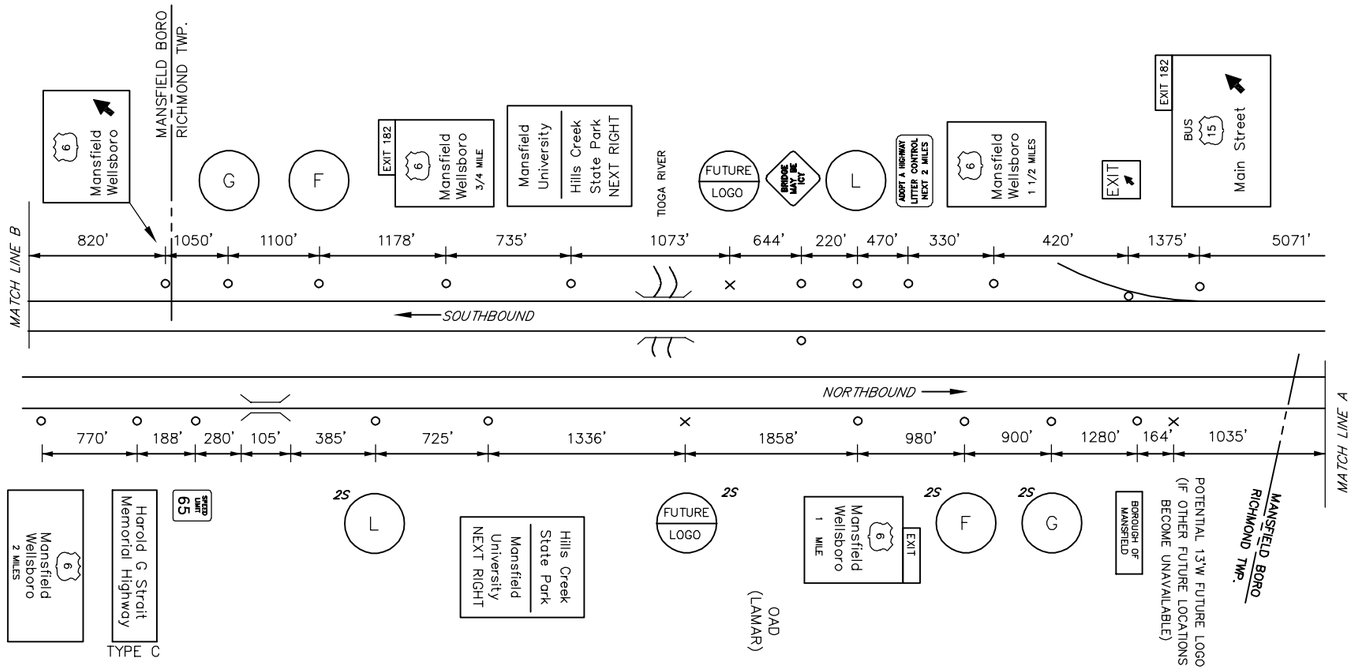

MAINLINE SCHEMATIC
NOT TO SCALE

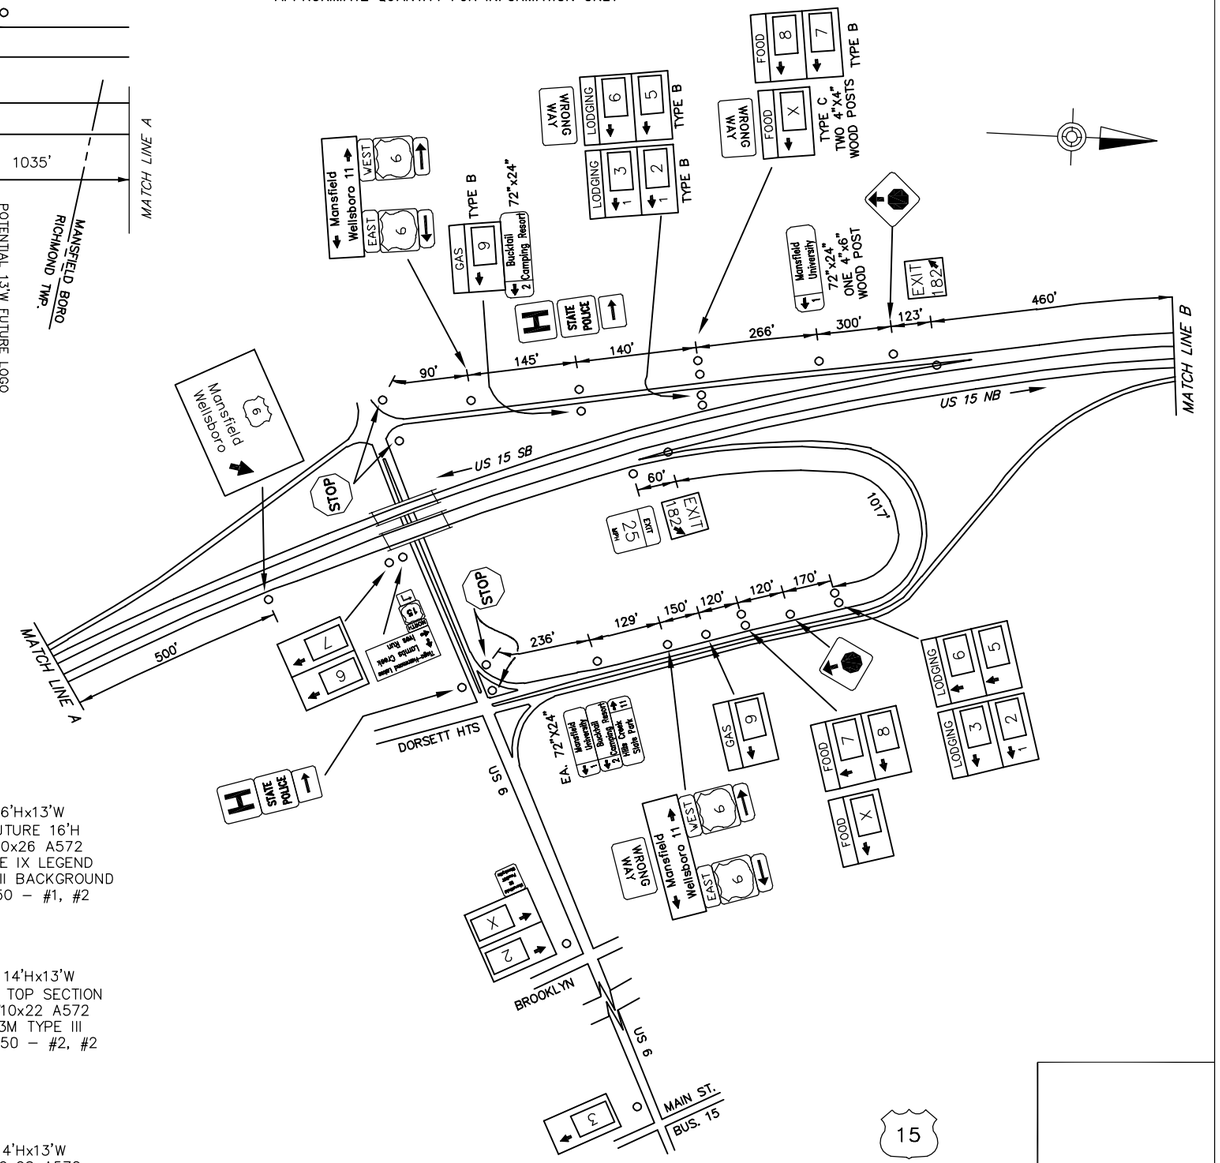

SCHEMATIC PLAN
NOT TO SCALE

LEGEND

2S – GUIDE RAIL

EXIT 182 SPECIFIC INFORMATION PANEL			
LEGEND	DIRECTION	BUSINESS	LOGO NO.
GAS	NB/SB	SHEETZ (DIESEL)	9
FOOD	NB/SB		
		SHEETZ	8
		PERKIN'S RESTAURANT & BAKERY	7
LODGING	NB/SB	QUALITY INN	2
		MANSFIELD INN	3
		MICROTEL INN & SUITES	5
		HAMPTON INN & SUITES	6

	NB SIGNS	SB SIGNS	
6'Hx13'W FUTURE 16'H W14x30 A572 TYPE IX LEGEND TYPE III BACKGROUND B650 – #3, #1	GAS – EXIT 182: 9	GAS – EXIT 182: 9	6'Hx13'W FUTURE 16'H W10x26 A572 TYPE IX LEGEND TYPE III BACKGROUND B650 – #1, #2
14'Hx13'W W10x26 A572 3M TYPE III B650 –#1, #1	FOOD – EXIT 182: X X / 7 8 / STATE POLICE	FOOD – EXIT 182: X X / 7 8 / STATE POLICE	14'Hx13'W 16' TOP SECTION W10x22 A572 3M TYPE III B650 – #2, #2
14'Hx13'W 16' TOP SECTION W10x22 A572 3M TYPE III B650 – #2, #1	LODGING– EXIT 182: 2 3 / 5 6 / H A	LODGING– EXIT 182: 2 3 / 5 6 / H A	14'Hx13'W W10x26 A572 3M TYPE III B650 – #1, #1

15
US 6
MANSFIELD
EXIT 182

\\SAVDDJCC\DATA\PROJECTS\2015\D803\ED5976-01\HW\PSE\AS-BUILT DRAWINGS\PENNDOT DISTRICT 03\TIOGA - SR\15-XX SHTXX-USIS_EXIT 182 (MANSFIELD) PLAN
October/11/2022 8:55 AM