DISTRICT	COUNTY	ROUTE	PROJECT	SHEET
5-0	NORTHAMPTON	PA 33	–	–

LOWER NAZARETH & PALMER TOWNSHIPS

REVISIONS

TABULATION OF QUANTITIES		
ITEM	UNIT	QUANTITY
* STEEL S OR W BEAM POSTS	LBS.	–
BREAKAWAY SYSTEMS	EACH	–
POST MOUNTED SIGNS, TYPE A, LOGO	SQ.FT.	–
POST MOUNTED SIGNS, TYPE B, LOGO	SQ.FT.	–
POST MOUNTED SIGNS, TYPE C, LOGO	SQ.FT.	–
LOGO SIGN MOUNTING	EACH	–

* APPROXIMATE QUANTITY FOR INFORMATION ONLY

SYMBOLS

- *Existing Sign to Remain*
- *Existing Sign to be Removed*
- *Existing Sign Reset as Shown*
- NEW SIGN
- FUTURE SIGN
- *Existing Utility Pole*

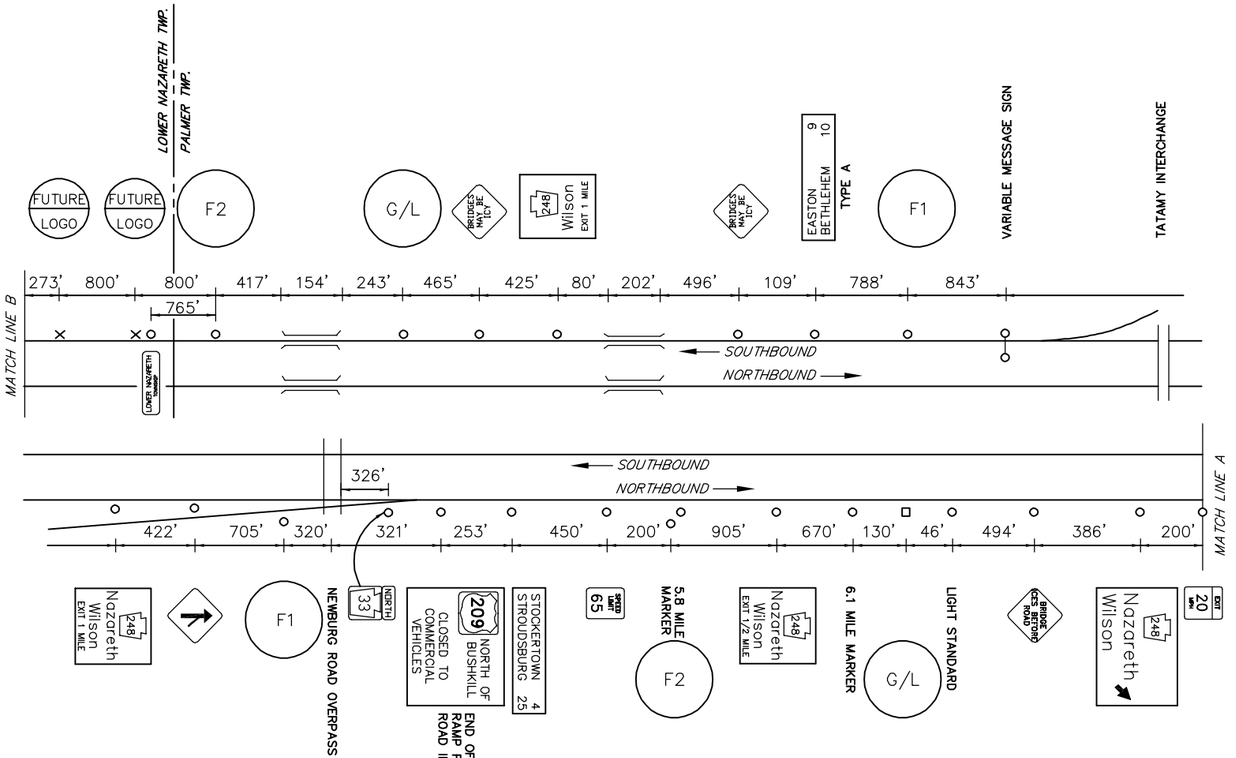

MAINLINE SCHEMATIC
NOT TO SCALE

DO NOT CLOSE OR RESTRICT TRAVEL LANES DURING RUSH HOUR. WORK ALONG FREEWAY PERMITTED BETWEEN 9:00 AM AND 2:30 PM, UNLESS OTHERWISE APPROVED BY ENGINEERING DISTRICT. DO NOT WORK DURING HOLIDAY. PERIODS IF APPICABLE, REINSTALL GUIDERAIL AT END OF EACH DAY.

33/WILSON SPECIFIC INFORMATION PANEL			
LEGEND	DIRECTION	BUSINESS	LOGO NO.
GAS	NB/SB	MOBIL (DIESEL)	10
		WAWA (24 HRS/DIESEL)	18
	NB	SHEETZ (DIESEL)	1
FOOD	NB/SB	RED ROBIN	3
		APPLEBEE'S	4
		STARBUCKS COFFEE	7
		McDONALD'S	8
		JERSEY MIKES	11
		BURGER KING	12
		CHICK-FIL-A (CLOSED SUNDAY)	13
		DINER 248	16
		PANERA BREAD	17
	NB	LONGHORN STEAKHOUSE	19
	SB		
LODGING	NB/SB	TRU BY HILTON	20
	SB	HAMPTON INN	2

SB SIGNS

F2

14'Hx13'W FUTURE 16'H W14x30 A572 3M TYPE III SBM 650 – #4, #4

FOOD – NEXT RIGHT	
13	X
11	12
16	17

16'Hx13'W W14x30 A572 3M TYPE III SBM 650 – #4, #4

GAS – NEXT RIGHT	
1	10
18	
LODGING–NEXT RIGHT	
2	20

F1

10'Hx19'W FUTURE 12'H W14x30 3M TYPE III SBM 650

FOOD–NEXT RIGHT		
3	4	X
X	7	8

NB SIGNS

12'Hx13'W FUTURE 16'H W14X30 A572 3M TYPE III SBM 650

GAS – NEXT RIGHT	
18	10
LODGING–NEXT RIGHT	
20	

F2

14'Hx13'W FUTURE 16'H W14x30 A572 3M TYPE III SBM 650 – #4, #4

FOOD – NEXT RIGHT	
13	X
11	16
17	12

F1

14'Hx13'W FUTURE 16'H W14x30 A572 3M TYPE III SBM 650 – #4, #4

FOOD – NEXT RIGHT	
8	4
3	7
19	

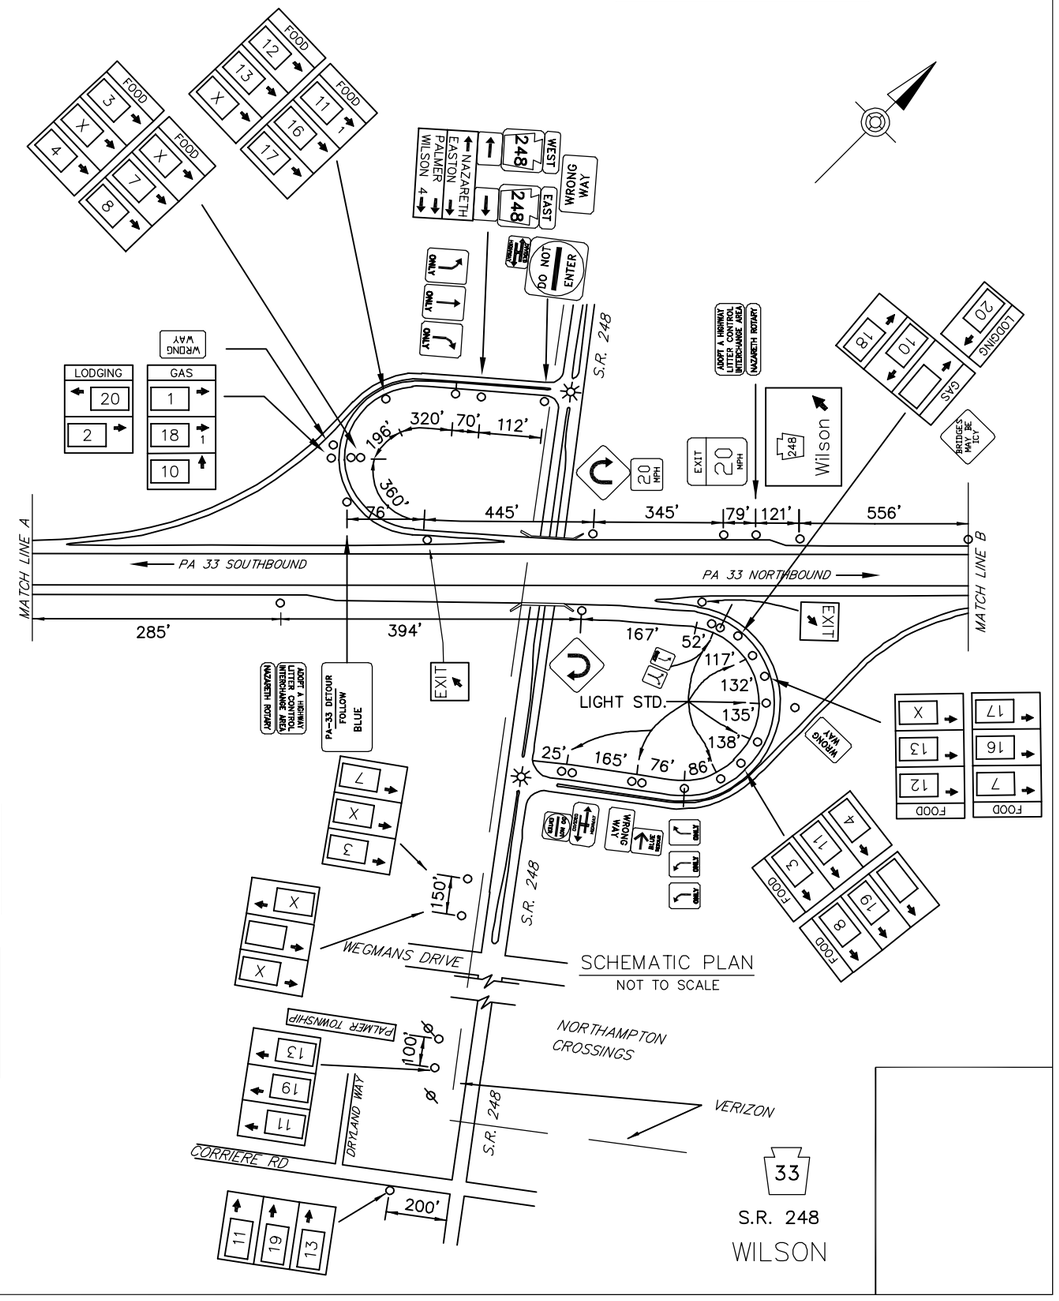

\\RBG-HAS2\NJDATA\PROJECTS\2015_0285\215076-01\HW\PSE-AS-BUILT DRAWINGS\PENNDOT DISTRICT 05\NORTHAMPTON - 489-10-XX SHTXX-33_EXIT WILSON PLAN
February 7, 2023 11:25 AM