| DISTRICT | COUNTY | ROUTE | PROJECT | SHEET |
|---|---|---|---|---|
| 11-0 | LAWRENCE | I-376 | 100-XX | X OF X |
| UNION TOWNSHIP AND CITY OF NEW CASTLE | | | | |
| REVISIONS | | | | |

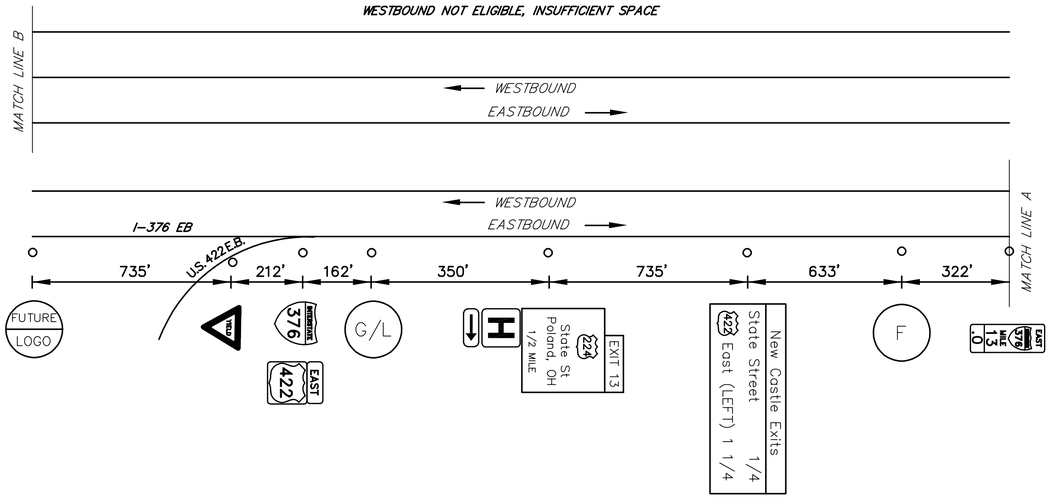


MAINLINE SCHEMATIC
NOT TO SCALE

| TABULATION OF QUANTITIES | | |
|---|---|---|
| ITEM | UNIT | QUANTITY |
| * STEEL S OR W BEAM POSTS | LBS. | -- |
| BREAKAWAY SYSTEMS | EACH | -- |
| POST MOUNTED SIGNS, TYPE A, LOGO | SQ.FT. | -- |
| POST MOUNTED SIGNS, TYPE B, LOGO | SQ.FT. | - |
| REMOVE POST MOUNTED SIGNS,TYPE B,LOGO | EACH | - |
| LOGO SIGN MOUNTING | EACH | - |
| LOGO SIGN MOUNTING, RESET | EACH | - |
| REMOVE POST MOUNTED SIGNS, TYPE A, LOGO MODIFIED | EACH | - |

* APPROXIMATE QUANTITY FOR INFORMATION ONLY

SYMBOLS

- ○ *Existing Sign to Remain*
- △ *Existing Sign to be Removed*
- □ *Existing Sign Reset as Shown*
- ● NEW SIGN
- × FUTURE SIGN
- Ø *Existing Utility Pole*

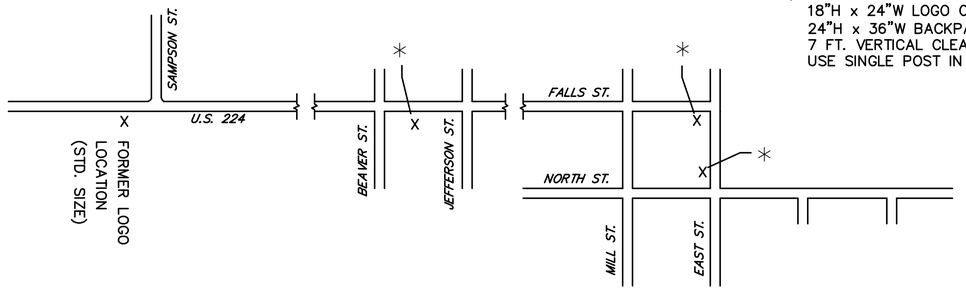


NOT TO SCALE

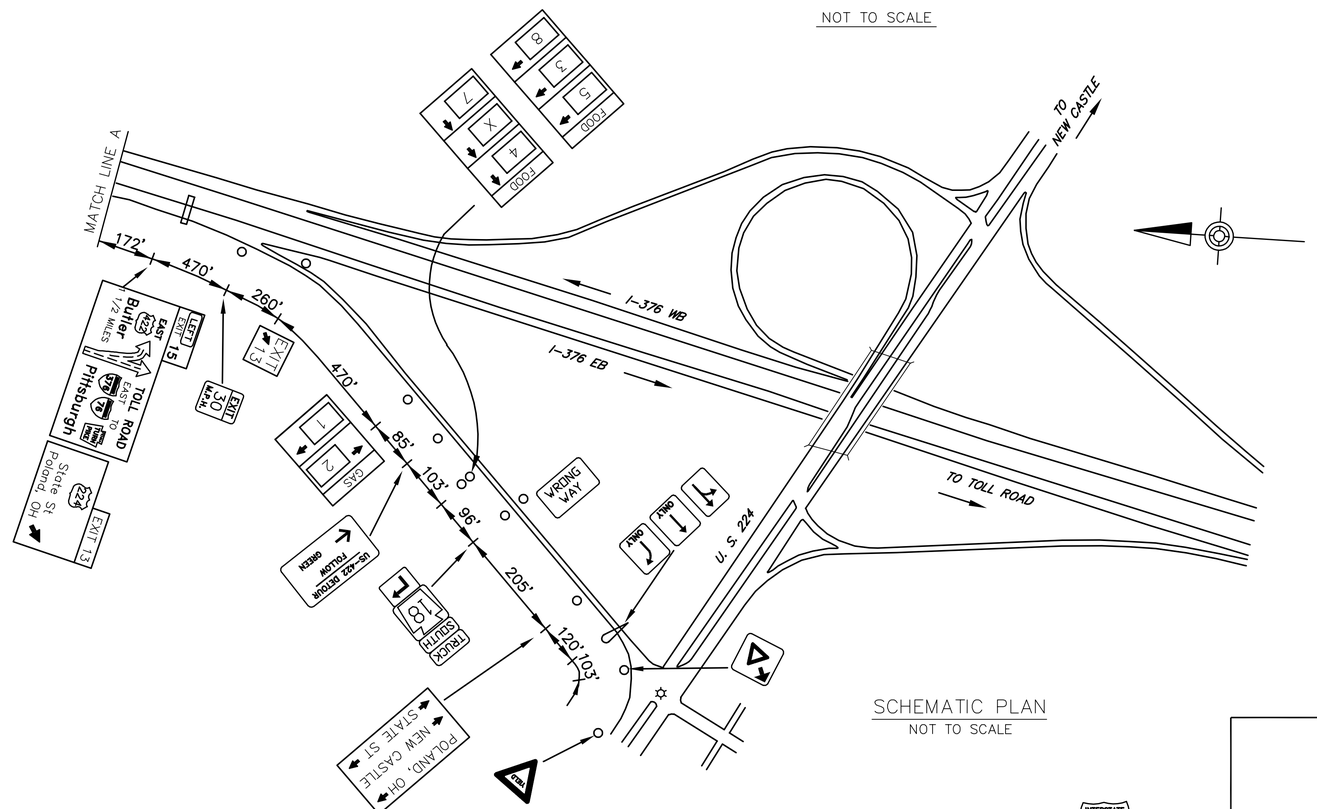


SCHEMATIC PLAN
NOT TO SCALE

| EXIT 13 SPECIFIC INFORMATION PANEL | | | |
|---|---|---|---|
| LEGEND | DIRECTION | BUSINESS | LOGO NO. |
| GAS | EB | GETGO (24 HOURS) | 2 |
| | | SHEETZ (DIESEL) | 1 |
| FOOD | EB | BOB EVANS RESTAURANT | 3 |
| | | ARBY'S | 4 |
| | | WENDY'S | 5 |
| | | | |
| | | RUBY TUESDAY | 7 |
| | | SHEETZ | 8 |
| LODGING | EB | | |
| | | | |

EB SIGNS

14'Hx13'W
FUTURE 16'H
W10x26 A572
3M TYPE III
SBM - 650

| FOOD - NEXT RIGHT | |
|---|---|
| 3 | 4 |
| 5 | X |
| 7 | 8 |

12'Hx13'W
FUTURE 14'H
W8x21 A572
3M TYPE III
B525 - BURIED

| GAS - NEXT RIGHT | |
|---|---|
| 2 | 1 |
| LODGING-NEXT RIGHT | |
| | |

INTERSTATE 376

US 224 / STATE ST

EXIT 13

D:\2015_JOBS\215074-01\MKT\PSE\AS-BUILT DRAWINGS\PENNDOT DISTRICT 11\LAWRENCE - 376\376_EXIT 13 PLAN
February 9, 2023 2:01 PM