DISTRICT	COUNTY	ROUTE	PROJECT	SHEET
11-0	BEAVER	I-376		

CENTER AND HOPEWELL TOWNSHIPS AND CITY OF ALIQUIPPA

REVISIONS

TABULATION OF QUANTITIES		
ITEM	UNIT	QUANTITY
POST MOUNTED SIGNS, TYPE A, LOGO	SQ.FT.	
POST MOUNTED SIGNS, TYPE B, LOGO	SQ.FT.	
BREAKAWAY SYSTEMS	EACH	
* STEEL W BEAM BREAKAWAY POSTS	LBS.	
LOGO SIGN MOUNTING	EACH	
REMOVAL OF POST MOUNTED MOTORIST SERVICE SIGNS, TYPES A, B, C, E & F	L.S.	—

* APPROXIMATE QUANTITY FOR INFORMATION ONLY

SYMBOLS

- ○ Existing Sign to Remain
- △ Existing Sign to be Removed
- □ Existing Sign Reset as Shown
- ● NEW SIGN
- × FUTURE SIGN
- Ø Existing Utility Pole

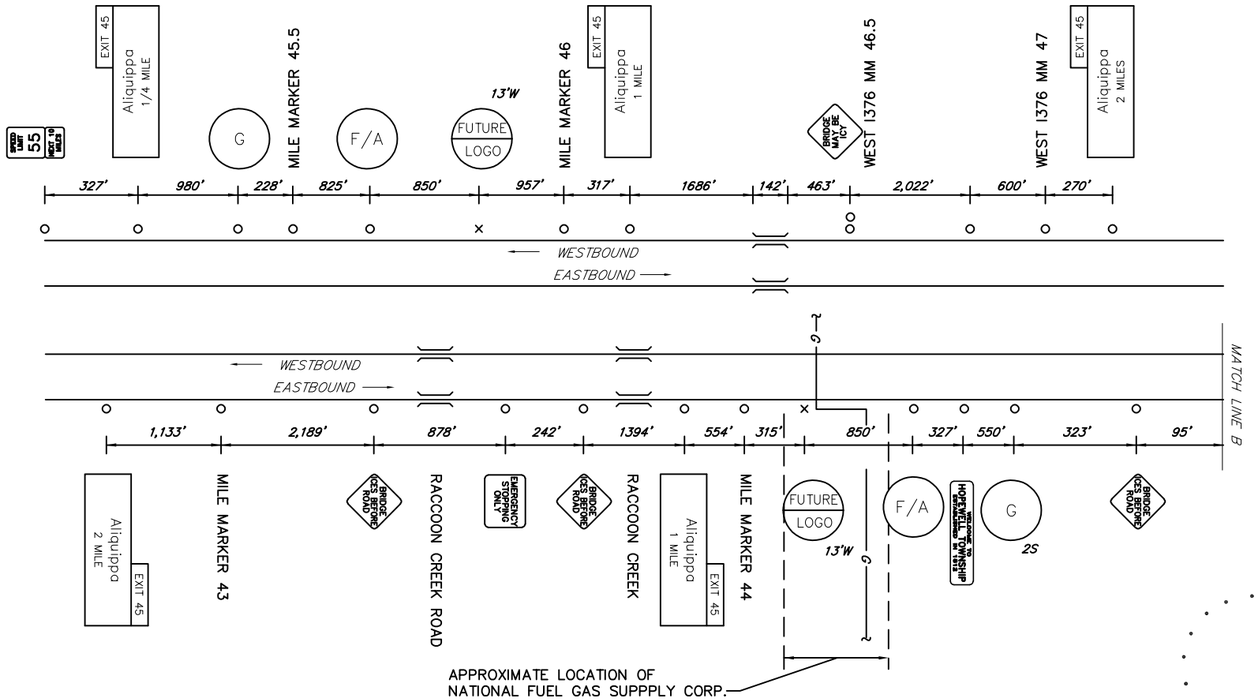

MAINLINE SCHEMATIC
NOT TO SCALE

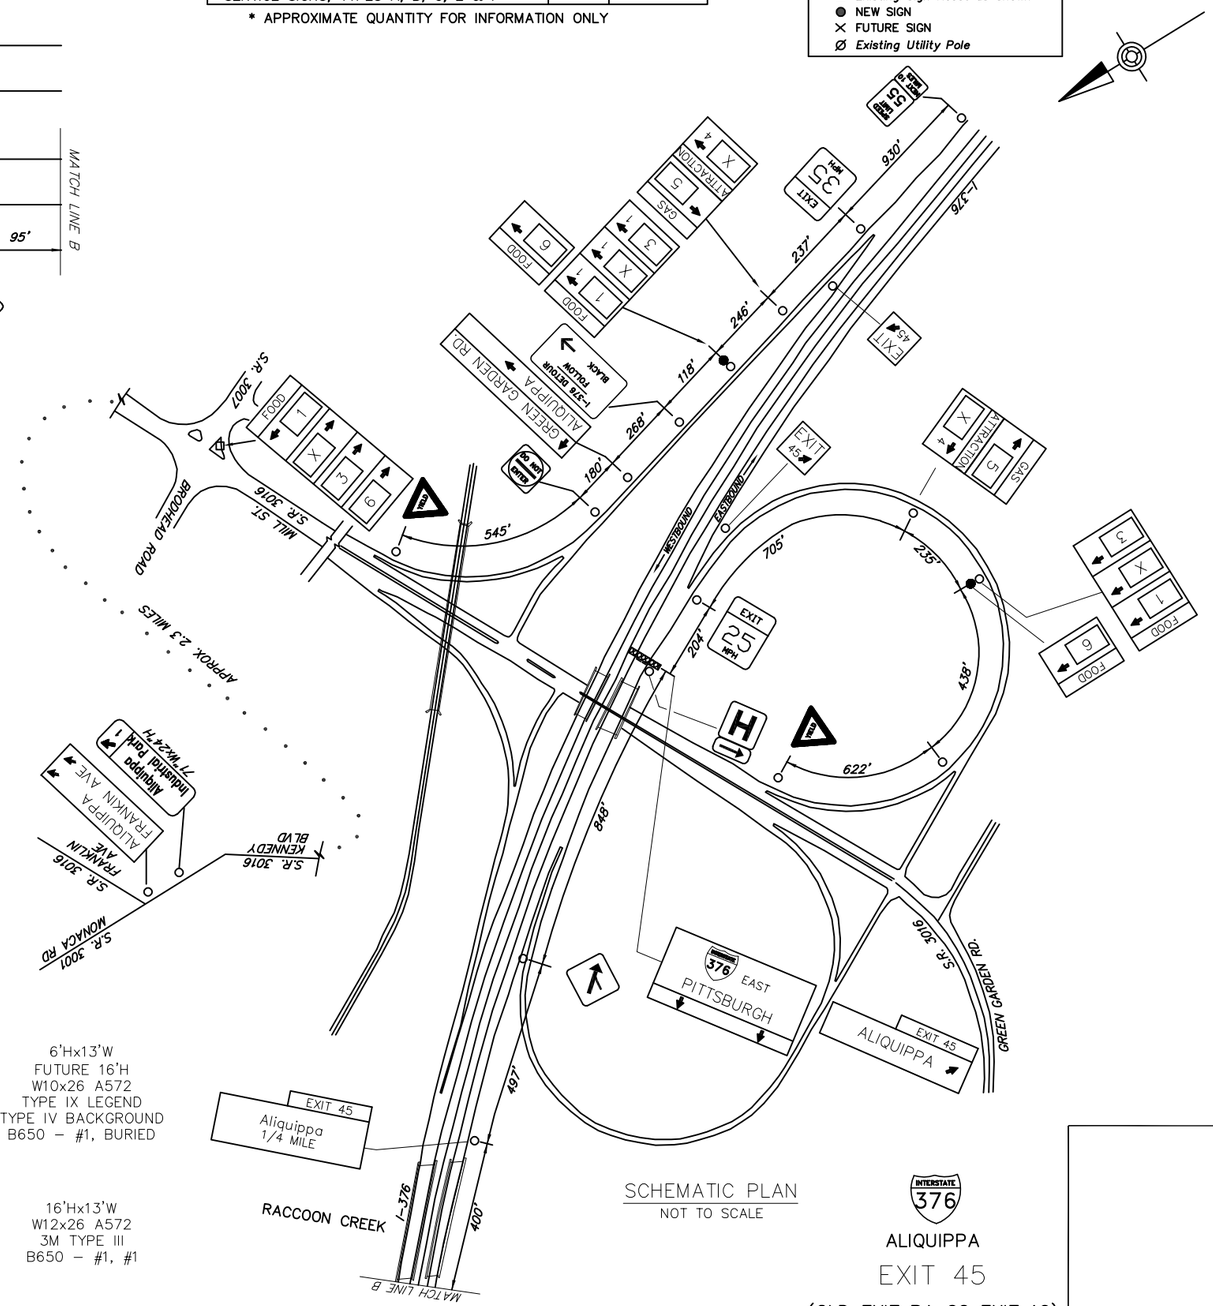

SCHEMATIC PLAN
NOT TO SCALE

INTERSTATE 376
ALIQUIPPA
EXIT 45
(OLD EXIT PA 60 EXIT 10)

LEGEND

2S – GUIDE RAIL

DISTRICT 11-0
PROVIDE 3 DAYS NOTICE PRIOR TO START OF WORK TO DISTRICT 11-0 DAN QUARCOO 412-429-4971.
SEE SPECIAL PROVISION 4901-0001.

EXIT 45 SPECIFIC INFORMATION PANEL			
LEGEND	DIRECTION	BUSINESS	LOGO NO.
GAS	EB/WB	GETGO	5
FOOD	EB/WB	WENDY'S	1
		ARBY'S	3
		DUNKIN DONUTS	6
ATTRACTION	EB/WB		

EB SIGNS

6'Hx13'W
FUTURE 16'H
W18x40 A572
TYPE IX LEGEND
TYPE IV BACKGROUND
B650 – #2, #2

GAS – EXIT 45: 5

16'Hx13'W
W12x26 A572
3M TYPE III
BURIED, B650 – #2

FOOD – EXIT 45: 1 X / 3 6
ATTRACTION–EXIT 45: X

WB SIGNS

GAS – EXIT 45: 5

6'Hx13'W
FUTURE 16'H
W10x26 A572
TYPE IX LEGEND
TYPE IV BACKGROUND
B650 – #1, BURIED

FOOD – EXIT 45: 1 X / 3 6
ATTRACTION–EXIT 45: X

16'Hx13'W
W12x26 A572
3M TYPE III
B650 – #1, #1

\\DAVOSD\CC\DATA\PROJECTS\2015\D0512\215076-60\HV\PSE\AS-BUILT DRAWINGS\PENNDOT DISTRICT 11\BEAVER - 04\11-XX SHTXX-I376_EXIT 45 PLAN
August 17, 2022 10:52 AM