DISTRICT	COUNTY	ROUTE	PROJECT	SHEET
12-0	WESTMORELAND	I-70	XXX-XX	X OF X
ROSTRAVER TOWNSHIP				
REVISIONS				

TABULATION OF QUANTITIES		
ITEM	UNIT	QUANTITY
POST MOUNTED SIGNS, TYPE A, LOGO	SQ.FT.	–
POST MOUNTED SIGNS, TYPE A, LOGO (MODIFIED)	SQ.FT.	–
POST MOUNTED SIGNS, TYPE C, LOGO	SQ.FT.	
BREAKAWAY SYSTEMS	EACH	–
* STEEL S OR W BEAM POSTS	LBS.	–
LOGO SIGN MOUNTING	EACH	–
LOGO SIGN MOUNTING, RESET	EACH	–
REMOVE POST MOUNTED SIGNS, TYPE A LOGO (MODIFIED)	EACH	–
REMOVE POST MOUNTED SIGNS, TYPE A, LOGO	EACH	

* APPROXIMATE QUANTITY FOR INFORMATION ONLY

SYMBOLS

- ○ *Existing Sign to Remain*
- △ *Existing Sign to be Removed*
- □ *Existing Sign Reset as Shown*
- ● NEW SIGN
- × FUTURE SIGN
- Ø *Existing Utility Pole*

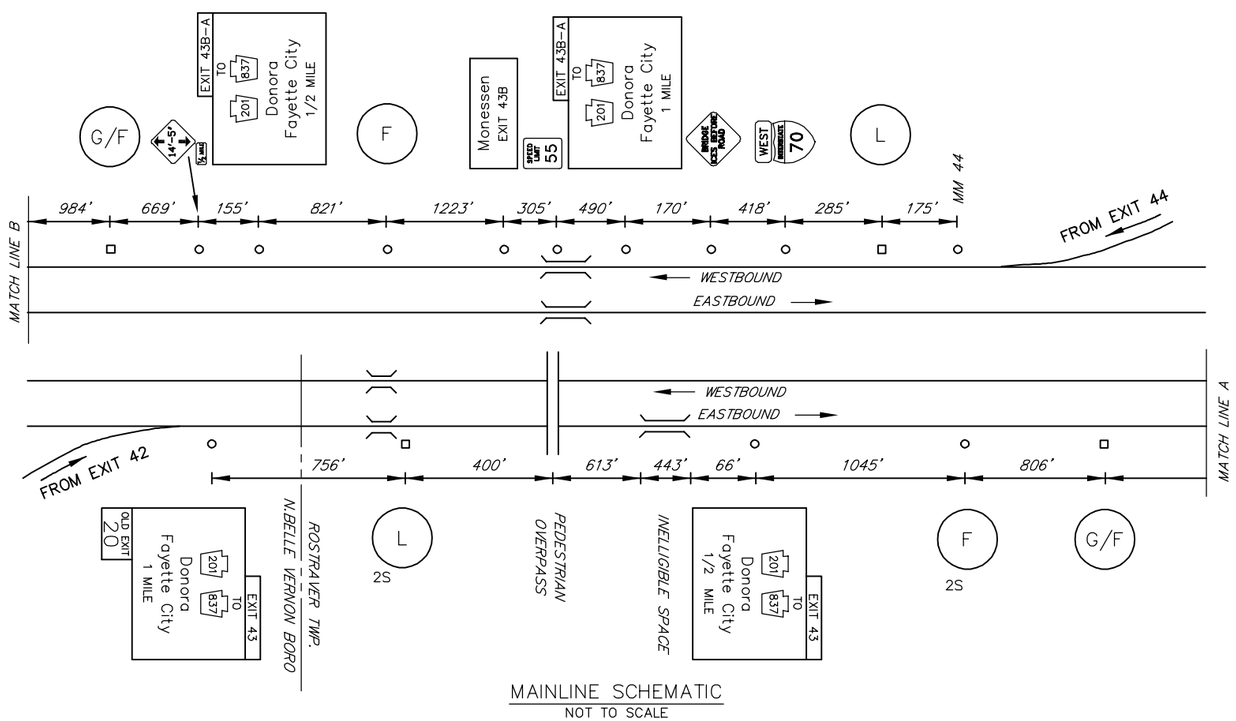

MAINLINE SCHEMATIC
NOT TO SCALE

LEGEND

2S – GUIDE RAIL

FREEWAY LANE CLOSURES & RESTRICTIONS ONLY PERMITTED BETWEEN 9:00 PM AND 6:00 AM MONDAY THRU FRIDAY. WORK ALONG FREEWAY PERMITTED BETWEEN 9:00 AM AND 2:30 PM, UNLESS OTHERWISE APPROVED BY ENGINEERING DISTRICT. DO NOT WORK DURING HOLIDAY PERIODS. IF APPLICABLE, REINSTALL GUIDERAIL AT END OF EACH DAY.

EXIT 43/43A SPECIFIC INFORMATION PANEL			
LEGEND	DIRECTION	BUSINESS	LOGO NO.
GAS	EB/WB		
FOOD	EB/WB	BURGER KING	1
		WENDY'S	4
		EAT'N PARK (24 HRS)	7
		SUBWAY	9
		HOSS'S FAMILY STEAK & SEA	10
		STARBUCKS COFFEE	6
LODGING	EB/WB		
		HOLIDAY INN EXPRESS & SUITES	11
		FAIRFIELD BY MARRIOTT	12

EB SIGNS WB SIGNS

12'Hx13'W
FUTURE 16'H
W10x26 A572
XX TYPE IV
SBM – 650

GAS – EXIT 43: X
FOOD – EXIT 43: 10
GAS – EXIT 43A: X
FOOD – EXIT 43A: 6 10

12'Hx13'W
FUTURE 16'H
W14x30 A572
XX TYPE IV
SBM – 650

14'Hx13'W
W12x26
3M TYPE III
B650 – #2, #1

FOOD – EXIT 43: 6 9 / X 4 / 7 1
FOOD – EXIT 43A: 1 X / 7 / 4 9

14'Hx13'W
FUTURE 16'H
W10x22
3M TYPE III
B650 – #1, #2

10'Hx13'W
14' TOP SECTION
W8x21
3M TYPE IX LEGEND
TYPE III BACKGROUND
B525 – #2, #2

LODGING – EXIT 43: X 11 / 12
LODGING – EXIT 43A: X 11 / 12

10'Hx13'W
FUTURE 15'H
W14x30
3M TYPE IX LEGEND
TYPE III BACKGROUND
B650 – #2, #1

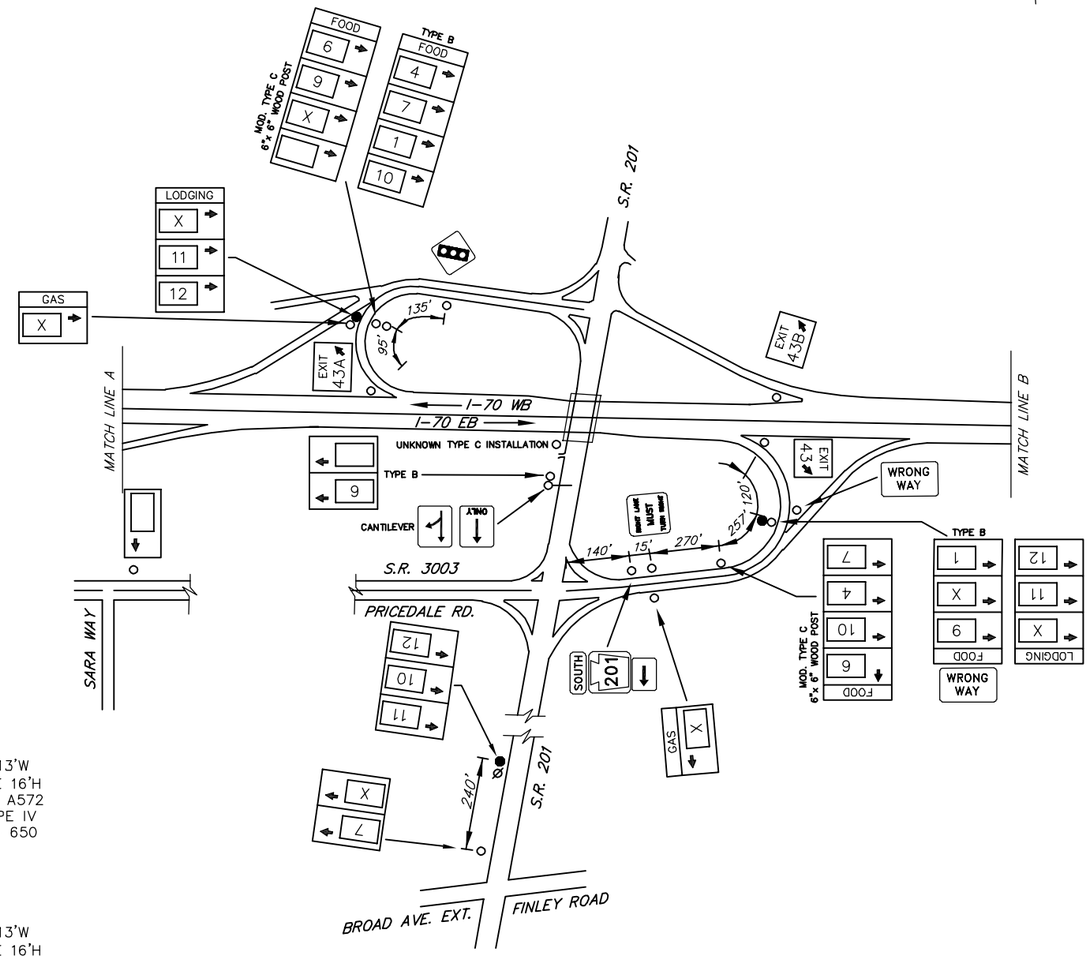

SCHEMATIC PLAN
NOT TO SCALE

INTERSTATE 70

FAYETTE CITY

EXIT 43/43A

\\DAVDDC\DATA\PROJECTS\2015\D3B5-215076-01\MVK\PSE\AS-BUILT DRAWINGS\PENNDOT DISTRICT 12\WESTMORELAND - 64\10-XX SHTXX-176_EXIT 43 PLAN
November/23/2022 10:14 AM