DISTRICT	COUNTY	ROUTE	PROJECT	SHEET
11-0	ALLEGHENY	I-79		
KENNEDY & ROBINSON TOWNSHIPS				
REVISIONS				

TABULATION OF QUANTITIES		
ITEM	UNIT	QUANTITY
POST MOUNTED SIGNS, TYPE A, LOGO	SQ.FT.	–
POST MOUNTED SIGNS, TYPE B, LOGO	SQ.FT.	–
POST MOUNTED SIGNS, TYPE C, LOGO	SQ.FT.	–
BREAKAWAY SYSTEMS	EACH	–
* STEEL S OR W BEAM POSTS	LBS.	–
LOGO SIGN MOUNTING	EACH	–

* APPROXIMATE QUANTITY FOR INFORMATION ONLY

SYMBOLS

- ○ *Existing Sign to Remain*
- △ *Existing Sign to be Removed*
- □ *Existing Sign Reset as Shown*
- ● NEW SIGN
- × FUTURE SIGN
- Ø *Existing Utility Pole*

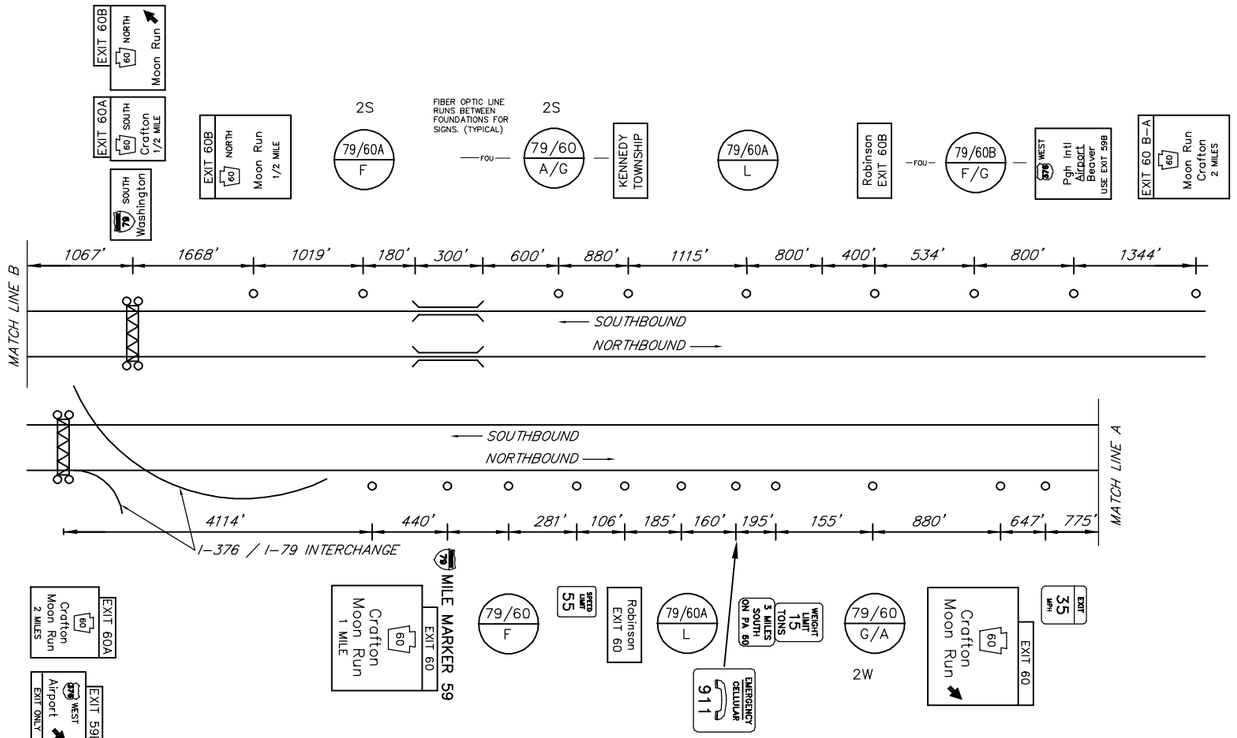

MAINLINE SCHEMATIC
NOT TO SCALE

WORK ONLY BETWEEN 9:00 AM AND 3:00 PM.
CONTACT DISTRICT 11-0
FOR ADDITIONAL TRAFFIC CONTROL REQUIREMENTS.

LEGEND

2S/2W – GUIDE RAIL

EXIT 60/60A/60B SPECIFIC INFORMATION PANEL			
LEGEND	DIRECTION	BUSINESS	LOGO NO.
GAS	NB/60A SB	GETGO	1
	60B SB	SHEETZ	11
FOOD	NB/60A SB	GETGO	2
		PRIMANTI BROS	3
	NB/60B SB	SHEETZ	10
LODGING	NB/60A SB	MOTEL 6	6
	NB/60B SB		
	NB		
ATTRACTION	NB/60B SB	THE MALL AT ROBINSON	7

NB SIGNS

12'Hx13'W FUTURE 16'H W14x30 3M TYPE III B650 – #1, #1

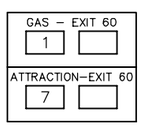

10'Hx19'W FUTURE 16'H W8x18 3M TYPE III B525 – #2, #2

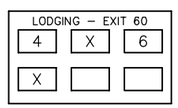

10'Hx13'W FUTURE 16'H W10x26 A572 3M TYPE III SBM – 650

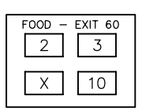

SB SIGNS

10'Hx13'W FUTURE 16'H W14x30 A572 3M TYPE III SBM – 650

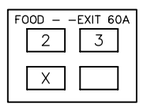

12'Hx13'W FUTURE 16'H W18x40 A572 3M TYPE III SBM – 650

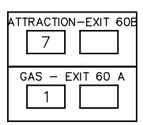

12'Hx19'W W12x26 3M TYPE III B650 – #2, #2

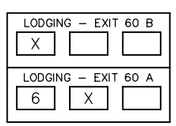

12'Hx19'W W14x30 A572 3M TYPE III SBM – 650

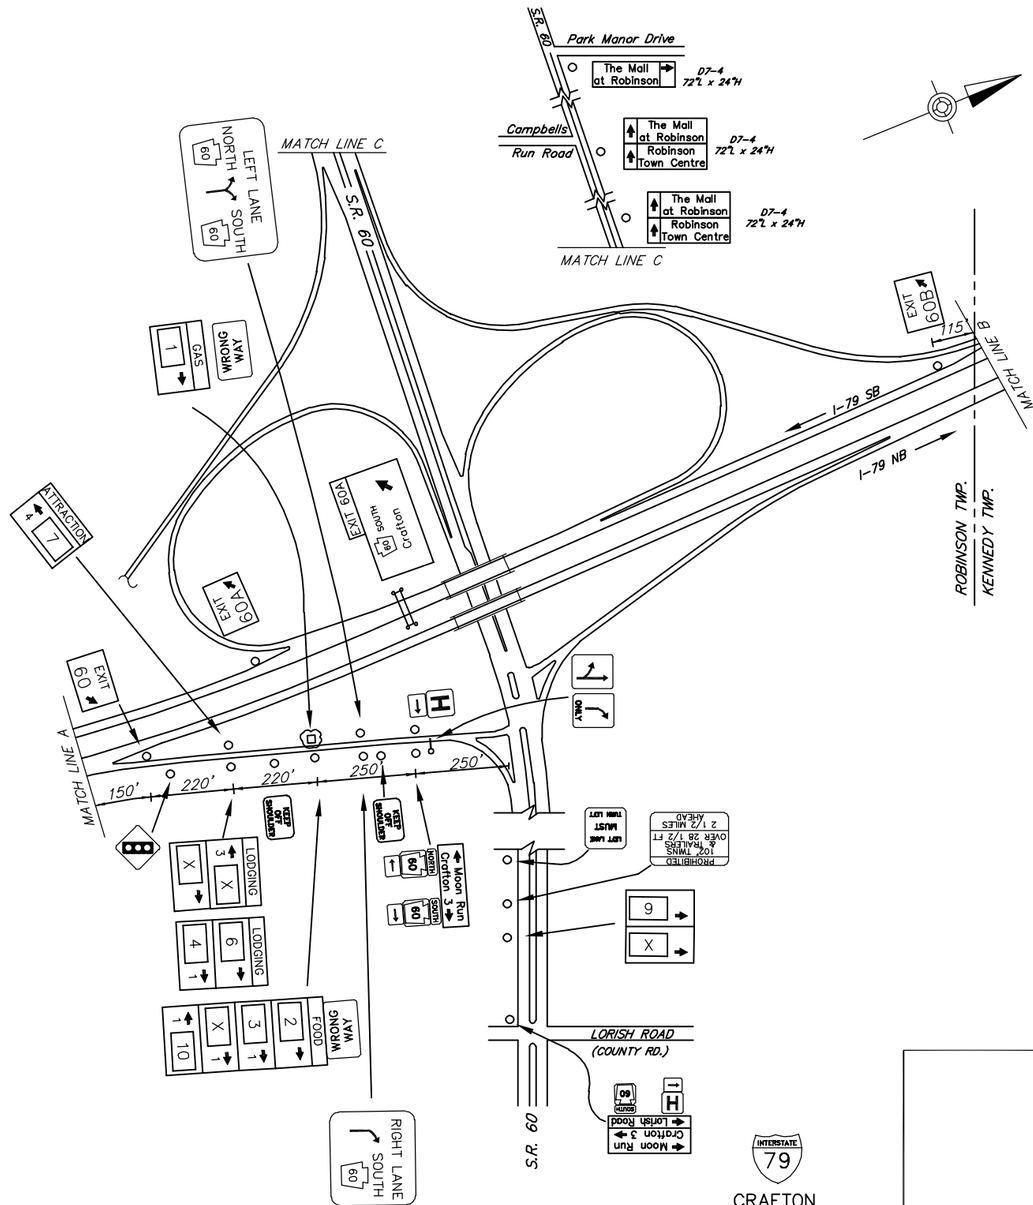

SCHEMATIC PLAN
NOT TO SCALE

\\SHARED2\CC\DATA\PROJECTS\2015\D0851\215976-01\WKV\PSE-AS-BUILT DRAWINGS\PENNDOT DISTRICT 11\ALLEGHENY - 02\10-XX SHTXX 179_EXIT 60 PLAN
November/23/2022 10:28 AM