DISTRICT	COUNTY	ROUTE	PROJECT	SHEET
5-0	SCHUYLKILL	I-81		
BUTLER, NEW CASTLE, RYAN & WEST MAHANOY TOWNSHIPS				
REVISIONS				

TABULATION OF QUANTITIES		
ITEM	UNIT	QUANTITY
POST MOUNTED SIGNS, TYPE A, LOGO	SQ.FT.	
POST MOUNTED SIGNS, TYPE A, LOGO (MODIFIED)	SQ.FT.	–
POST MOUNTED SIGNS, TYPE C, LOGO	SQ.FT.	
BREAKAWAY SYSTEMS	EACH	–
* STEEL S OR W BEAM POSTS	LBS.	–
LOGO SIGN MOUNTING	EACH	–
LOGO SIGN MOUNTING, RESET	EACH	–
REMOVAL OF POST MOUNTED MOTORIST SERVICE SIGNS, TYPES A & E	EACH	–
REMOVAL OF POST MOUNTED MOTORIST SERVICE SIGNS, TYPES B, C & F	L.S.	

* APPROXIMATE QUANTITY FOR INFORMATION ONLY

SYMBOLS

- ○ *Existing Sign to Remain*
- △ *Existing Sign to be Removed*
- □ *Existing Sign Reset as Shown*
- ◪ *Existing Sign Foundation*
- ● NEW SIGN
- × FUTURE SIGN
- Ø *Existing Utility Pole*

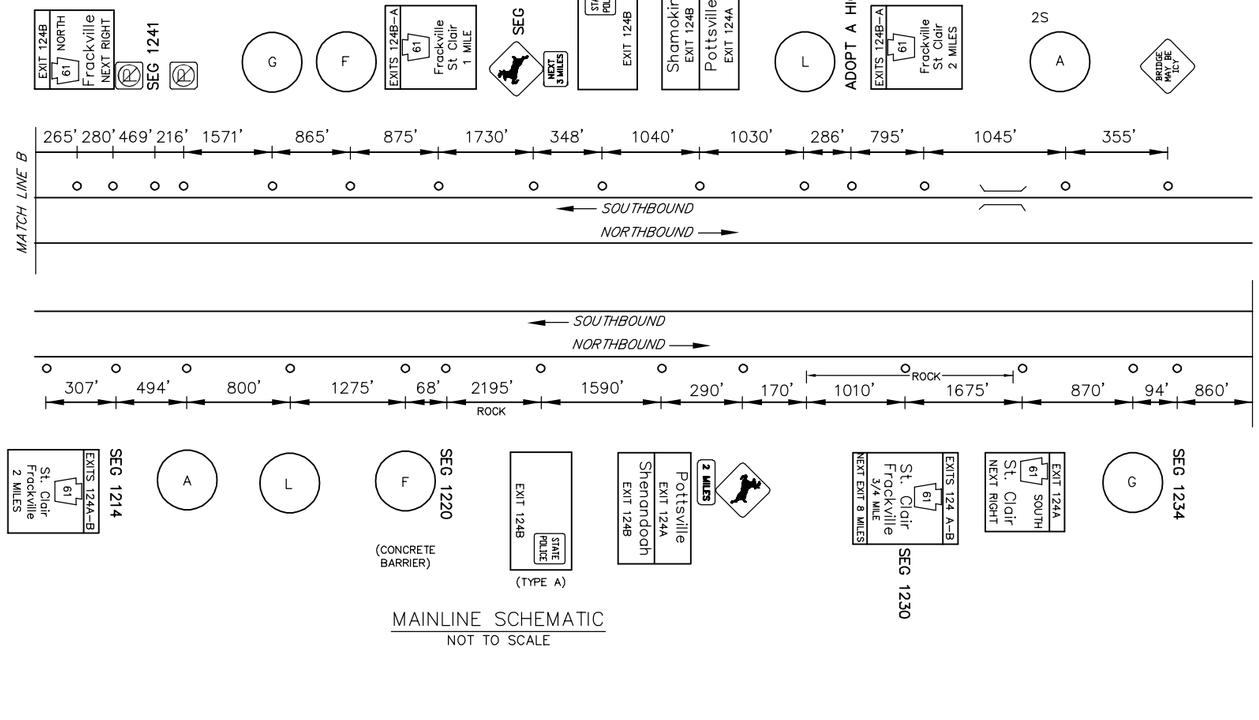

MAINLINE SCHEMATIC
NOT TO SCALE

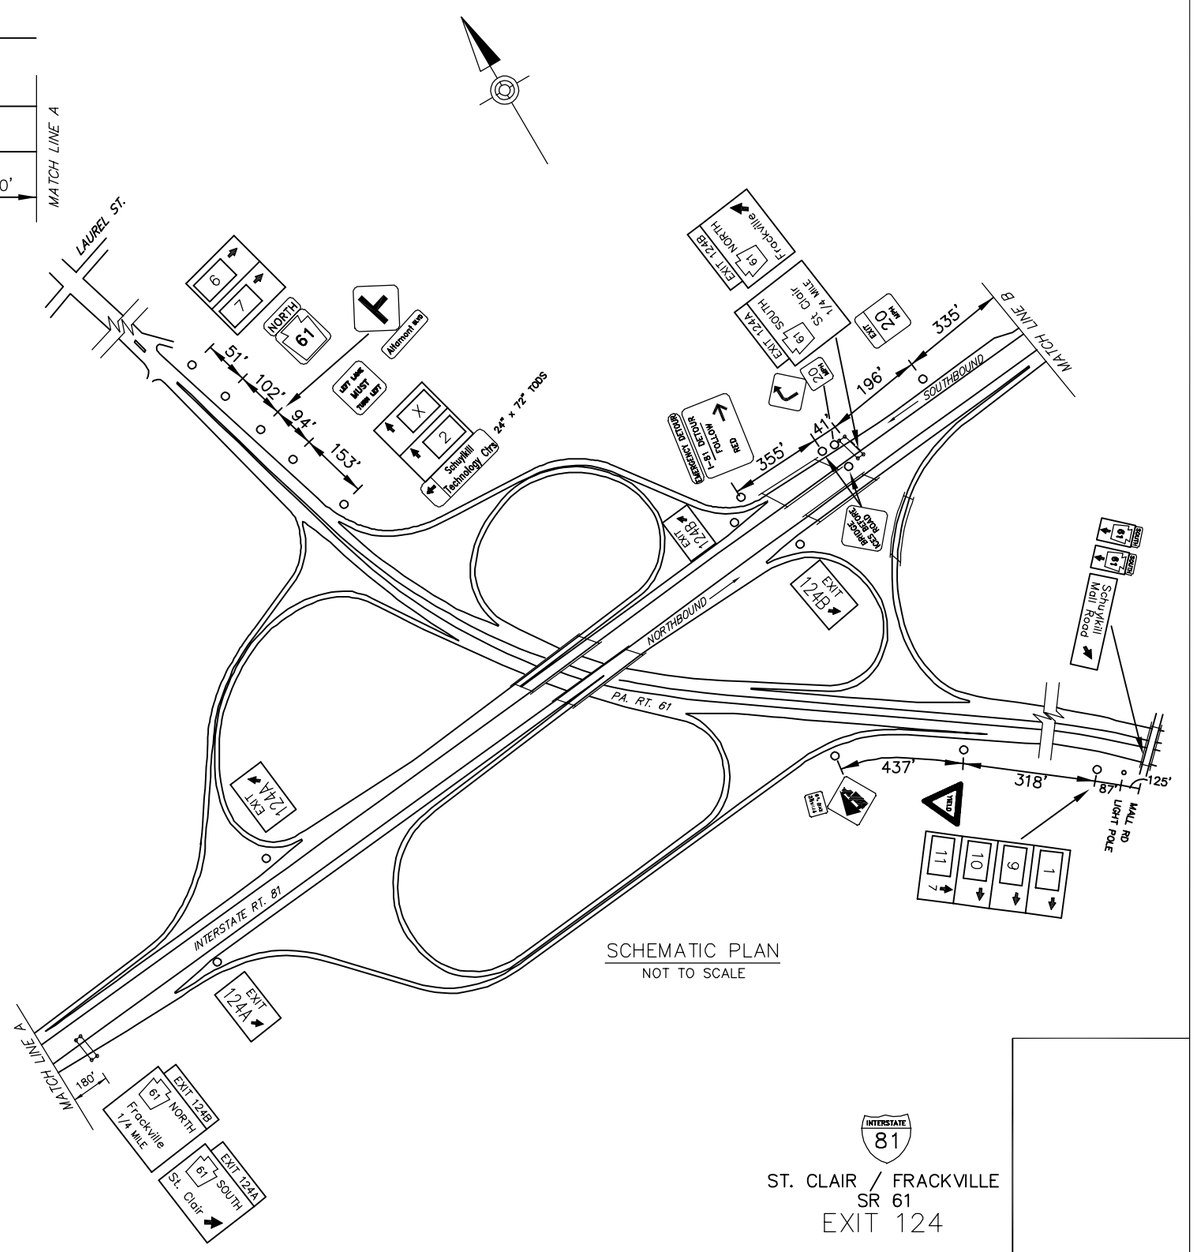

SCHEMATIC PLAN
NOT TO SCALE

LEGEND

2S – GUIDE RAIL

FREEWAY LANE CLOSURES & RESTRICTIONS ONLY PERMITTED BETWEEN 9:00 PM AND 6:00 AM MONDAY THRU FRIDAY.
WORK ALONG FREEWAY PERMITTED BETWEEN 9:00 AM AND 2:30 PM, UNLESS OTHERWISE APPROVED BY ENGINEERING DISTRICT.
DO NOT WORK DURING HOLIDAY PERIODS.
IF APPLICABLE, REINSTALL GUIDERAIL AT END OF EACH DAY.

EXIT 124 SPECIFIC INFORMATION PANEL			
LEGEND	DIRECTION	BUSINESS	LOGO NO.
GAS	124B NB/SB	SPEEDWAY	4
		EXXON (24 HRS/DIESEL)	6
FOOD	124A NB/SB	McDONALD'S	1
		CRACKER BARREL	9
	124B NB/SB	DUTCH KITCHEN	2
LODGING	124A NB/SB	HOLIDAY INN EXPRESS & SUITES	10
	124B NB/SB	ECONO LODGE	3
		MOTEL 6	7
ATTRACTION	124A NB/SB	YUENGLING BREWERY	11

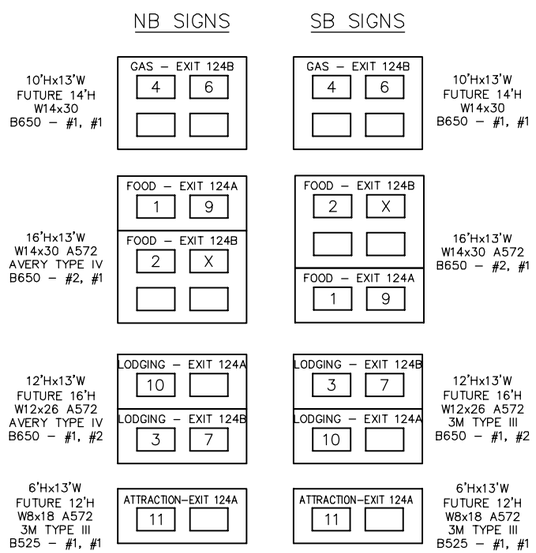

ST. CLAIR / FRACKVILLE
SR 61
EXIT 124

\\DAVOSD1CC\DATA\PROJECTS\2015\D85\215976-01\HW\PSE\AS-BUILT DRAWINGS\PENNDOT DISTRICT 05\SCHUYLKILL - 53\D-XX_SHTXX EBL_EXIT 124 PLAN
October/11/2022 9:46 AM