DISTRICT	COUNTY	ROUTE	PROJECT	SHEET
8-0	FRANKLIN	I-81		

BORO OF CHAMBERSBURG, GUILFORD & HAMILTON TWPS.

REVISIONS

TABULATION OF QUANTITIES		
ITEM	UNIT	QUANTITY
POST MOUNTED SIGNS, TYPE A, LOGO	SQ.FT.	–
POST MOUNTED SIGNS, TYPE A, LOGO (MODIFIED)	SQ.FT.	
POST MOUNTED SIGNS, TYPE C, LOGO	SQ.FT.	
BREAKAWAY SYSTEMS	EACH	–
* STEEL S OR W BEAM POSTS	LBS.	–
LOGO SIGN MOUNTING	EACH	–
LOGO SIGN MOUNTING, RESET	EACH	
REMOVAL OF POST MOUNTED MOTORIST SERVICE SIGNS, TYPES A & E	EACH	–
REMOVAL OF POST MOUNTED MOTORIST SERVICE SIGNS, TYPES B, C & F	L.S.	

* APPROXIMATE QUANTITY FOR INFORMATION ONLY

SYMBOLS

- ○ *Existing Sign to Remain*
- △ *Existing Sign to be Removed*
- □ *Existing Sign Reset as Shown*
- ● NEW SIGN
- × FUTURE SIGN
- Ø *Existing Utility Pole*

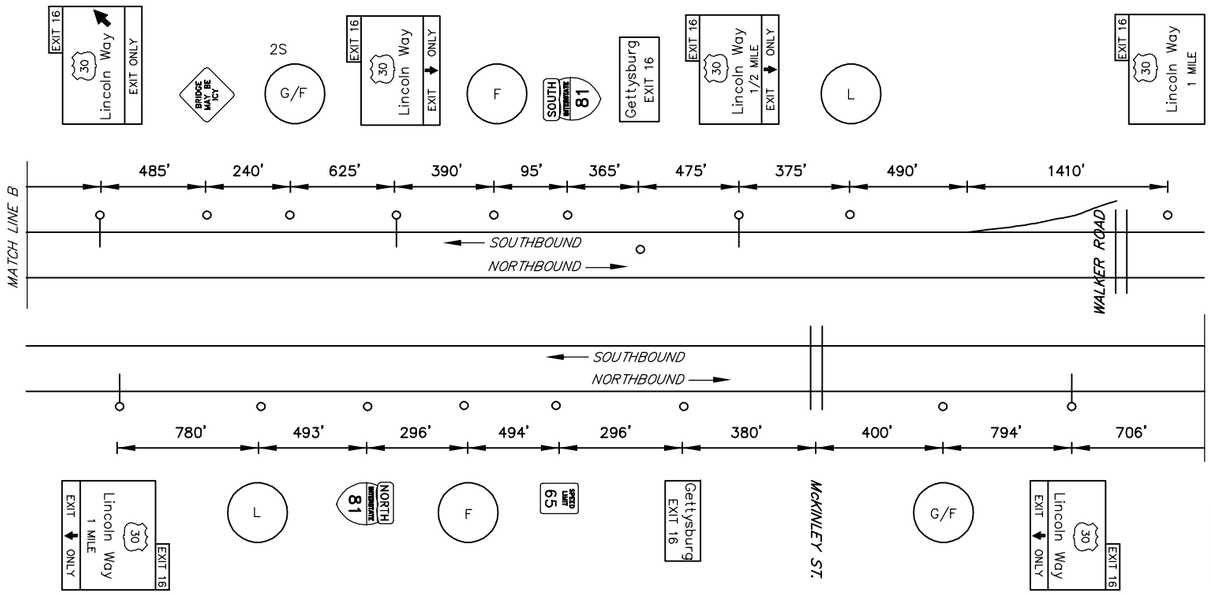

MAINLINE SCHEMATIC
NOT TO SCALE

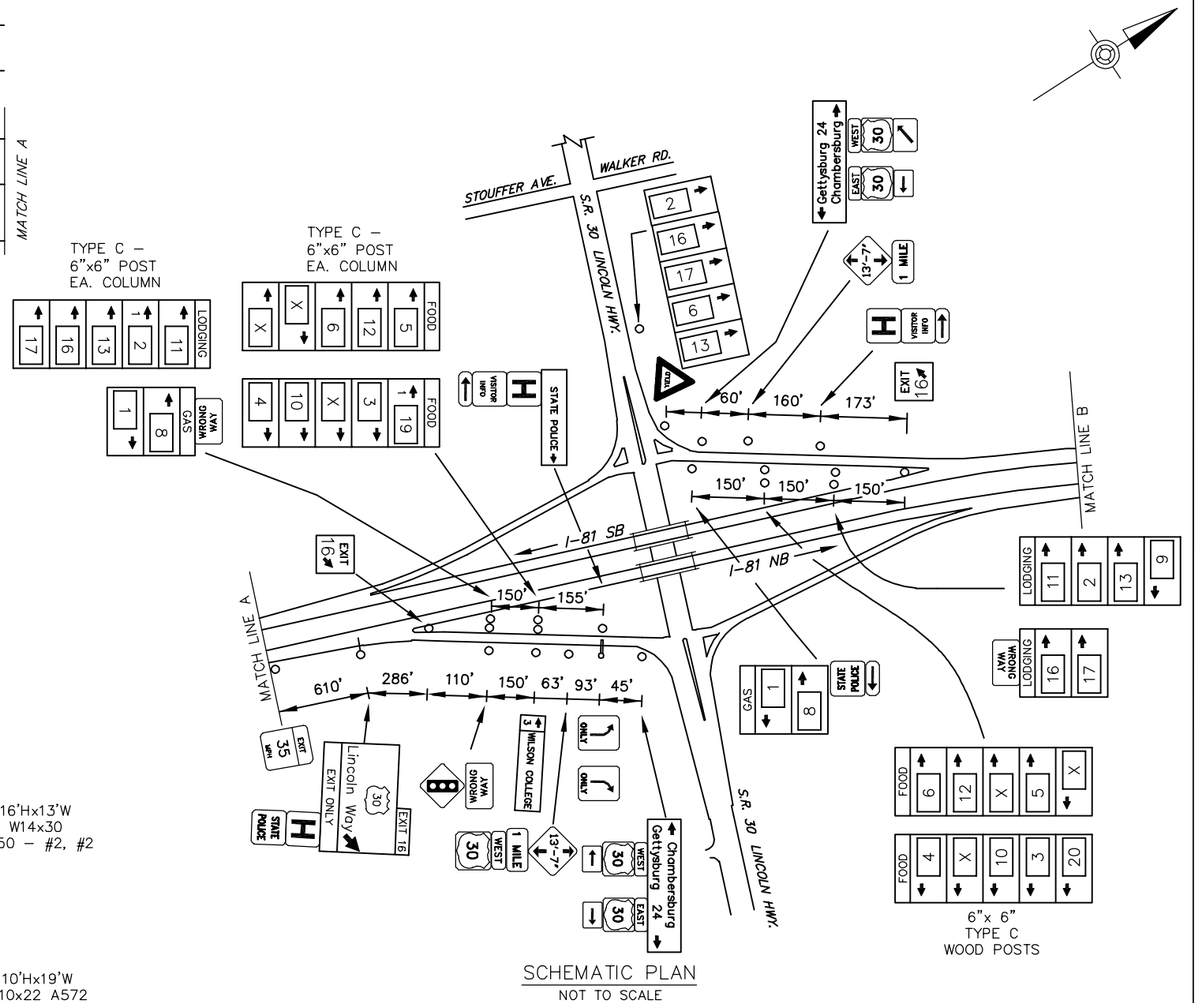

SCHEMATIC PLAN
NOT TO SCALE

LEGEND

2S – GUIDE RAIL.

DO NOT CLOSE OR RESTRICT TRAVEL LANES DURING RUSH HOUR. WORK ALONG FREEWAY PERMITTED BETWEEN 9:00 AM AND 2:30 PM, UNLESS OTHERWISE APPROVED BY ENGINEERING DISTRICT. DO NOT WORK DURING HOLIDAY. PERIODS IF APPICABLE, REINSTALL GUIDERAIL AT END OF EACH DAY.

EXIT 16 SPECIFIC INFORMATION PANEL			
LEGEND	DIRECTION	BUSINESS	LOGO NO.
GAS	NB/SB	SHEETZ #76	1
		SPEEDWAY (DIESEL)	8
FOOD	NB/SB	POPEYE'S CHICKEN & BISCUITS	3
		HOSS'S FAMILY STEAK & SEA	4
		McDONALD'S	6
		BURGER KING	5
		PERKINS RESTAURANT & BAKERY	10
	NB	HARDEE'S	19
	SB	SHEETZ	20
LODGING	NB/SB	CBURG INN & SUITES	11
		TRU HILTON	13
		BEST WESTERN	2
		DAYS INN	9
		LaQUINTA INNS & SUITES	16
		CANDLEWOOD SUITES	17

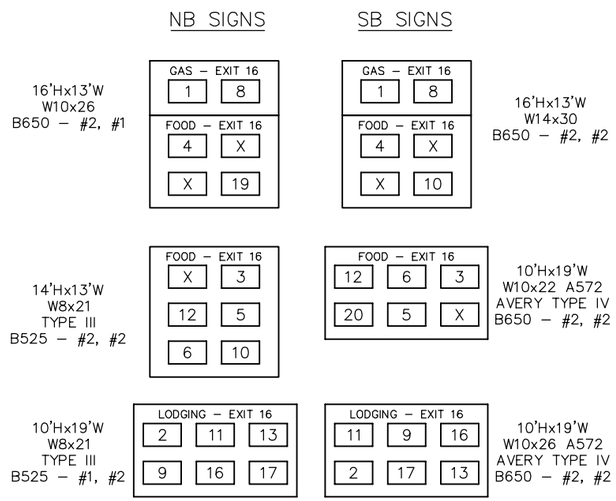

INTERSTATE 81

LINCOLN WAY (S.R. 30)
CHAMBERSBURG GETTYSBURG
EXIT 16

\\DAVDOD2\DATA\PROJECTS\2015\D8\D8152976-01\WK\PSE\AS-BUILT DRAWINGS\PENNDOT DISTRICT 08\FRANKLIN - I81\0-XX SHTXX-I81_EXIT 16 PLAN
October/4/2022 4:11 PM