| DISTRICT | COUNTY | ROUTE | PROJECT | SHEET |
|---|---|---|---|---|
| 8-0 | DAUPHIN | I-81 | XXX-XX | X OF X |
| LOWER PAXTON & WEST HANOVER TOWNSHIPS | | | | |
| REVISIONS | | | | |

| TABULATION OF QUANTITIES | | |
|---|---|---|
| ITEM | UNIT | QUANTITY |
| POST MOUNTED SIGNS, TYPE A, LOGO | SQ.FT. | – |
| POST MOUNTED SIGNS, TYPE B, LOGO | SQ.FT. | – |
| POST MOUNTED SIGNS, TYPE C, LOGO | SQ.FT. | – |
| BREAKAWAY SYSTEMS | EACH | – |
| * STEEL S OR W BEAM POSTS | LBS. | – |
| LOGO SIGN MOUNTING | EACH | – |
| EXTRUDED PANEL REPLACEMENT | SQ.FT. | |
| REMOVAL OF POST MOUNTED MOTORIST SERVICE SIGNS, TYPES B, C & F | L.S. | |

* APPROXIMATE QUANTITY FOR INFORMATION ONLY

**SYMBOLS**

- ○ *Existing Sign to Remain*
- △ *Existing Sign to be Removed*
- □ *Existing Sign Reset as Shown*
- ● NEW SIGN
- × FUTURE SIGN
- Ø *Existing Utility Pole*

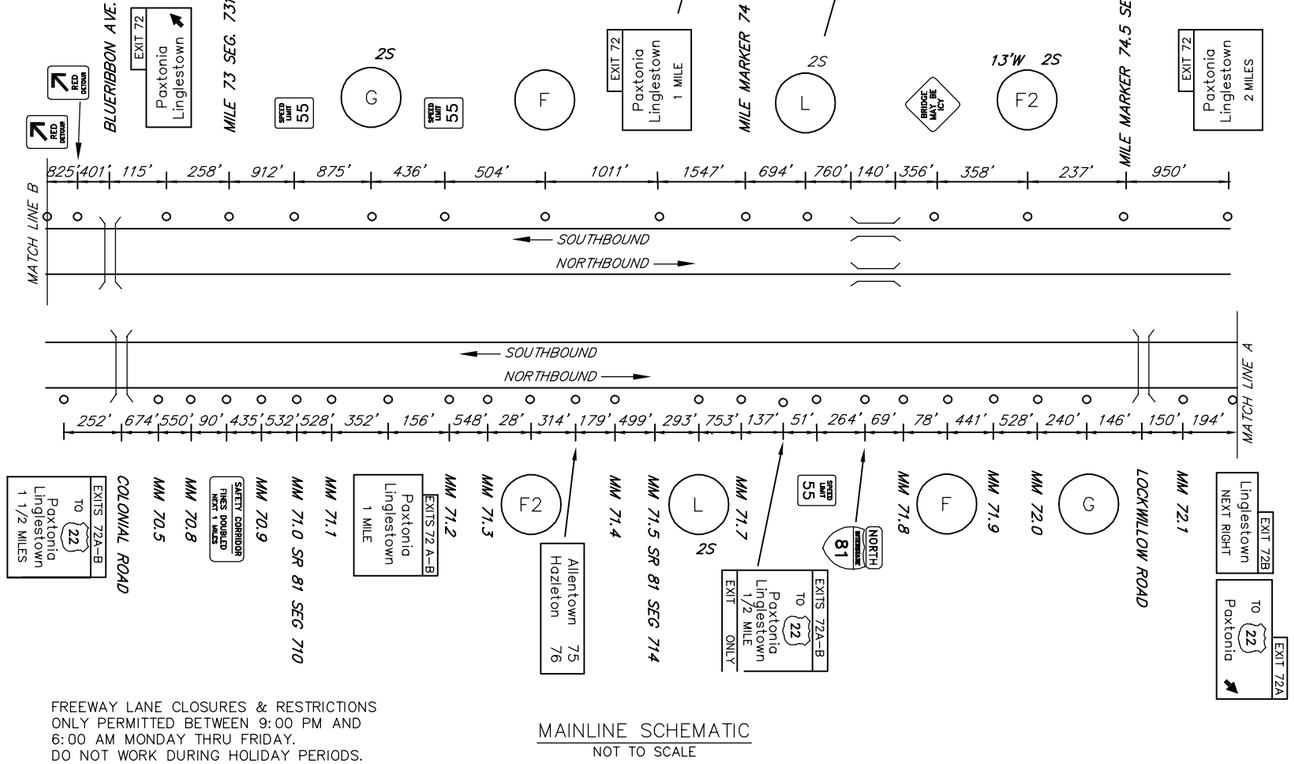


MAINLINE SCHEMATIC
NOT TO SCALE

FREEWAY LANE CLOSURES & RESTRICTIONS
ONLY PERMITTED BETWEEN 9:00 PM AND
6:00 AM MONDAY THRU FRIDAY.
DO NOT WORK DURING HOLIDAY PERIODS.

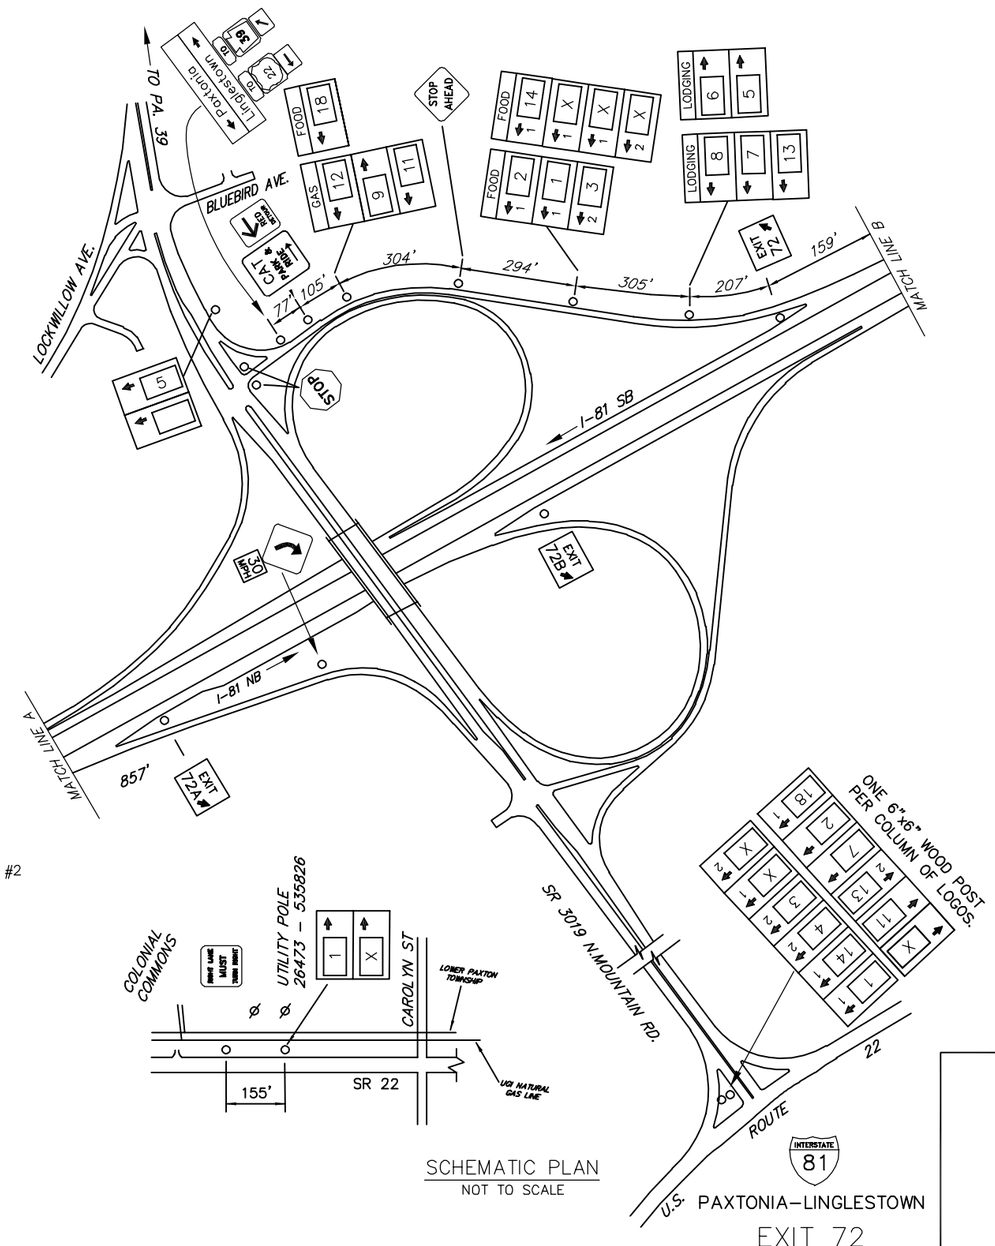


SCHEMATIC PLAN
NOT TO SCALE

| EXIT 72 SPECIFIC INFORMATION PANEL | | | |
|---|---|---|---|
| LEGEND | DIRECTION | BUSINESS | LOGO NO. |
| GAS | 72A NB/SB | SUNOCO (24 HRS/DIESEL) | 12 |
| | | SHEETZ (DIESEL) | 11 |
| | | | |
| | 72B NB/SB | TURKEY HILL | 9 |
| | | | |
| | | | |
| FOOD | 72A NB/SB | McDONALD'S | 2 |
| | | ARBY'S | 4 |
| | | RED ROBIN | 14 |
| | | WENDY'S | 3 |
| | | STARBUCKS | 1 |
| | | | |
| | | | |
| | | MISSION BBQ | 18 |
| | | | |
| | | | |
| LODGING | 72A NB/SB | BAYMONT INN & SUITES BY WYNDHAM | 7 |
| | | QUALITY INN | 8 |
| | | SLEEP INN & SUITES | 13 |
| | | | |
| | 72B NB/SB | RAMADA | 5 |
| | | CANDLEWOOD SUITES | 6 |

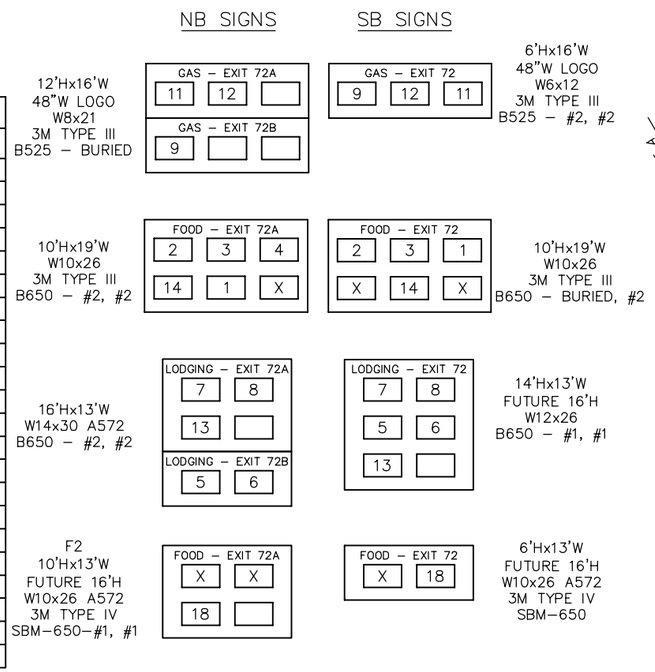


\\DAMOOS.OC\DATA\PROJECTS\2015\08150\215078-01\VHVPW\CAD\AS-BUILT DRAWINGS\PENNDOT DISTRICT 08\DAUPHIN - 22\SHTXX-I81_EXIT 72 PLAN
December/7/2022 11:29 AM