DISTRICT	COUNTY	ROUTE	PROJECT	SHEET
8-0	LEBANON	I-81		
UNION TOWNSHIP				
REVISIONS				

TABULATION OF QUANTITIES		
ITEM	UNIT	QUANTITY
POST MOUNTED SIGNS, TYPE A, LOGO	SQ.FT.	–
POST MOUNTED SIGNS, TYPE A, LOGO (MODIFIED)	SQ.FT.	–
POST MOUNTED SIGNS, TYPE C, LOGO	SQ.FT.	
BREAKAWAY SYSTEMS	EACH	–
* STEEL S OR W BEAM POSTS	LBS.	–
LOGO SIGN MOUNTING	EACH	–
LOGO SIGN MOUNTING, RESET	EACH	–
REMOVE POST MOUNTED SIGNS, TYPE A, LOGO (MODIFIED)	EACH	–
REMOVAL OF POST MOUNTED MOTORIST SERVICE SIGNS, TYPES B, C & F	L.S.	

* APPROXIMATE QUANTITY FOR INFORMATION ONLY

SYMBOLS

- ○ *Existing Sign to Remain*
- △ *Existing Sign to be Removed*
- □ *Existing Sign Reset as Shown*
- ◪ *Existing Sign Foundation*
- ● NEW SIGN
- × FUTURE SIGN
- Ø *Existing Utility Pole*

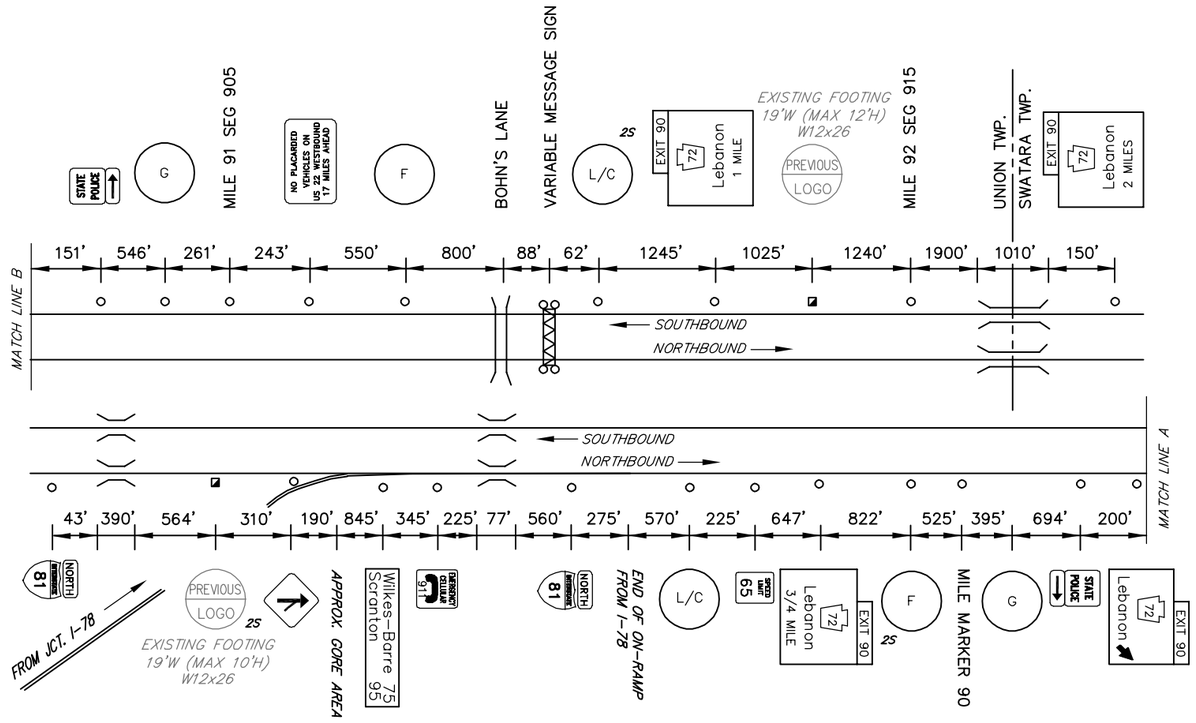

MAINLINE SCHEMATIC
NOT TO SCALE

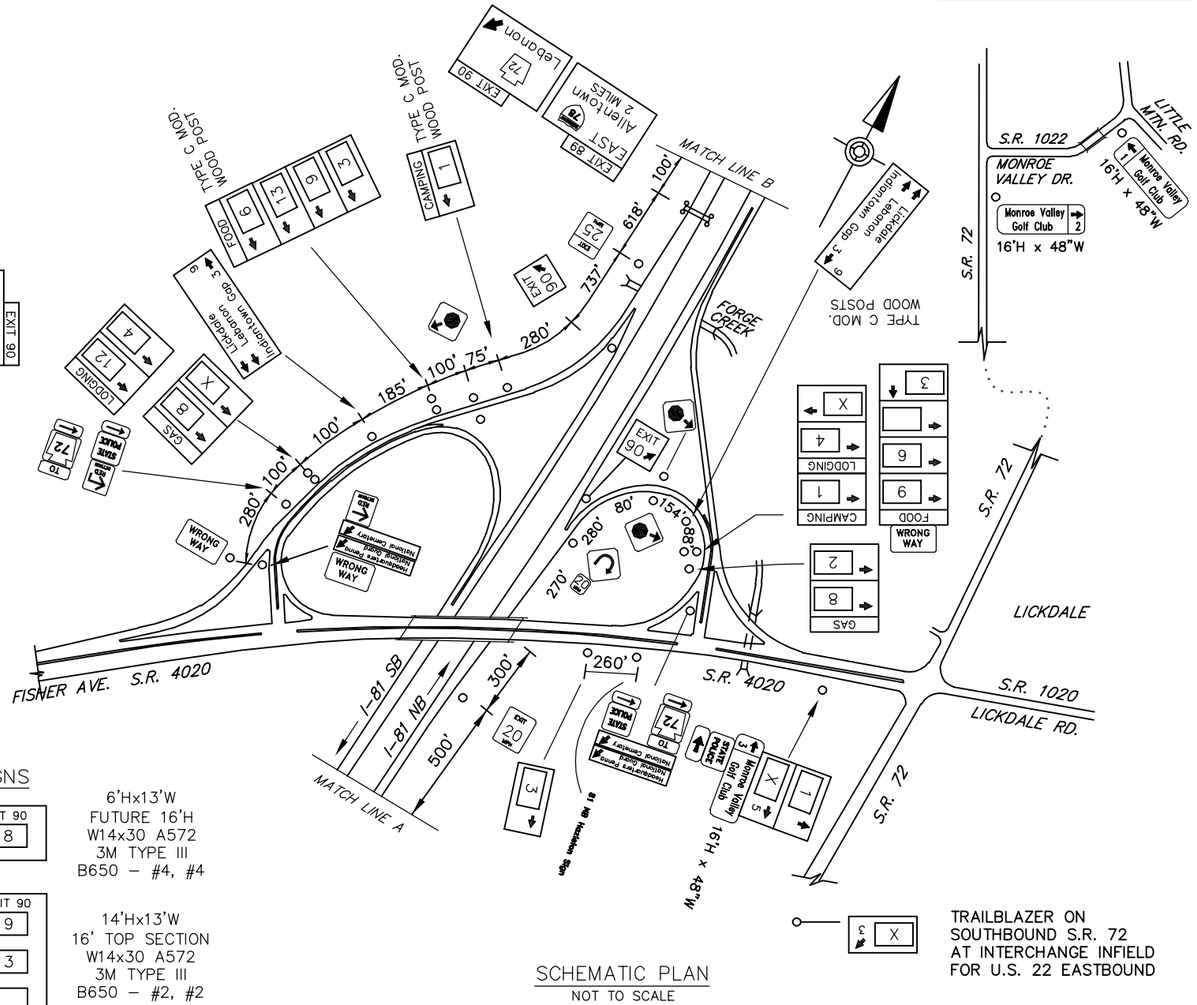

SCHEMATIC PLAN
NOT TO SCALE

TRAILBLAZER ON SOUTHBOUND S.R. 72 AT INTERCHANGE INFIELD FOR U.S. 22 EASTBOUND

LEGEND

2S – GUIDE RAIL

FREEWAY LANE CLOSURES & RESTRICTIONS ONLY PERMITTED BETWEEN 9:00 PM AND 6:00 AM MONDAY THRU FRIDAY. WORK ALONG FREEWAY PERMITTED BETWEEN 9:00 AM AND 2:30 PM, UNLESS OTHERWISE APPROVED BY ENGINEERING DISTRICT. DO NOT WORK DURING HOLIDAY PERIODS. IF APPLICABLE, REINSTALL GUIDERAIL AT END OF EACH DAY.

EXIT 90 SPECIFIC INFORMATION PANEL			
LEGEND	DIRECTION	BUSINESS	LOGO NO.
GAS	NB/SB		
		EXXON	8
		LOVE'S TRAVEL STOP	5
FOOD	NB/SB	SUBWAY	9
		BURGER KING	13
		WENDY'S	6
		CHESTER'S	3
LODGING	NB/SB	HOLIDAY INN EXPRESS	4
		FAIRFIELD INN & SUITES	12
CAMPING	NB/SB	KOA	1

NB SIGNS

6'Hx13'W FUTURE 18'H W14x30 3M TYPE III B650 – #2, #2

GAS – EXIT 90	
5	8

14'Hx13'W 16' TOP SECTION FUTURE 16'H W14x30 A572 3M TYPE III B650 – #2, #2

FOOD – EXIT 90	
6	9
13	3

16'Hx13'W W14x30 A572 3M TYPE III B650 – #2, #2

LODGING – EXIT 90	
4	X
12	
CAMPING – EXIT 90	
1	X

SB SIGNS

GAS – EXIT 90	
5	8

6'Hx13'W FUTURE 16'H W14x30 A572 3M TYPE III B650 – #4, #4

FOOD – EXIT 90	
6	9
13	3

14'Hx13'W 16' TOP SECTION W14x30 A572 3M TYPE III B650 – #2, #2

LODGING – EXIT 90	
4	X
12	
CAMPING – EXIT 90	
1	X

16'Hx13'W FUTURE 18'H W14x30 A572 3M TYPE III B650 – #2, #2

INTERSTATE 81
LEBANON
EXIT 90

\\DAVDOT\DATAPROJECTS\2015JOBS\85976-01\HWYPSE\AS-BUILT DRAWINGS\PENNDOT DISTRICT 08\LEBANON - 38-10-XX SHTXX-I81_EXIT 90 PLAN
November/22/2022 10:05 AM