DISTRICT	COUNTY	ROUTE	PROJECT	SHEET
8-0	YORK	I-83		

SPRING GARDEN AND SPRINGETTSBURY TOWNSHIP
REVISIONS

TABULATION OF QUANTITIES		
ITEM	UNIT	QUANTITY
POST MOUNTED SIGNS, TYPE A, LOGO	SQ.FT.	–
POST MOUNTED SIGNS, TYPE B, LOGO	SQ.FT.	–
POST MOUNTED SIGNS, TYPE C, LOGO	SQ.FT.	–
BREAKAWAY SYSTEMS	EACH	–
* STEEL S OR W BEAM POSTS	LBS.	–
LOGO SIGN MOUNTING	EACH	–

* APPROXIMATE QUANTITY FOR INFORMATION ONLY

SYMBOLS

- ○ *Existing Sign to Remain*
- △ *Existing Sign to be Removed*
- □ *Existing Sign Reset as Shown*
- ○ NEW SIGN
- × FUTURE SIGN
- Ø *Existing Utility Pole*

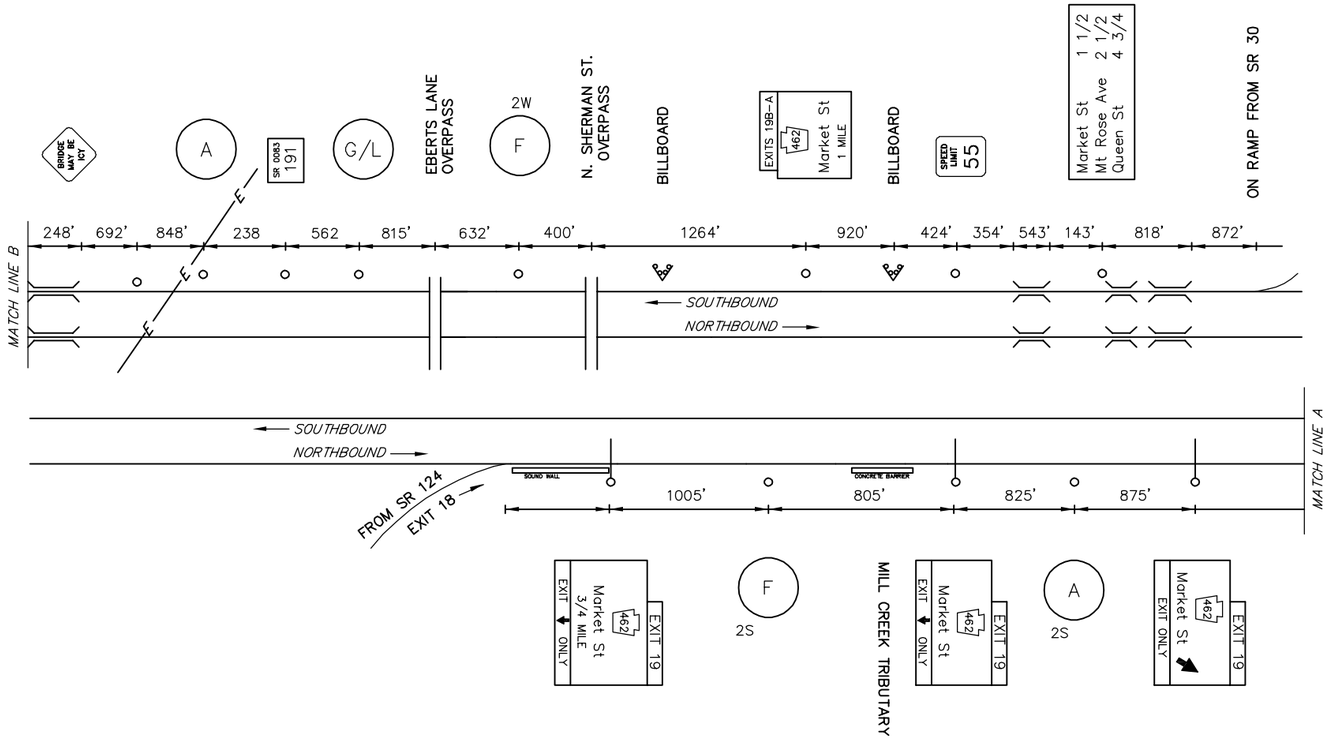

MAINLINE SCHEMATIC
NOT TO SCALE

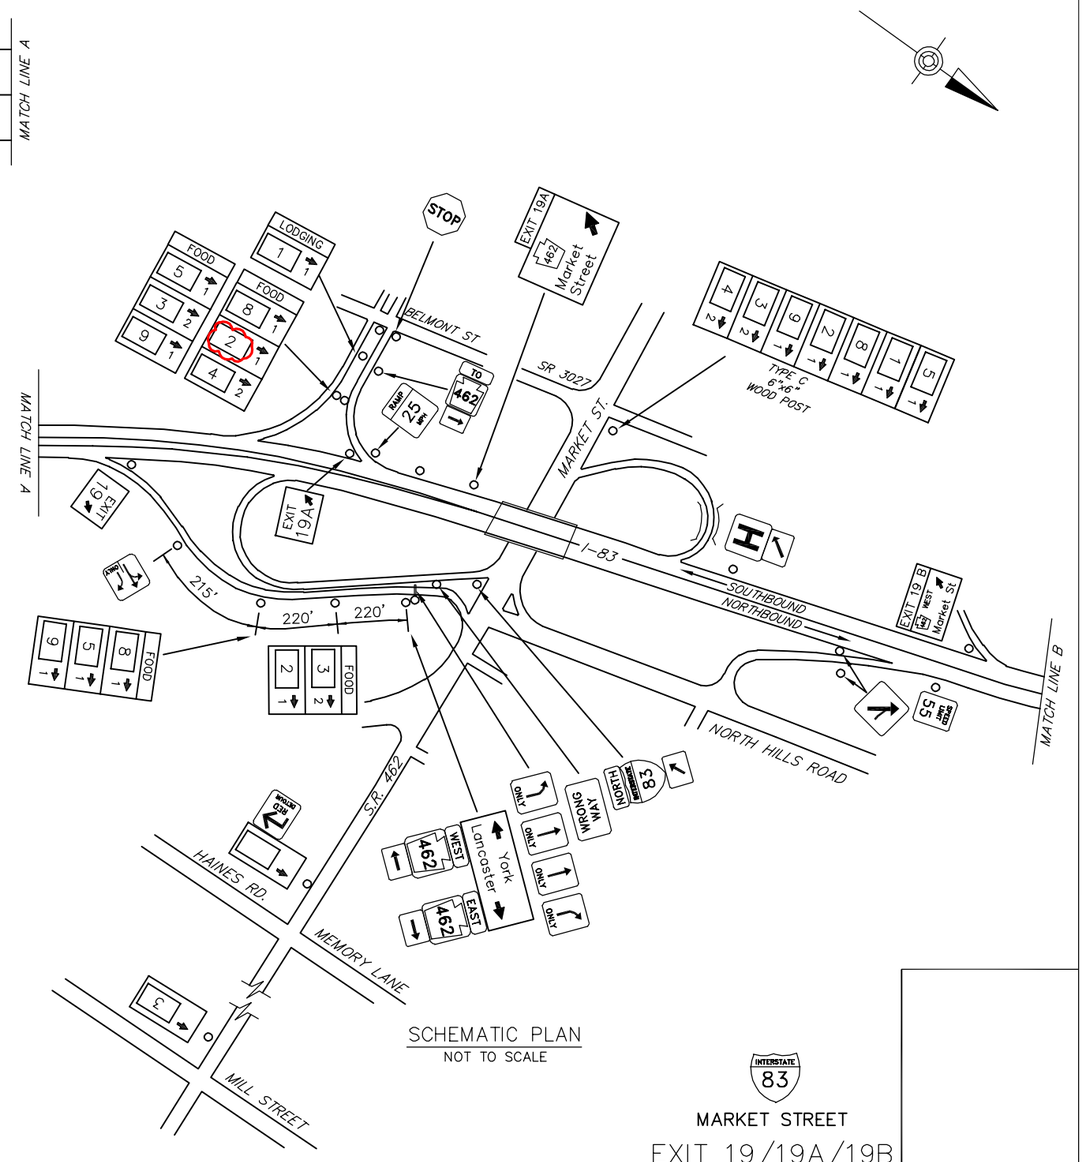

SCHEMATIC PLAN
NOT TO SCALE

LEGEND

2S/2W – GUIDE RAIL

FREEWAY LANE CLOSURES & RESTRICTIONS ONLY PERMITTED BETWEEN 9:00 PM AND 6:00 AM MONDAY THRU FRIDAY.
DO NOT WORK DURING HOLIDAY PERIODS.

EXIT 19/19A SPECIFIC INFORMATION PANEL			
LEGEND	DIRECTION	BUSINESS	LOGO NO.
GAS	SB		
FOOD	NB/SB	FUDDRUCKER'S	9
		CHICK-FIL-A (CLOSED SUNDAY)	3
		DUNKIN' DONUTS	5
		WENDY'S	8
		STARBUCKS	2
	SB	APPLEBEE'S	4
LODGING	SB	QUALITY INN & SUITES	1
ATTRACTION	NB		

NB SIGNS

6'Hx13'W
FUTURE 16'H
W14x30 A572
3M TYPE III
SBM-B650

ATTRACTION-EXIT 19
X

14'Hx13'W
FUTURE 16'H
W12x26 A572
B650 – #2, #1

FOOD-EXIT 19
5 8
9 3
2

SB SIGNS

ATTRACTION-EXIT 19B

6'Hx13'W
FUTURE 16'H
W18x40 A572
3M TYPE III
B650 – #4, #4

GAS – EXIT 19A
LODGING – EXIT 19A
1

12'Hx13'W
FUTURE 14'H
W14x30 A572
3M TYPE III
B650 – #2, #2

FOOD-EXIT 19A
9 4
3 2
5 8

14'Hx13'W
W14x30 A572
3M TYPE III
B650 – #2, BURIED

INTERSTATE 83

MARKET STREET
EXIT 19/19A/19B

D:\2015_JOBS\215076-01\HW\PSE\AS-BUILT DRAWINGS\PENNDOT DISTRICT 08\YORK - 66\10-XX SHTOX-183_EXIT 19A PLAN
February/9/2023 10:52 AM