DISTRICT	COUNTY	ROUTE	PROJECT	SHEET
4-0	PIKE	I-84		
PA: WEST FALL TOWNSHIP & MATAMORAS BOROUGH				
NY: ORANGE CO., TOWN OF DEER PARK				
REVISIONS				

TABULATION OF QUANTITIES		
ITEM	UNIT	QUANTITY
EXTRUDED PANEL REPLACEMENT	SQ.FT.	
POST MOUNTED SIGNS, TYPE B, LOGO	SQ.FT.	
POST MOUNTED SIGNS, TYPE C, LOGO	SQ.FT.	
BREAKAWAY SYSTEMS	EACH	
* STEEL S OR W BEAM POSTS	LBS.	
LOGO SIGN MOUNTING	EACH	
REMOVAL OF POST MOUNTED MOTORIST SERVICE SIGNS, TYPES A & E	EACH	
REMOVAL OF POST MOUNTED MOTORIST SERVICE SIGNS, TYPES B, C & F	L.S.	

SYMBOLS

- ○ *Existing Sign to Remain*
- △ *Existing Sign to be Removed*
- □ *Existing Sign Reset as Shown*
- ● NEW SIGN
- × FUTURE SIGN
- Ø *Existing Utility Pole*

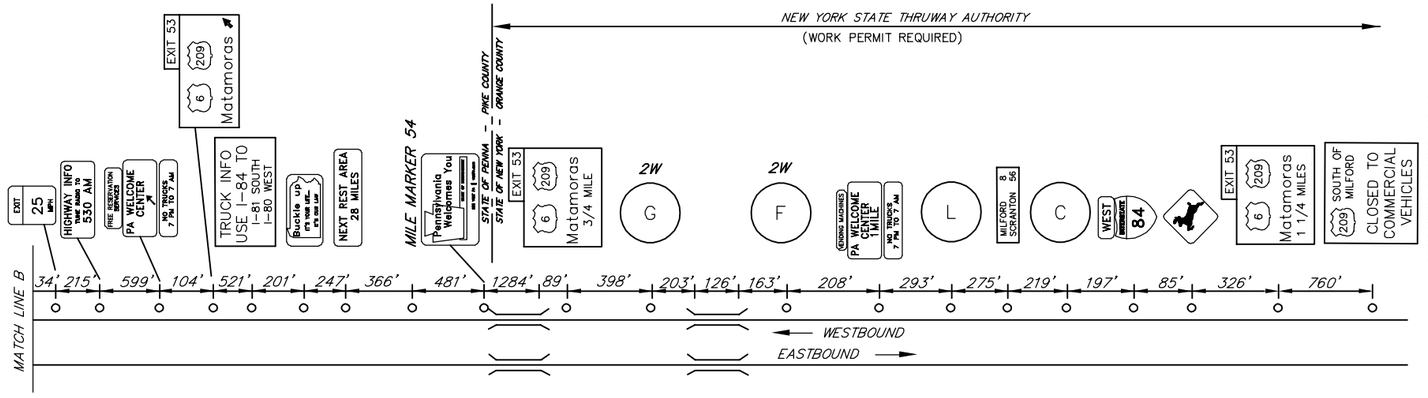

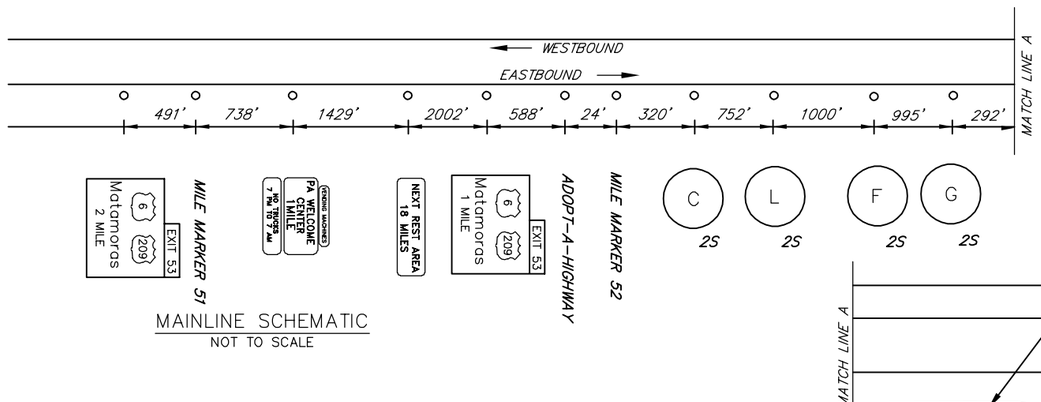

MAINLINE SCHEMATIC
NOT TO SCALE

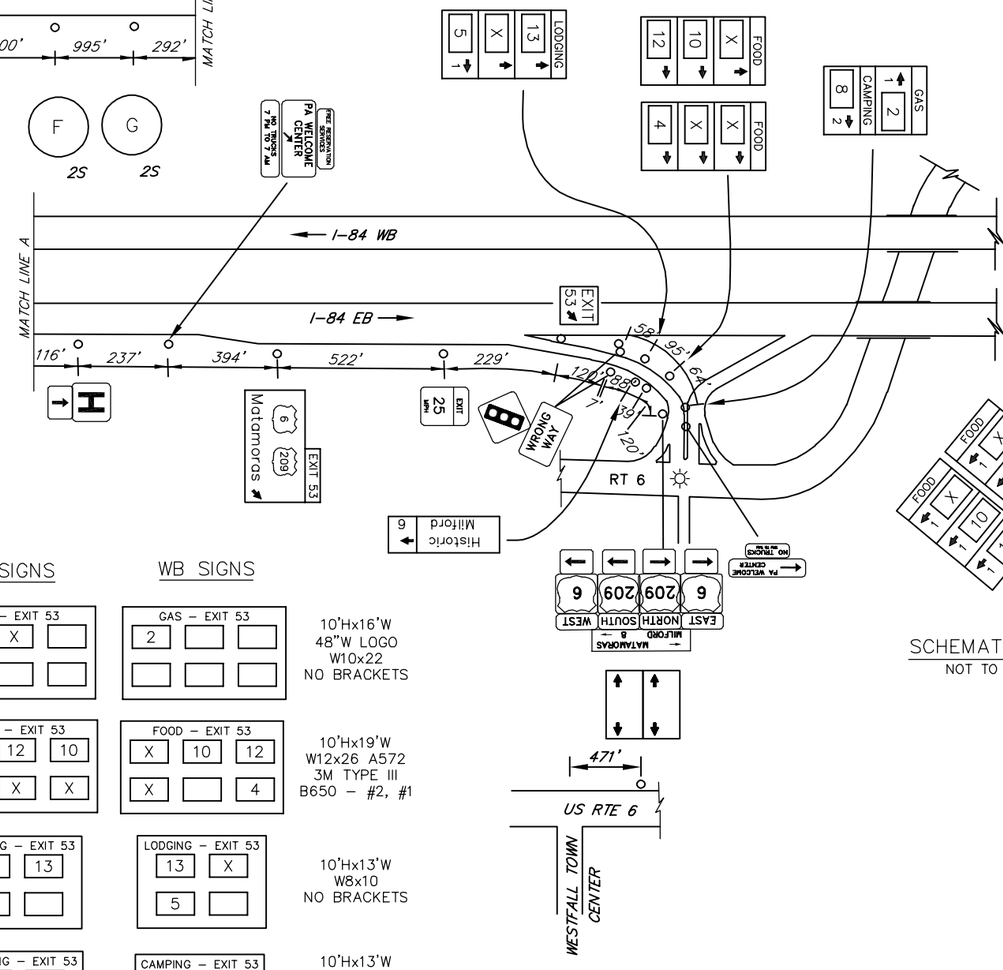

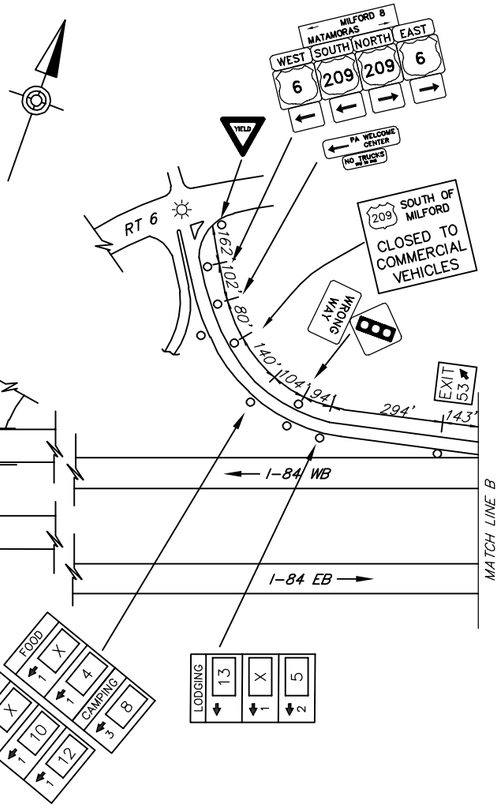

SCHEMATIC PLAN
NOT TO SCALE

LEGEND

2S/2W – GUIDE RAIL

EXIT 53 SPECIFIC INFORMATION PANEL			
LEGEND	DIRECTION	BUSINESS	LOGO NO.
GAS	EB/WB	SHELL	2
FOOD	EB/WB		
		McDONALD'S	4
		WENDY'S	10
		PERKIN'S FAMILY RESTAURANT	12
LODGING	EB/WB	SCOTTISH INNS	5
		HAMPTON INN	13
CAMPING	EB/WB	RIVER BEACH CAMPSITES	8

EB SIGNS

WB SIGNS

10'Hx16'W 48"W LOGO W10x26 B650 – #1, #1 SPLIT BASE RETROFIT

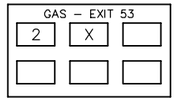

10'Hx16'W 48"W LOGO W10x22 NO BRACKETS

10'Hx19'W W10x22 A572 3M TYPE III B650 –#2, #1

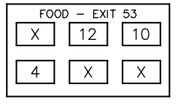

10'Hx19'W W12x26 A572 3M TYPE III B650 – #2, #1

10'Hx13'W FUTURE 14'H W10x26 B650 – #2, #1 SPLIT BASE RETROFIT

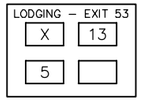

10'Hx13'W W8x10 NO BRACKETS

10'Hx13'W FUTURE 12'H W8x21 B525 – #1, #1

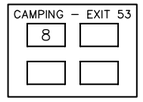

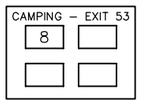

10'Hx13'W W8x10 NO BRACKETS FLAT SHEET ALUM. BACKPANEL WITH STIFFENERS

INTERSTATE 84

RT 6/RT 209/MATAMORAS

EXIT 53

\\DAVOSD2\CS\DATA\PROJECTS\8015\JOBS\215976-01\HV\PSE\AS-BUILT DRAWINGS\PENNDOT DISTRICT 4\PIKE - SIGN-XX SHTXX-I84_EXIT 53 PLAN
December/7/2022 11:42 AM