DISTRICT	COUNTY	ROUTE	PROJECT	SHEET
6-0	BUCKS	I-95		
BRISTOL TOWNSHIP				
REVISIONS				

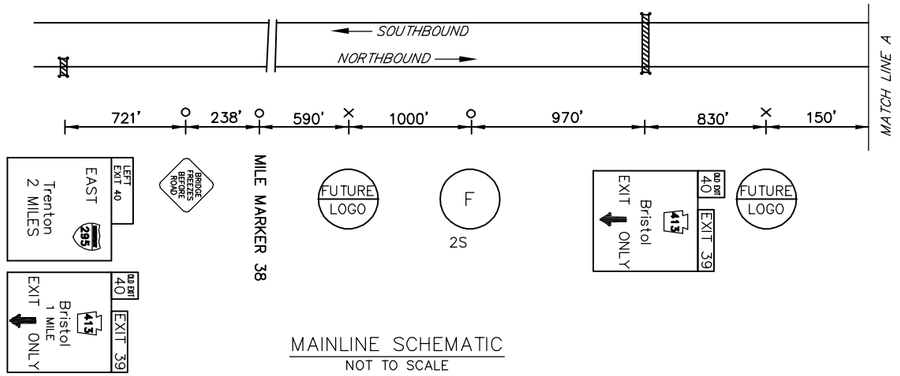

MAINLINE SCHEMATIC
NOT TO SCALE

TABULATION OF QUANTITIES		
ITEM	UNIT	QUANTITY
POST MOUNTED SIGNS, TYPE A, LOGO	SQ.FT.	
POST MOUNTED SIGNS, TYPE B, LOGO	SQ.FT.	
POST MOUNTED SIGNS, TYPE C, LOGO	SQ.FT.	
BREAKAWAY SYSTEMS	EACH	
* STEEL S OR W BEAM POSTS	LBS.	
LOGO SIGN MOUNTING	EACH	
POST MOUNTED SIGNS, TYPE B TODS	SQ.FT.	
EXTRUDED PANEL REPLACEMENT	SQ.FT.	
REMOVAL OF POST MOUNTED MOTORIST SERVICE SIGNS, TYPES B, C & F	L.S.	

* APPROXIMATE QUANTITY FOR INFORMATION ONLY

SYMBOLS

- ○ *Existing Sign to Remain*
- △ *Existing Sign to be Removed*
- □ *Existing Sign Reset as Shown*
- ● NEW SIGN
- × FUTURE SIGN
- Ø *Existing Utility Pole*

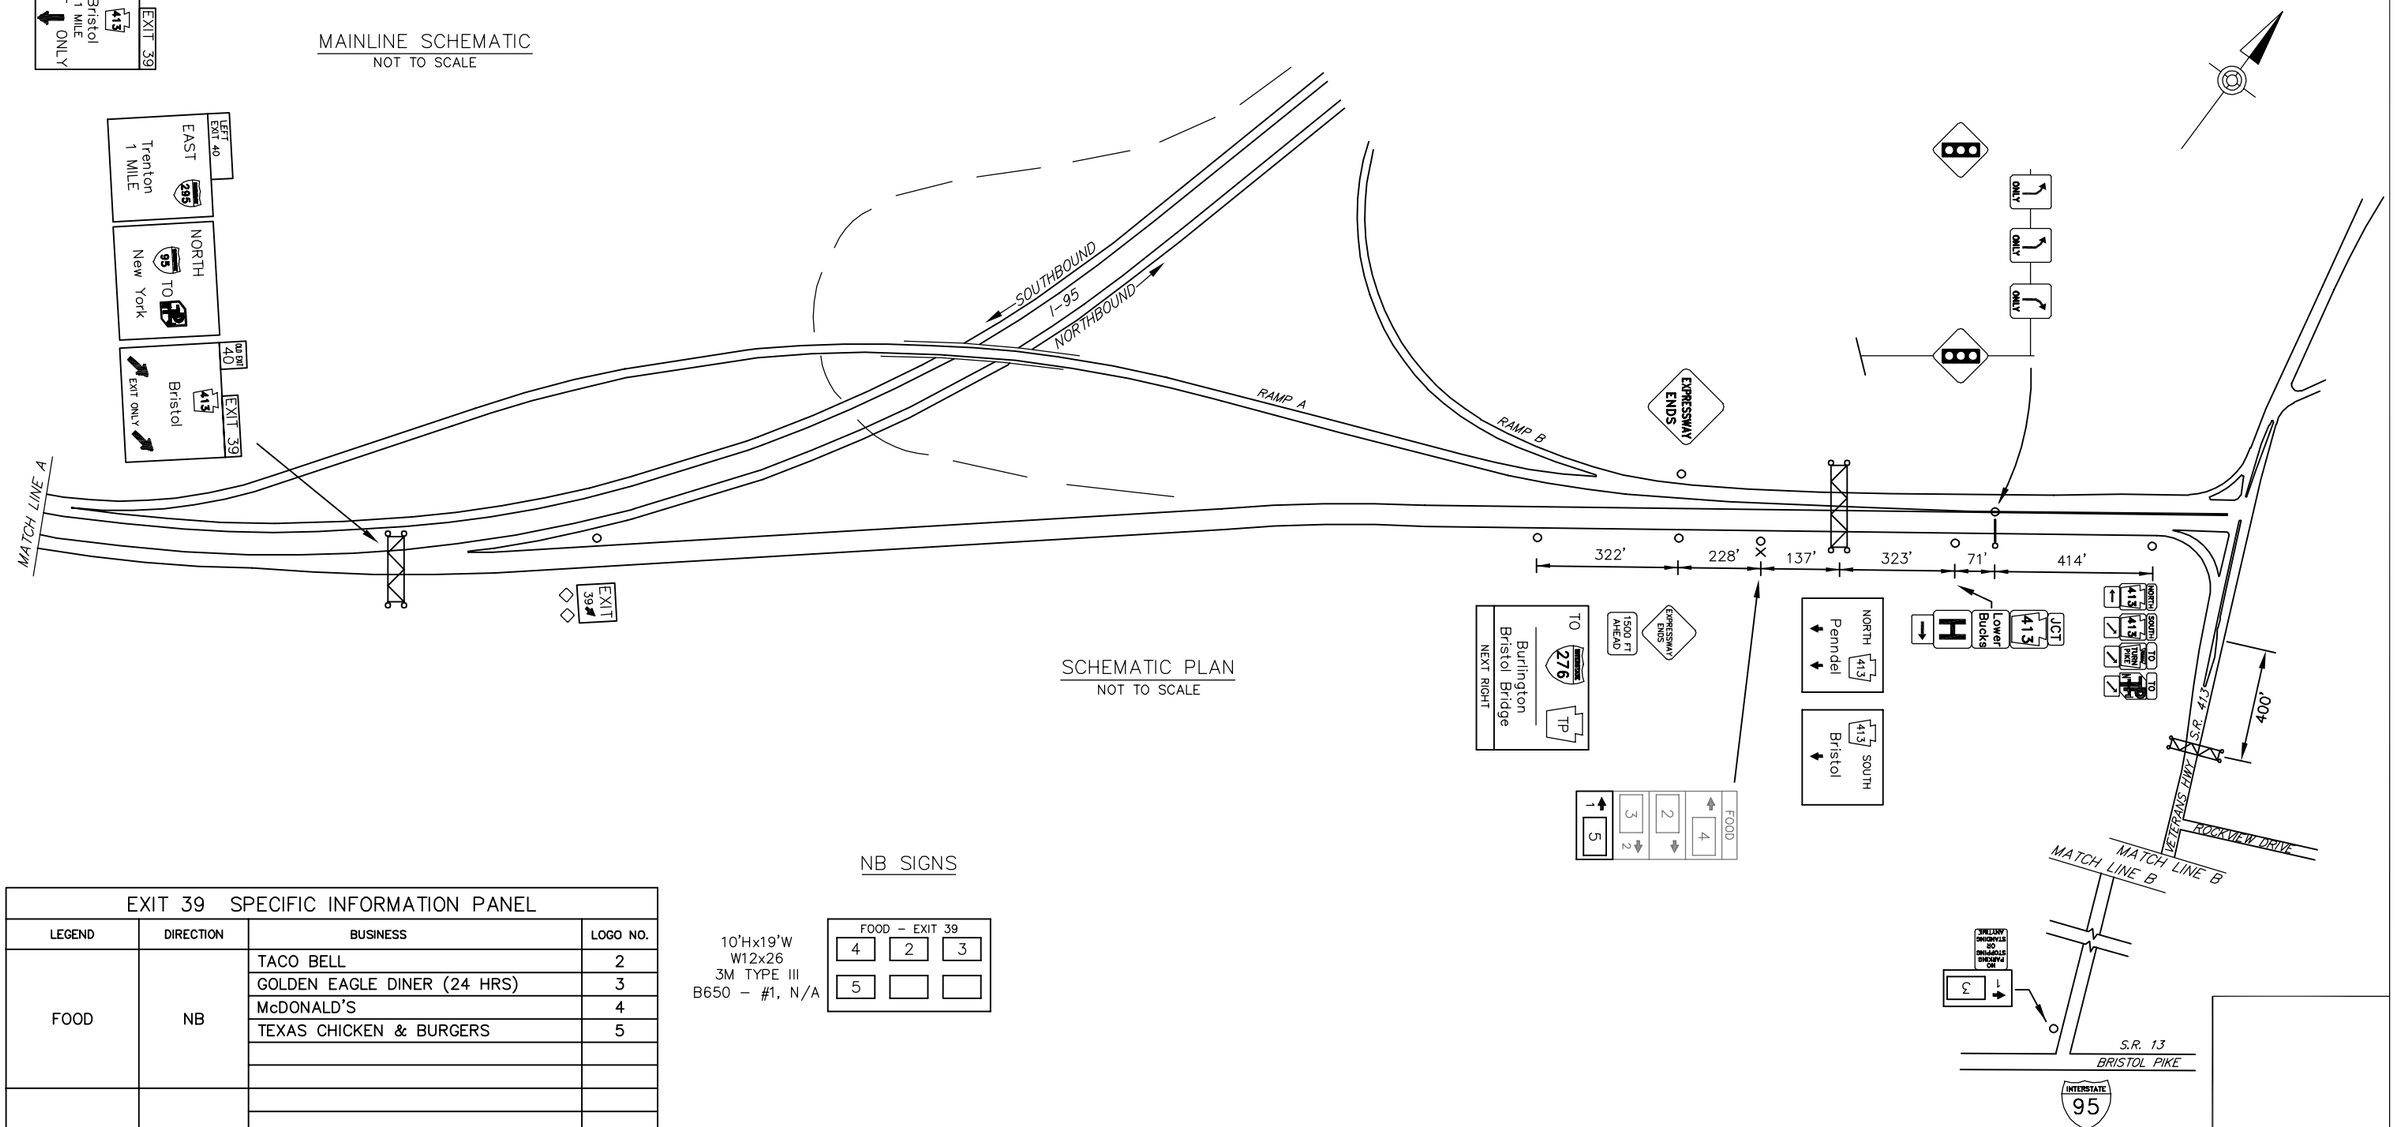

SCHEMATIC PLAN
NOT TO SCALE

NB SIGNS

10'Hx19'W
W12x26
3M TYPE III
B650 - #1, N/A

FOOD - EXIT 39		
4	2	3
5		

EXIT 39 SPECIFIC INFORMATION PANEL			
LEGEND	DIRECTION	BUSINESS	LOGO NO.
FOOD	NB	TACO BELL	2
		GOLDEN EAGLE DINER (24 HRS)	3
		McDONALD'S	4
		TEXAS CHICKEN & BURGERS	5

PA 413 / BRISTOL
EXIT 39
OLD EXIT 40

D:\2015_DBS\215076-01\HW\PSE\AS-BUILT DRAWINGS\PENNDOT DISTRICT 06\BUCKS - 09\10-XX SHTXX-195_EXIT 39 PLAN
February/8/2023 12:44 PM