DISTRICT	COUNTY	ROUTE	PROJECT	SHEET
3-0	TIOGA	US 15		
	LIBERTY TOWNSHIP			
3-0	LYCOMING			
	JACKSON TOWNSHIP			
	REVISIONS			

TABULATION OF QUANTITIES		
ITEM	UNIT	QUANTITY
POST MOUNTED SIGNS, TYPE A, LOGO	SQ.FT.	
POST MOUNTED SIGNS, TYPE A, LOGO (MODIFIED)	SQ.FT.	–
POST MOUNTED SIGNS, TYPE B, LOGO	SQ.FT.	
BREAKAWAY SYSTEMS	EACH	–
* STEEL S OR W BEAM POSTS	LBS.	–
LOGO SIGN MOUNTING	EACH	–
LOGO SIGN MOUNTING, RESET	EACH	–
REMOVAL OF POST MOUNTED MOTORIST SERVICE SIGNS, TYPES A & E	EACH	

* APPROXIMATE QUANTITY FOR INFORMATION ONLY

SYMBOLS

- ○ *Existing Sign to Remain*
- △ *Existing Sign to be Removed*
- □ *Existing Sign Reset as Shown*
- ● NEW SIGN
- × FUTURE SIGN
- Ø *Existing Utility Pole*

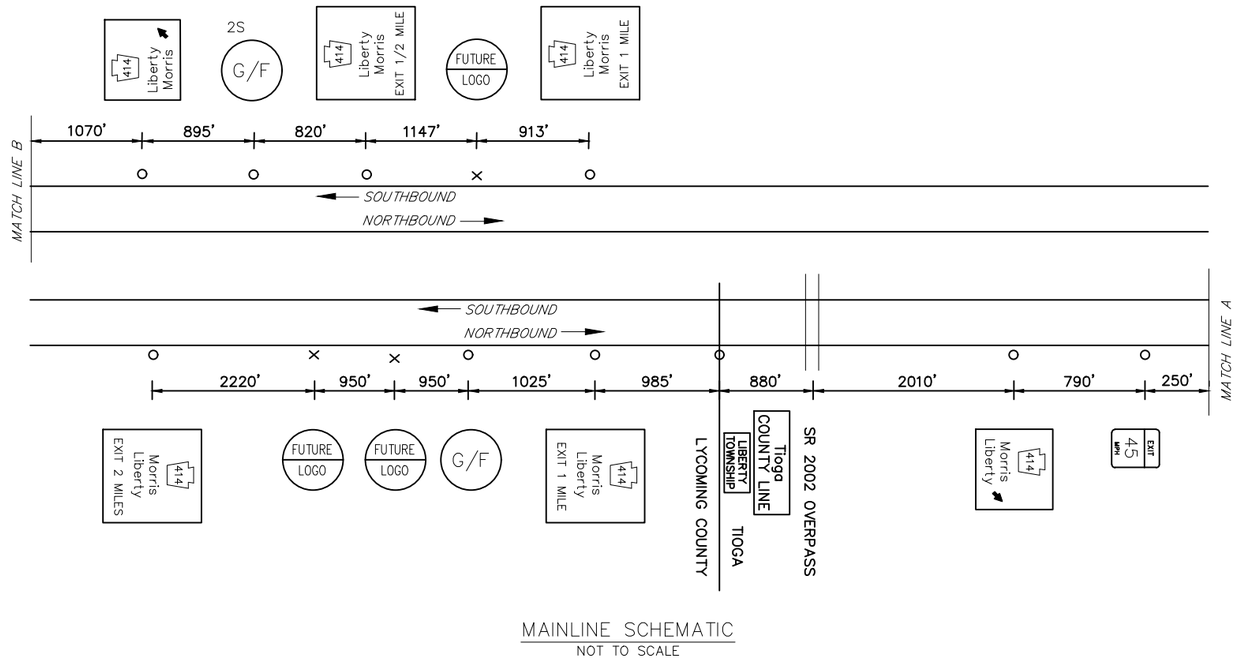

MAINLINE SCHEMATIC
NOT TO SCALE

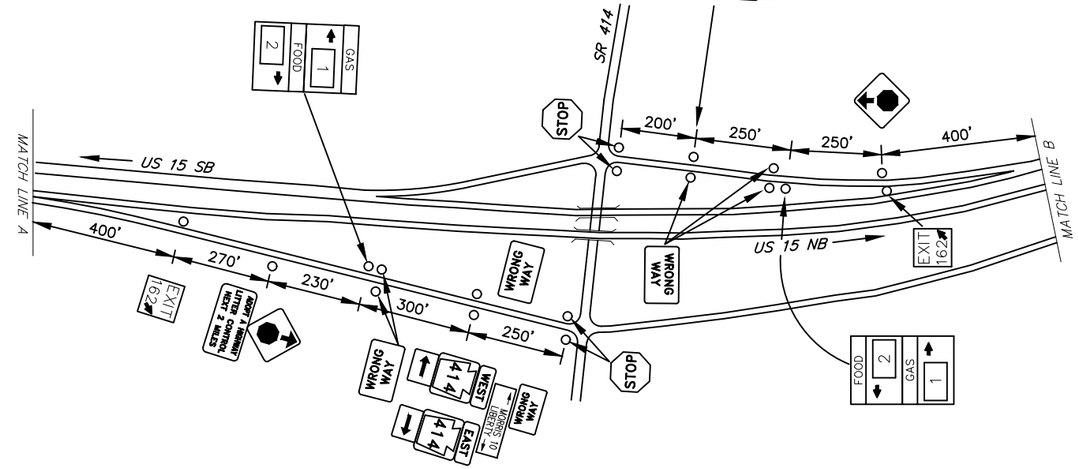

SCHEMATIC PLAN
NOT TO SCALE

LEGEND

2S – GUIDE RAIL

EXIT 162 SPECIFIC INFORMATION PANEL			
LEGEND	DIRECTION	BUSINESS	LOGO NO.
GAS	NB/SB	EXXON (DIESEL)	1
FOOD	NB/SB	THE LANDING STRIP FAMILY RESTAURANT	2

NB SIGNS

12'Hx13'W
FUTURE 16'H
W14x30 A572
3M TYPE III
B650 – #2, #2

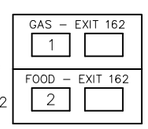

SB SIGNS

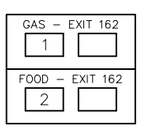

12'Hx13'W
W14x30 A572
3M TYPE III
B650 – #1, #1

15
SR 414
LIBERTY
EXIT 162

\\DAVOD01\CC\DATA\PROJECTS\2015\D3515209\6-01\PW\PSE\AS-BUILT DRAWINGS\PENNDOT DISTRICT 03\TIOGA - SR\15-XX SHTXX-US15_EXIT 162 (LIBERTY) PLAN
September/27/2021 11:03 AM