DISTRICT	COUNTY	ROUTE	PROJECT	SHEET
11-0	ALLEGHENY	PA 28	XXX-XX	X OF X

HARMAR TOWNSHIP

REVISIONS

TABULATION OF QUANTITIES		
ITEM	UNIT	QUANTITY
POST MOUNTED SIGNS, TYPE A, LOGO	SQ.FT.	–
POST MOUNTED SIGNS, TYPE A, LOGO (MODIFIED)	SQ.FT.	–
POST MOUNTED SIGNS, TYPE B, LOGO	SQ.FT.	–
BREAKAWAY SYSTEMS	EACH	–
* STEEL S OR W BEAM POSTS	LBS.	–
LOGO SIGN MOUNTING	EACH	–
LOGO SIGN MOUNTING, RESET	EACH	–
REMOVE POST MOUNTED SIGNS, TYPE A LOGO (MODIFIED)	EACH	
REMOVE POST MOUNTED SIGNS, TYPE E SERVICE SIGNS, TYPES B, C & F	EACH	

* APPROXIMATE QUANTITY FOR INFORMATION ONLY

SYMBOLS

- ○ *Existing Sign to Remain*
- △ *Existing Sign to be Removed*
- □ *Existing Sign Reset as Shown*
- ● NEW SIGN
- × FUTURE SIGN
- Ø *Existing Utility Pole*

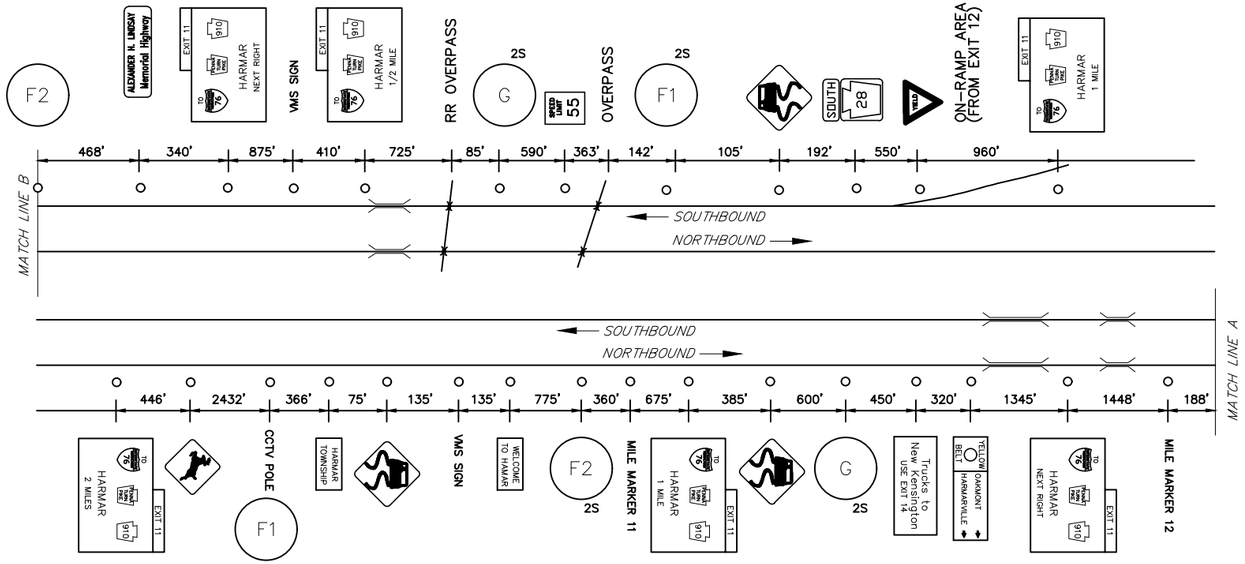

MAINLINE SCHEMATIC
NOT TO SCALE

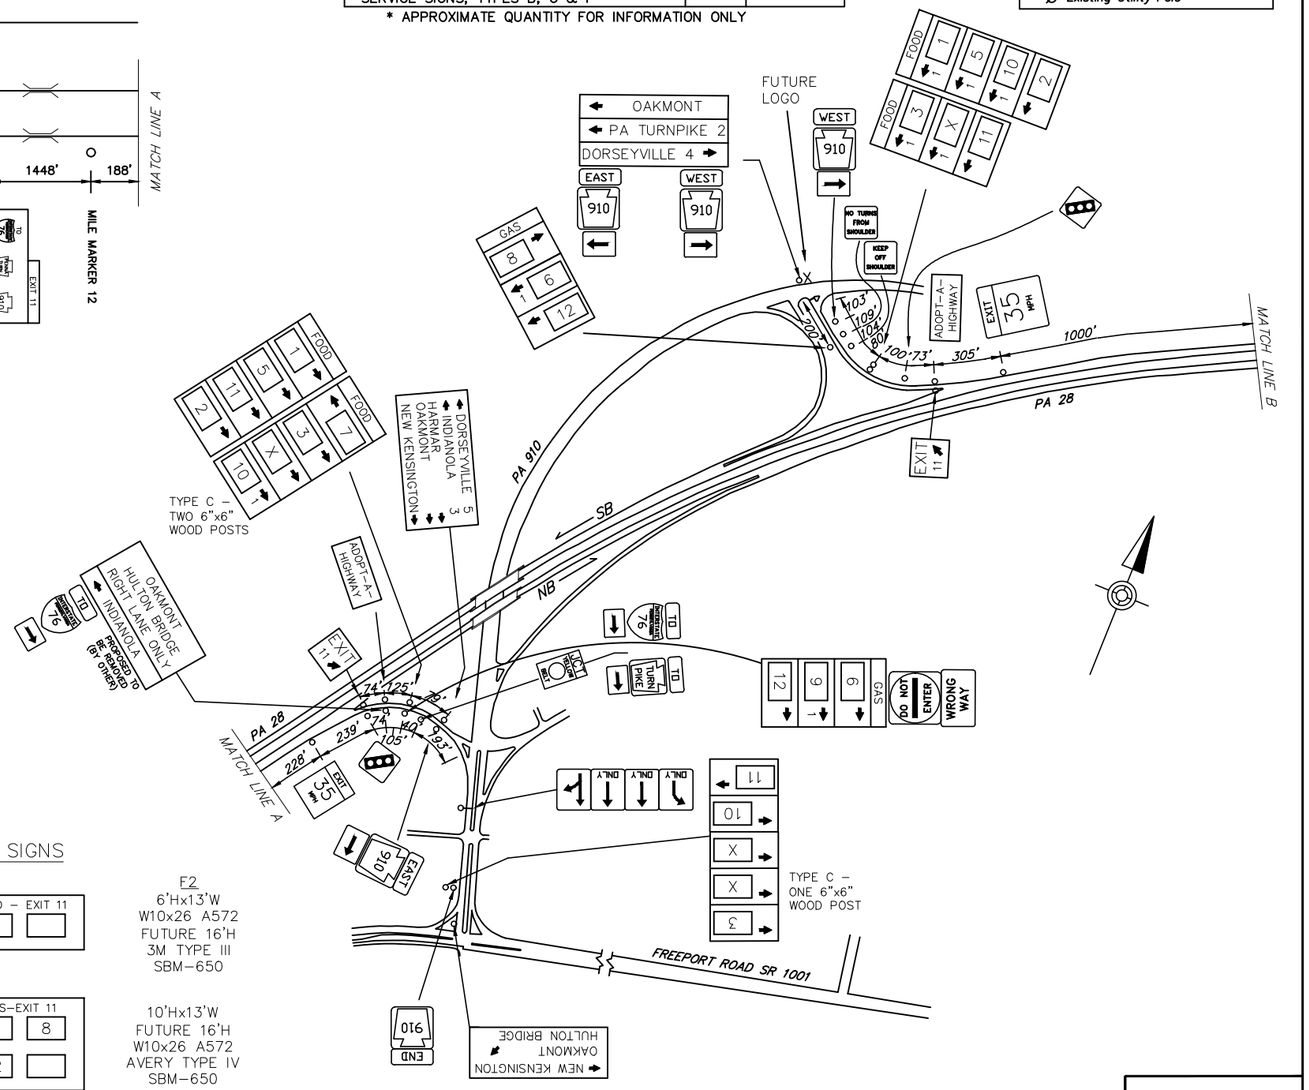

SCHEMATIC PLAN
NOT TO SCALE

FREEWAY LANE CLOSURES & RESTRICTIONS ONLY PERMITTED BETWEEN 9:00 PM AND 6:00 AM MONDAY THRU FRIDAY.
WORK ALONG FREEWAY PERMITTED BETWEEN 9:00 AM AND 2:30 PM, UNLESS OTHERWISE APPROVED BY ENGINEERING DISTRICT.
DO NOT WORK DURING HOLIDAY PERIODS.
IF APPLICABLE, REINSTALL GUIDERAIL AT END OF EACH DAY.

DISTRICT 11-0
PROVIDE 3 DAYS NOTICE PRIOR TO START OF WORK TO DISTRICT 11-0 KATHRYN POWER 412-429-6030.
SEE SPECIAL PROVISION 4901-0001.

LEGEND

2S – GUIDE RAIL

EXIT 11 SPECIFIC INFORMATION PANEL			
LEGEND	DIRECTION	BUSINESS	LOGO NO.
GAS	NB/SB	GETGO (24 HRS / DIESEL)	6
		MARATHON (DIESEL)	12
	NB	SHEETZ (24 HRS / DIESEL)	9
	SB	AMERICAN NATURAL (CNG / DIESEL)	8
FOOD	NB/SB	BOB EVANS RESTAURANT	1
		WENDY'S	3
		GIANT EAGLE EXPRESS	5
		PRIMANTI BROS	2
		SHEETZ	10
		TACO BELL	11
	NB	THE EATERY – AMERICAN NATURAL	7

NB SIGNS

6'Hx19'W
W10x22 A572
FUTURE 10'H
TYPE IX LEGEND
TYPE III BACKGROUND
B650 – #2, #1

GAS – EXIT 11: 6 | 9 | 12

F2
10'Hx19'W
W18x35 A572
FUTURE 16'H
3M TYPE III
B650 – #2, #3

FOOD – EXIT 11: 1 | 3 | 10 / X | 5 | 7

F1
6'Hx13'W
W10x26 A572
FUTURE 16'H
3M TYPE III
SBM-650

FOOD – EXIT 11: 11 | 2

SB SIGNS

FOOD – EXIT 11: 2

F2
6'Hx13'W
W10x26 A572
FUTURE 16'H
3M TYPE III
SBM-650

GAS-EXIT 11: 6 | 8 / 12

10'Hx13'W
FUTURE 16'H
W10x26 A572
AVERY TYPE IV
SBM-650

FOOD – EXIT 11: 1 | 10 | 3 / X | 5 | 11

F1
10'Hx19'W
W8x21 A572
3M TYPE III
B525 – #1, #2

28
HARMAR
EXIT 11

\\DAWOOD\C\DATA\PROJECTS\2015\D3B5-215076-01\MW\PSE\AS-BUILT DRAWINGS\PENNDOT DISTRICT 11\ALLEGHENY - 02\28_EXIT 11 PLAN
September/27/2021 11:03 AM