DISTRICT	COUNTY	ROUTE	PROJECT	SHEET
8-0	LANCASTER	PA 283		
	MT JOY TOWNSHIP			
8-0	DAUPHIN			
	CONEWAGO TOWNSHIP			
	REVISIONS			

TABULATION OF QUANTITIES		
ITEM	UNIT	QUANTITY
POST MOUNTED SIGNS, TYPE A, LOGO	SQ.FT.	
POST MOUNTED SIGNS, TYPE B, LOGO	SQ.FT.	
POST MOUNTED SIGNS, TYPE C, LOGO	SQ.FT.	–
BREAKAWAY SYSTEMS	EACH	
* STEEL S OR W BEAM POSTS	LBS.	
LOGO SIGN MOUNTING	EACH	
REMOVAL OF POST MOUNTED MOTORIST SERVICE SIGNS, TYPES A & E	EACH	–
REMOVAL OF POST MOUNTED MOTORIST SERVICE SIGNS, TYPES B, C & F	L.S.	

* APPROXIMATE QUANTITY FOR INFORMATION ONLY

SYMBOLS

- ○ *Existing Sign to Remain*
- △ *Existing Sign to be Removed*
- □ *Existing Sign Reset as Shown*
- ● NEW SIGN
- × FUTURE SIGN
- Ø *Existing Utility Pole*

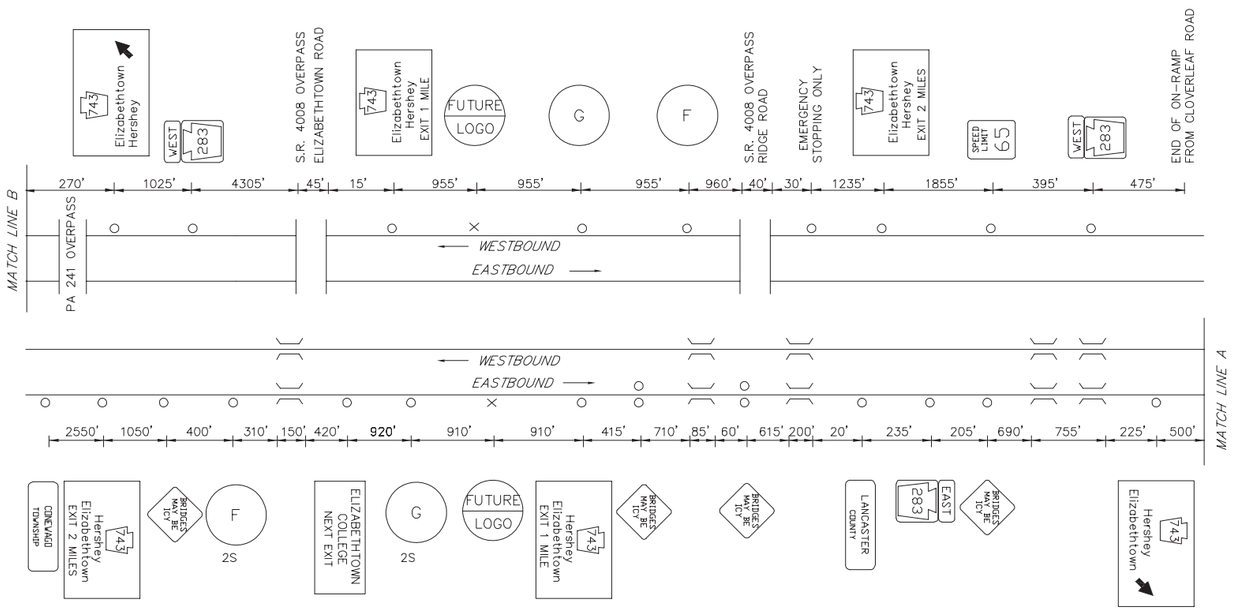

MAINLINE SCHEMATIC
NOT TO SCALE

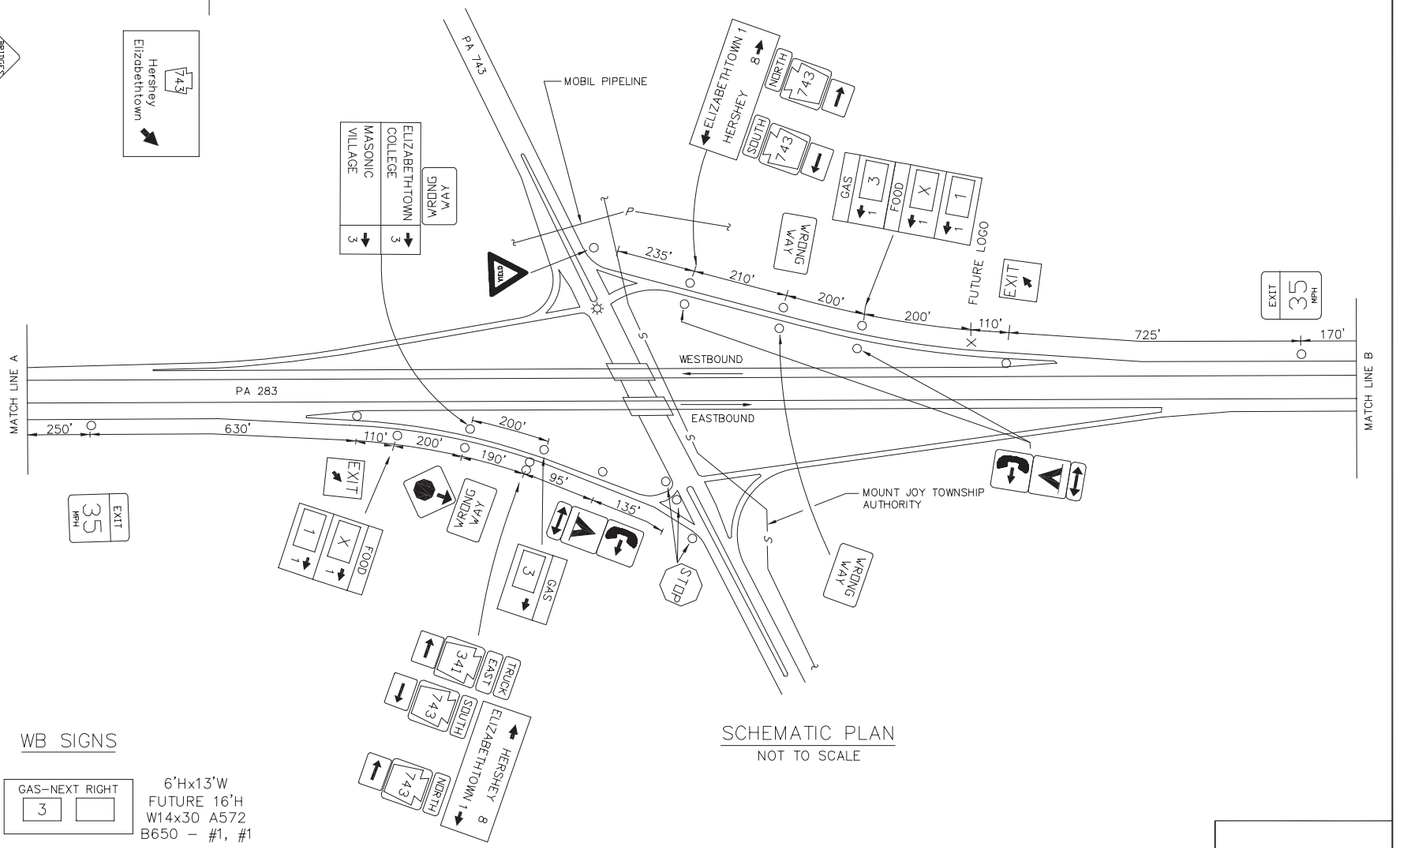

SCHEMATIC PLAN
NOT TO SCALE

LEGEND

2S – GUIDE RAIL

FREEWAY LANE CLOSURES & RESTRICTIONS
ONLY PERMITTED BETWEEN 9:00 PM AND
6:00 AM MONDAY THRU FRIDAY.
DO NOT WORK DURING HOLIDAY PERIODS.

ELIZABETHTOWN EXIT SPECIFIC INFORMATION PANEL			
LEGEND	DIRECTION	BUSINESS	LOGO NO.
GAS	EB/WB	TURKEY HILL #235	3
FOOD	EB/WB	PIZZA HUT	1

EB SIGNS

6'Hx13'W
FUTURE 16'H
W14x30 A572
B650 – #2, #2

GAS–NEXT RIGHT | 3 |

6'Hx13'W
FUTURE 14'H
W10x26 A572
B650 – #2, #2
3M TYPE III

FOOD–NEXT RIGHT | 1 | X |

WB SIGNS

GAS–NEXT RIGHT | 3 |

6'Hx13'W
FUTURE 16'H
W14x30 A572
B650 – #1, #1

FOOD–NEXT RIGHT | 1 | X |

6'Hx13'W
FUTURE 12'H
W10x26 A36
B650 – #1, #1
3M TYPE III

283
PA ROUTE 743

HERSHEY / ELIZABETHTOWN

\\DAVIDC\DATA\PROJECTS\2015\08ES\015976-01\WW\PSE\AS-BUILT DRAWINGS\PENNDOT DISTRICT 08\LANCASTER - 36\10-XX SHTXX_PA283_ELIZABETHTOWN
May/21/2021 10:11 AM