DISTRICT	COUNTY	ROUTE	PROJECT	SHEET
8-0	LANCASTER	PA 283		
RAPHO & EAST HEMPFIELD TOWNSHIPS				
REVISIONS				

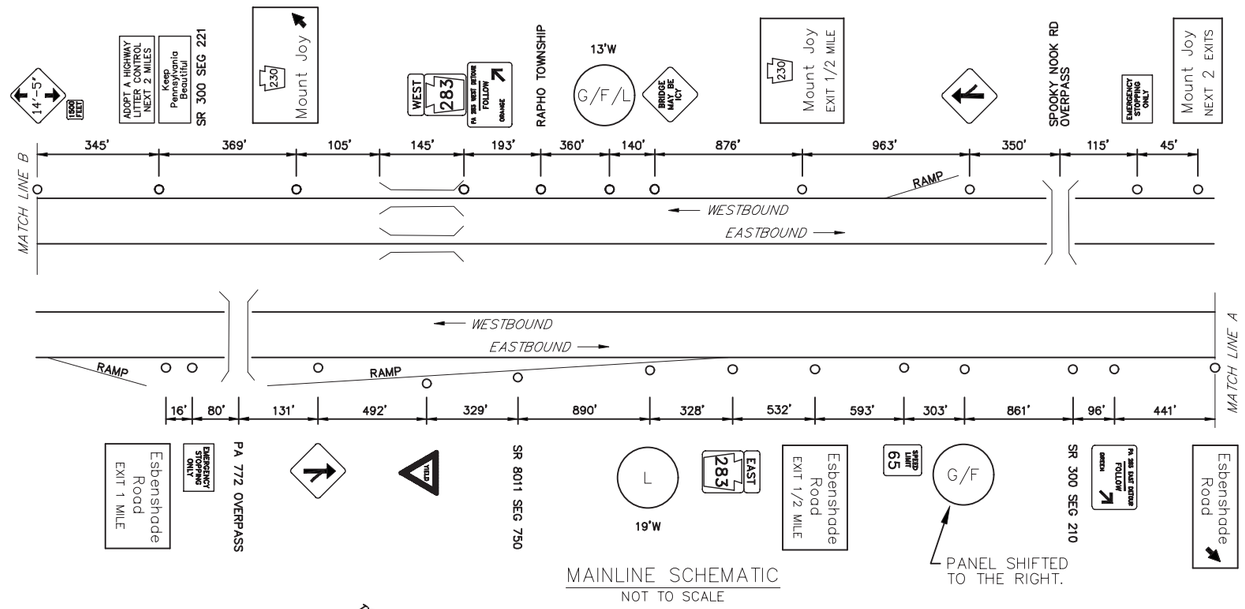

MAINLINE SCHEMATIC
NOT TO SCALE

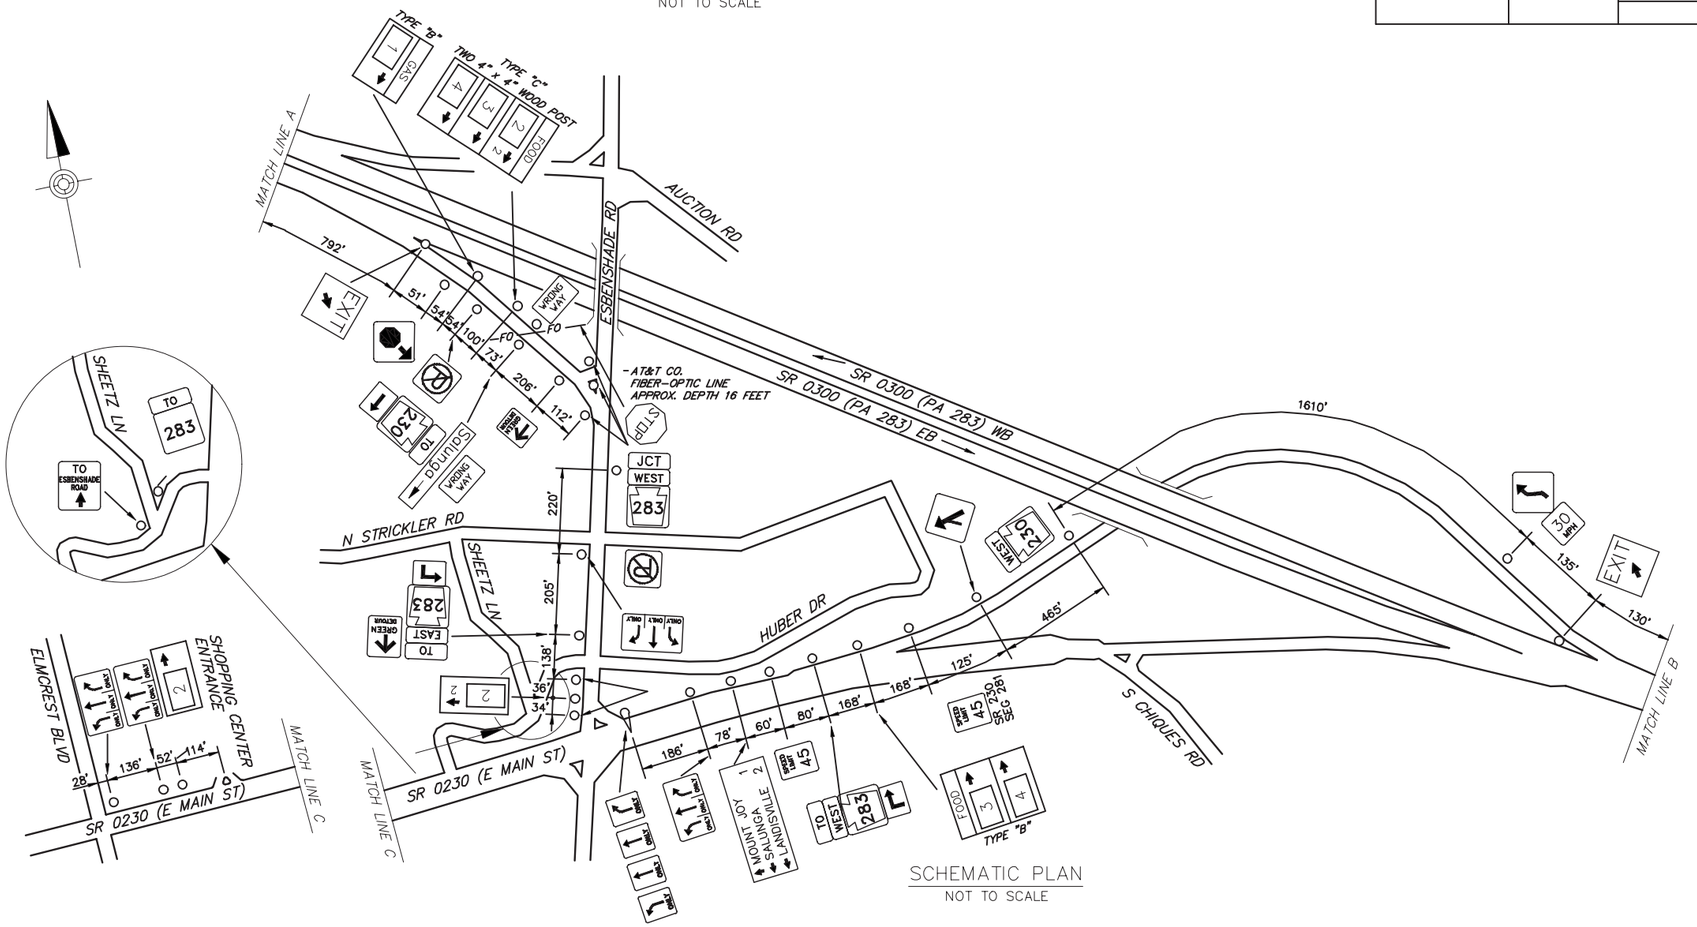

SCHEMATIC PLAN
NOT TO SCALE

TABULATION OF QUANTITIES		
ITEM	UNIT	QUANTITY
POST MOUNTED SIGNS, TYPE A, LOGO	SQ.FT.	–
POST MOUNTED SIGNS, TYPE B, LOGO	SQ.FT.	–
POST MOUNTED SIGNS, TYPE C, LOGO	SQ.FT.	–
BREAKAWAY SYSTEMS	EACH	–
* STEEL S OR W BEAM POSTS	LBS.	–
LOGO SIGN MOUNTING	EACH	–
REMOVAL OF POST MOUNTED MOTORIST SERVICE SIGNS, TYPES A & E	EACH	
REMOVAL OF POST MOUNTED MOTORIST SERVICE SIGNS, TYPES B, C & F	L.S.	

* APPROXIMATE QUANTITY FOR INFORMATION ONLY

SYMBOLS

- ○ *Existing Sign to Remain*
- △ *Existing Sign to be Removed*
- □ *Existing Sign Reset as Shown*
- ● NEW SIGN
- × FUTURE SIGN
- Ø *Existing Utility Pole*

ESBENSHADE RD/MT JOY EXIT SPECIFIC INFORMATION PANEL			
LEGEND	DIRECTION	BUSINESS	LOGO NO.
GAS	EB/WB	SHEETZ	1
FOOD	EB	ISAAC'S GRILLED SANDWICHES	2
	EB/WB	McDONALD'S (24 HOURS)	3
		MICK'S ALL AMERICAN PUB	4

EB SIGNS

12'Hx19'W
W14x30
B650 – #2, #2

GAS – NEXT RIGHT		
1		
FOOD – NEXT RIGHT		
2	3	4

6'Hx13'W
FUTURE 16'H
W14x30 A572
3M TYPE IV
B650 – #1, #1

LODGING–NEXT RIGHT	

WB SIGNS

18'Hx13'W
W18x40 A572
3M TYPE IV
B650 – #1, #1

GAS – NEXT RIGHT	
1	
FOOD – NEXT RIGHT	
3	4
LODGING–NEXT RIGHT	

283

ESBENSHADE RD & MOUNT JOY EXIT

\\DAVIDDC\DATA\PROJECTS\2015\D8152150576-01\HV\PSE\AS-BUILT DRAWINGS\PENNDOT DISTRICT 8\LANCASTER - 30\HP-XX SHTXX_PA283_ESBENSHADE-MT JOY PLAN
April/23/2021 9:31 AM