DISTRICT	COUNTY	ROUTE	PROJECT	SHEET
5-0	MONROE	PA-33		

HAMILTON AND ROSS TOWNSHIPS

REVISIONS

TABULATION OF QUANTITIES		
ITEM	UNIT	QUANTITY
POST MOUNTED SIGNS, TYPE A, LOGO	SQ.FT.	
POST MOUNTED SIGNS, TYPE B, LOGO	SQ.FT.	
POST MOUNTED SIGNS, TYPE C, LOGO	SQ.FT.	
BREAKAWAY SYSTEMS	EACH	
* STEEL S OR W BEAM POSTS	LBS.	
LOGO SIGN MOUNTING	EACH	
REMOVAL OF POST MOUNTED MOTORIST SERVICE SIGNS, TYPES A & E	EACH	
REMOVAL OF POST MOUNTED MOTORIST SERVICE SIGNS, TYPES B, C & F	L.S.	

* APPROXIMATE QUANTITY FOR INFORMATION ONLY

SYMBOLS

- ○ *Existing Sign to Remain*
- △ *Existing Sign to be Removed*
- □ *Existing Sign Reset as Shown*
- ● NEW SIGN
- × FUTURE SIGN
- Ø *Existing Utility Pole*

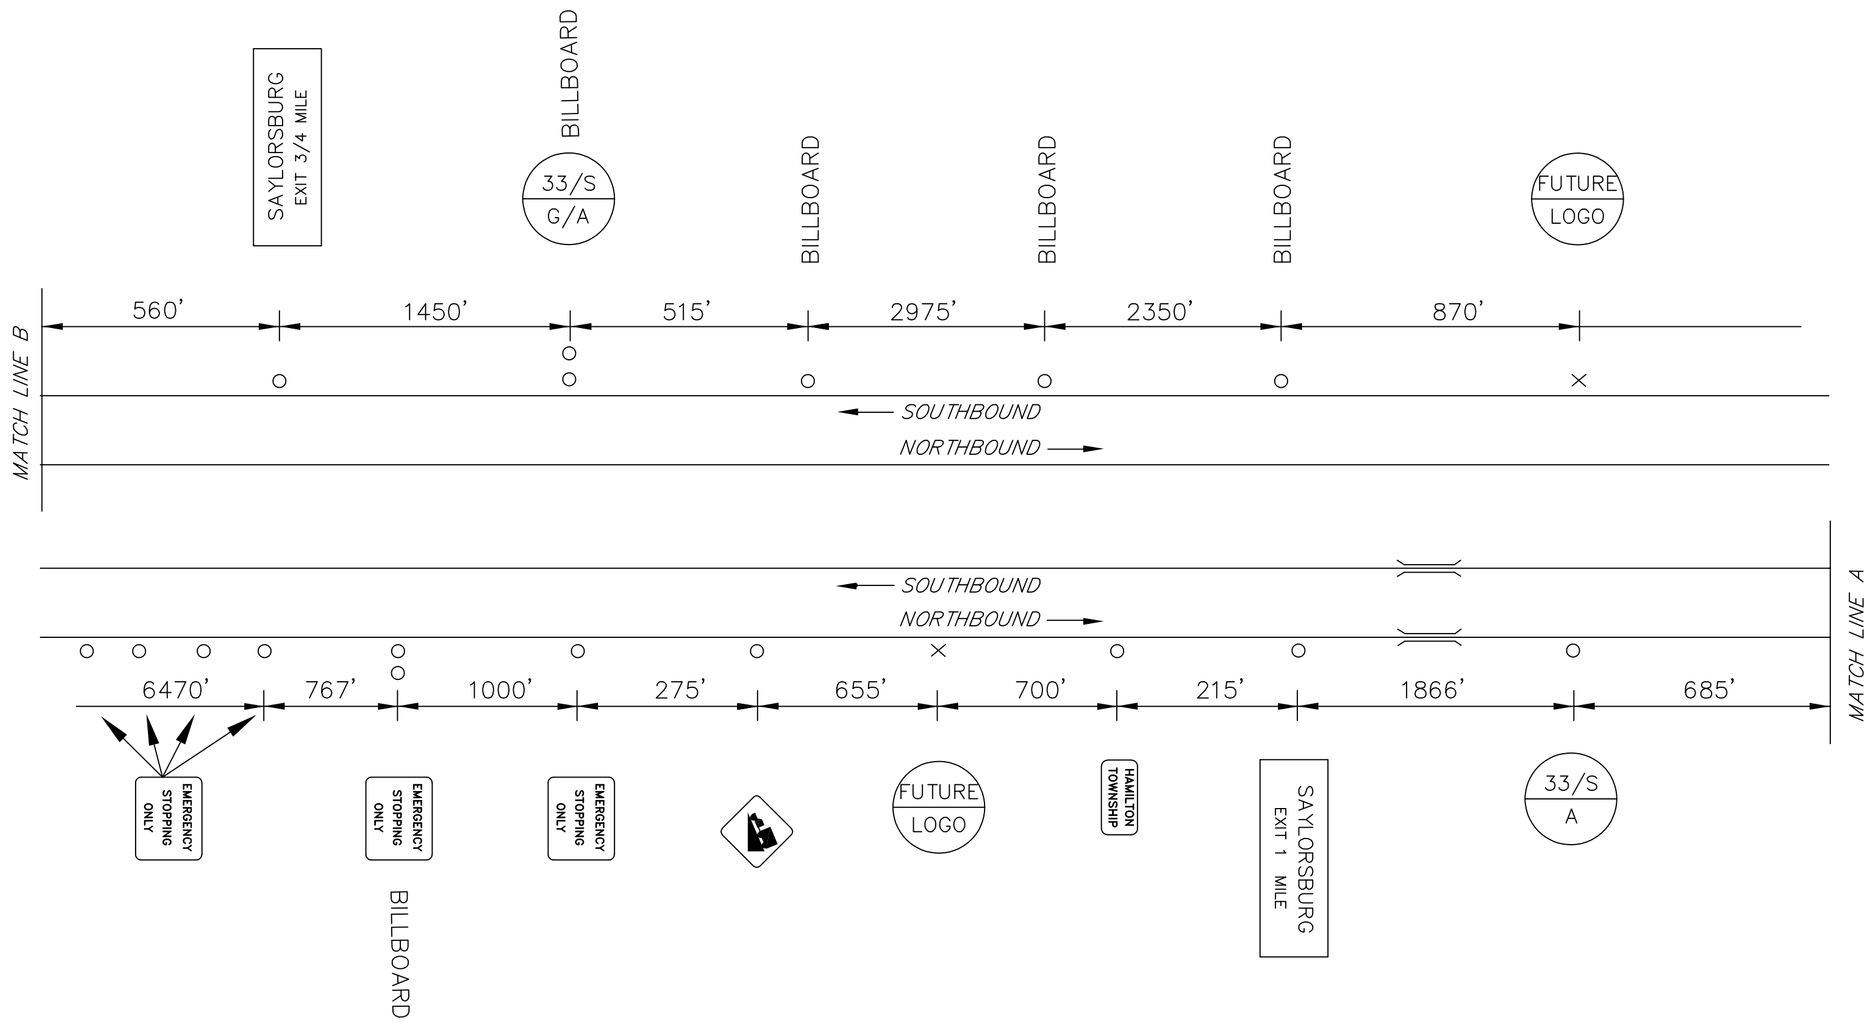

MAINLINE SCHEMATIC
NOT TO SCALE

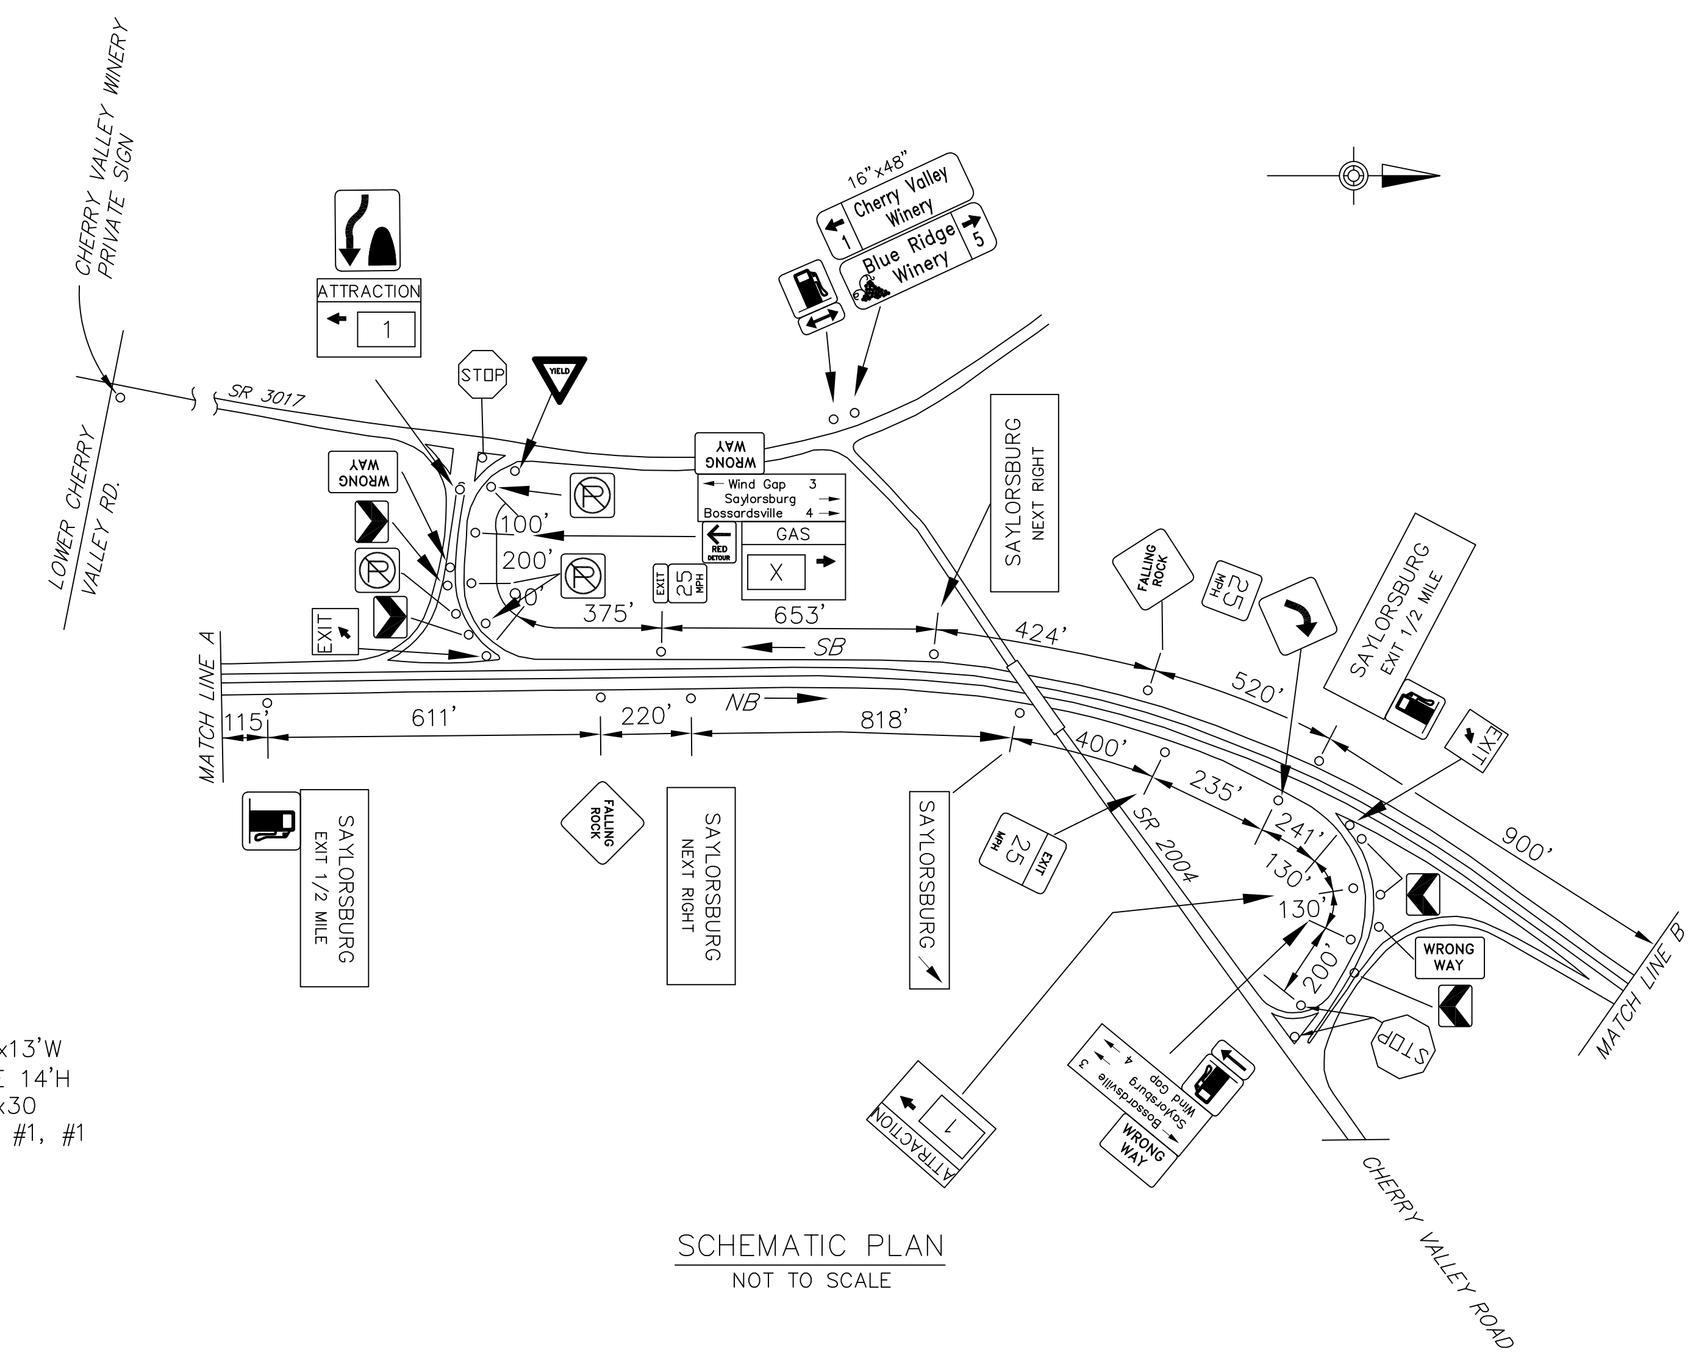

SCHEMATIC PLAN
NOT TO SCALE

SAYLORSBURG SPECIFIC INFORMATION PANEL			
LEGEND	DIRECTION	BUSINESS	LOGO NO.
GAS	SB		
ATTRACTION	NB/SB	CHERRY VALLEY WINERY	1

NB SIGNS

7.5'Hx13'W
FUTURE 16'H
W14x30
B650 – #2, #2

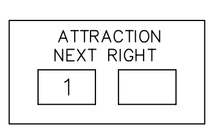

SB SIGNS

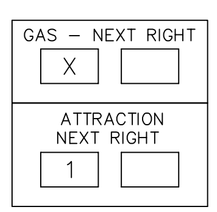

13.5'Hx13'W
FUTURE 14'H
W14x30
B650 – #1, #1

INTERSTATE 33

SR 2004

SAYLORSBURG

D:\2015_ADBS\215076-01\WK\PSE\AS-BUILT DRAWINGS\PENNDOT DISTRICT 05\MONROE - 45\10-XX SHTXX-33_EXIT SAYLORSBURG PLAN
June/6/2022 2:51 PM