| DISTRICT | COUNTY | ROUTE | PROJECT | SHEET |
|---|---|---|---|---|
| 5-0 | NORTHAMPTON | PA 33 | – | |
| PALMER & PLAINFIELD TWPS. & STOCKERTOWN BORO. | | | | |
| REVISIONS | | | | |

| TABULATION OF QUANTITIES | | |
|---|---|---|
| ITEM | UNIT | QUANTITY |
| POST MOUNTED SIGNS, TYPE A, LOGO | SQ.FT. | – |
| POST MOUNTED SIGNS, TYPE B, LOGO | SQ.FT. | |
| POST MOUNTED SIGNS, TYPE C, LOGO | SQ.FT. | – |
| BREAKAWAY SYSTEMS | EACH | – |
| * STEEL S OR W BEAM POSTS | LBS. | |
| LOGO SIGN MOUNTING | EACH | |
| REMOVAL OF POST MOUNTED MOTORIST SERVICE SIGNS, TYPES A & E | EACH | – |
| REMOVAL OF POST MOUNTED MOTORIST SERVICE SIGNS, TYPES B, C & F | L.S. | |

* APPROXIMATE QUANTITY FOR INFORMATION ONLY

**SYMBOLS**

- ○ *Existing Sign to Remain*
- △ *Existing Sign to be Removed*
- □ *Existing Sign Reset as Shown*
- ● NEW SIGN
- × FUTURE SIGN
- Ø *Existing Utility Pole*

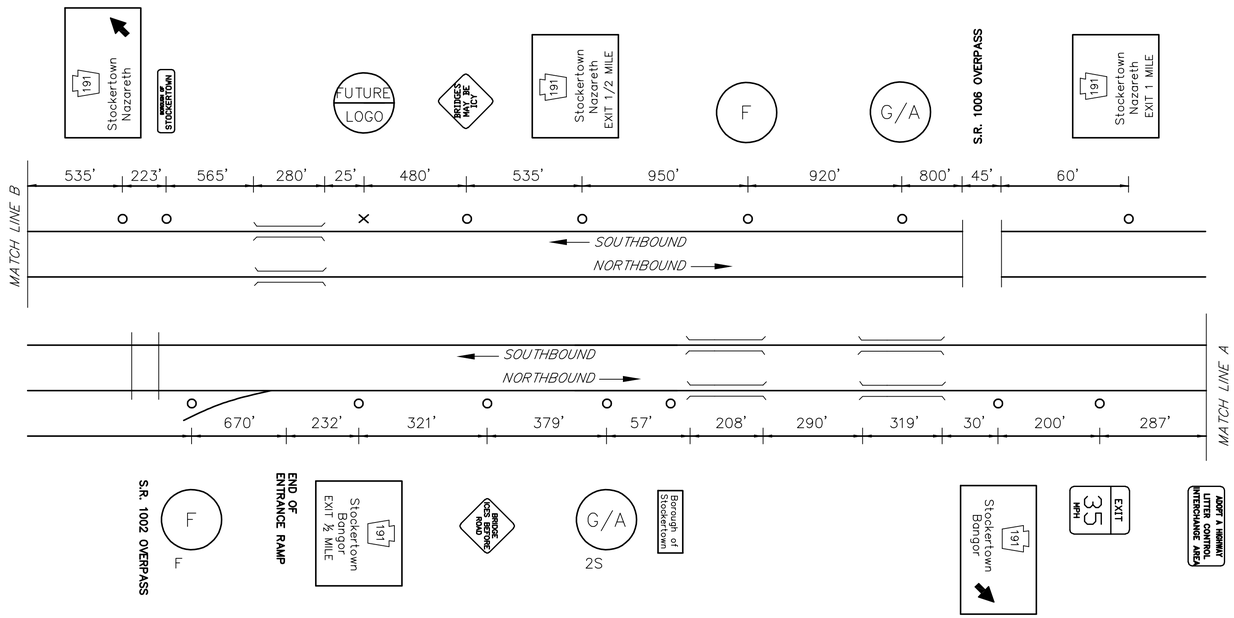


MAINLINE SCHEMATIC
NOT TO SCALE

DO NOT CLOSE OR RESTRICT TRAVEL LANES
BETWEEN 6:00 AM AND 9:00 AM, AND
BETWEEN 3:00 PM AND 6:00 PM, MONDAY THRU FRIDAY.
DO NOT WORK DURING HOLIDAY PERIODS.
DO NOT WORK DURING POCONO RACEWAY EVENT DATES.

## LEGEND

2S – GUIDE RAIL

| STOCKERTOWN SPECIFIC INFORMATION PANEL | | | |
|---|---|---|---|
| LEGEND | DIRECTION | BUSINESS | LOGO NO. |
| GAS | NB/SB | | |
| | | SUNOCO | 2 |
| | | | |
| ATTRACTION | NB/SB | | |
| | | | |

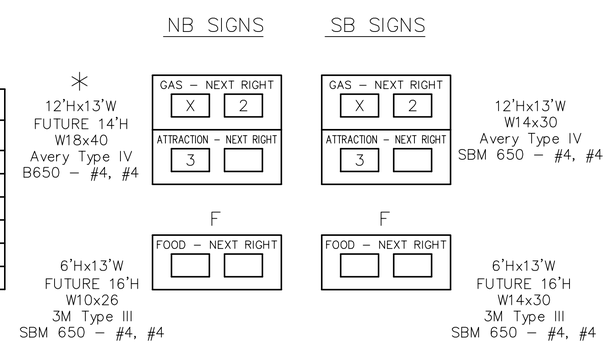


✳ RESET BY PENNDOT SPRING 2015
FROM DESIGNED LOGO INSTALLATION TO
NEW NON-PTST DESIGNED SIGN POSTS.

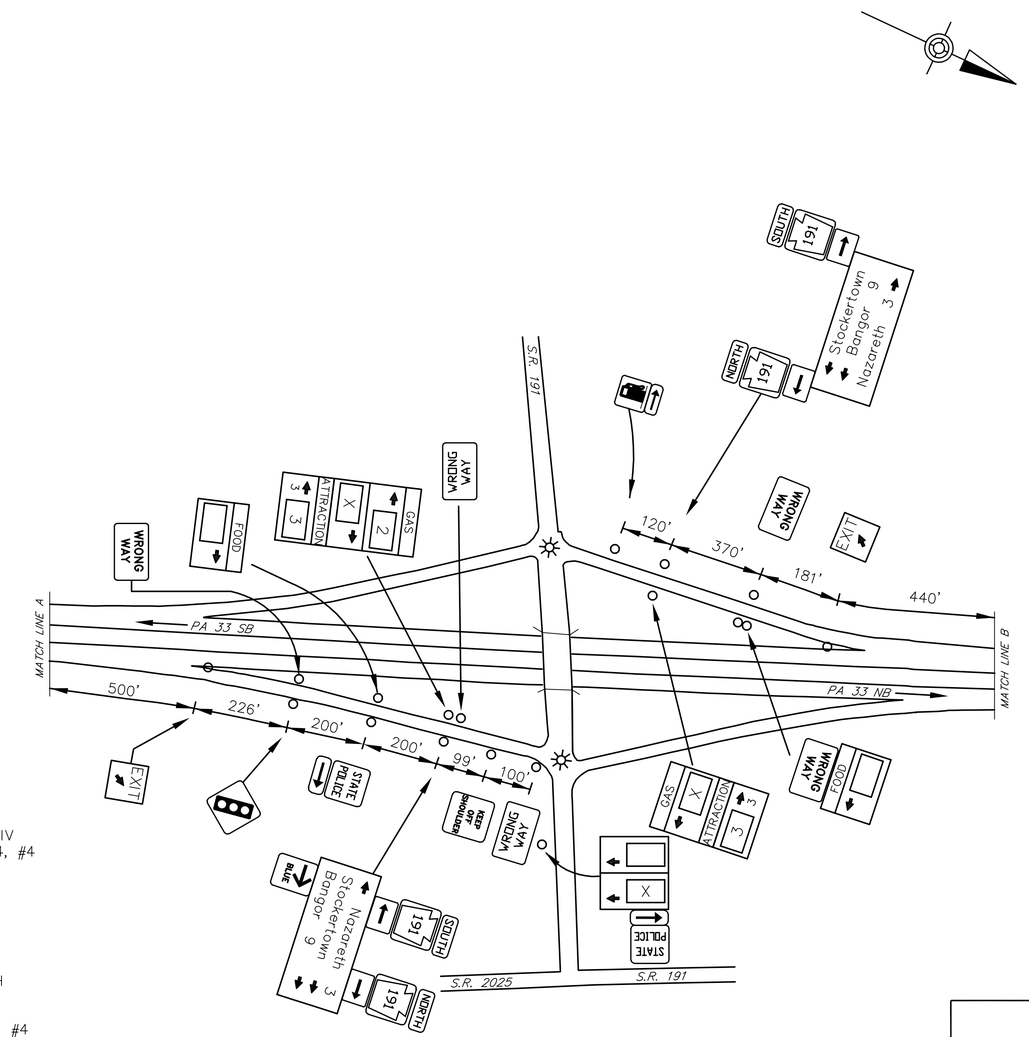


SCHEMATIC PLAN
NOT TO SCALE

33
S.R. 0191
STOCKERTOWN

D:\2015_JOBS\215976-01\MA\PSE\AS-BUILT DRAWINGS\PENNDOT DISTRICT 05\NORTHAMPTON - 48\10-XX SHTXX-33_EXIT STOCKERTOWN PLAN
June/14/2022 2:52 PM