DISTRICT	COUNTY	ROUTE	PROJECT	SHEET
10-0	INDIANA	U.S. 422		
WHITE TOWNSHIP				
REVISIONS				

TABULATION OF QUANTITIES		
ITEM	UNIT	QUANTITY
POST MOUNTED SIGNS, TYPE A	SQ.FT.	
POST MOUNTED SIGNS, TYPE B	SQ.FT.	
BREAKAWAY SYSTEMS	EACH	
* STEEL W BEAM BREAKAWAY POSTS	LBS.	
LOGO SIGN MOUNTING	EACH	
REMOVAL OF POST MOUNTED MOTORIST SERVICE SIGNS, TYPES A & E	EACH	
REMOVAL OF POST MOUNTED MOTORIST SERVICE SIGNS, TYPES B, C & F	L.S.	

* APPROXIMATE QUANTITY FOR INFORMATION ONLY

SYMBOLS

- ○ *Existing Sign to Remain*
- △ *Existing Sign to be Removed*
- □ *Existing Sign Reset as Shown*
- ● NEW SIGN
- × FUTURE SIGN
- Ø *Existing Utility Pole*

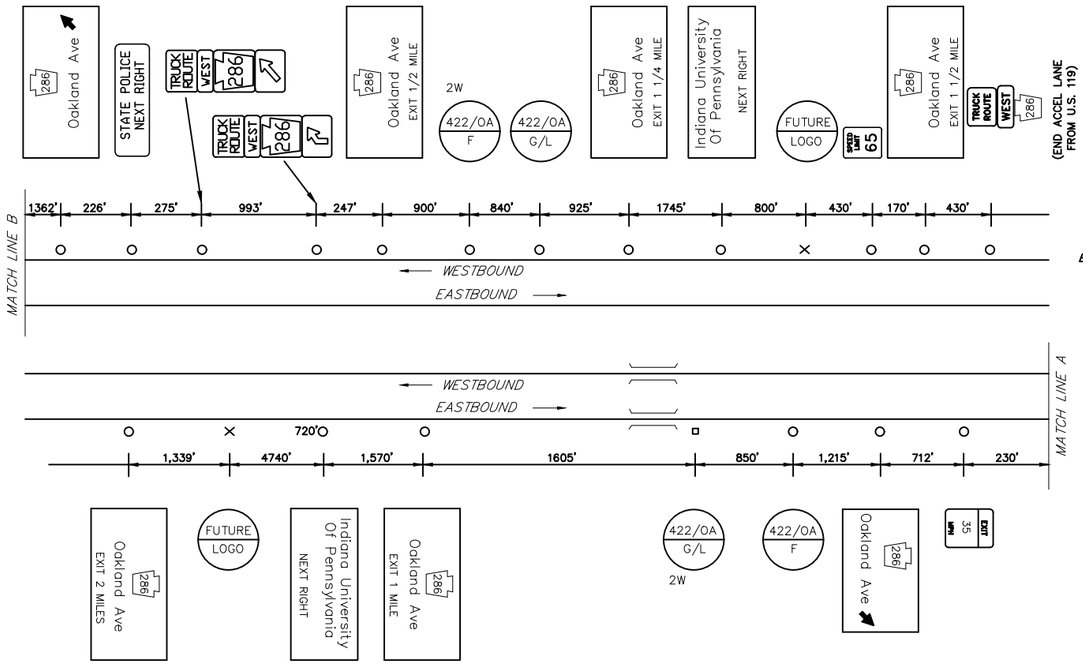

MAINLINE SCHEMATIC
NOT TO SCALE

FREEWAY LANE CLOSURES ONLY PERMITTED
MONDAY 7:00 AM THRU FRIDAY 8:00 AM.
ONLY ONE LANE CLOSURE PERMITTED AT A TIME.
LIMIT LANE CLOSURE LENGTHS TO 2,000 FEET OR LESS.
LANE CLOSURES REQUIRE SHADOW VEHICLE
(SEE PUB. 213 PATA 18).
RE-OPEN CLOSED LANES IF SIGNIFICANT QUEING IS OBSERVED.

WORK PROHIBITED DURING NIGHTTIME/HOURS OF DARKNESS.

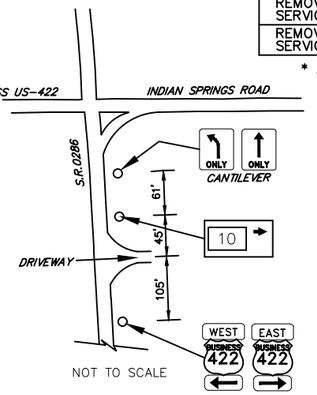

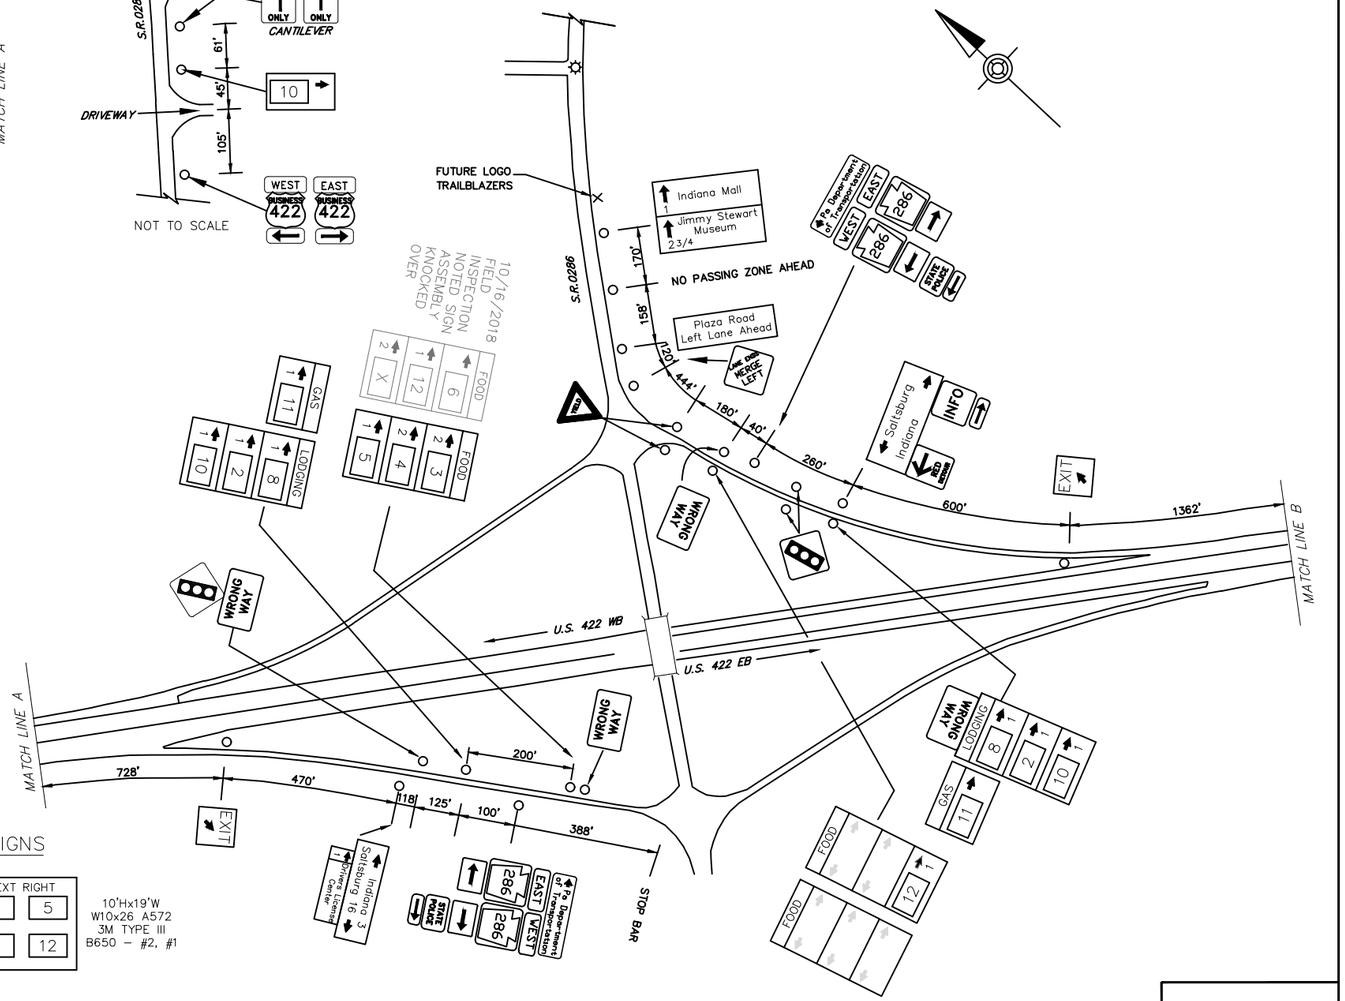

SCHEMATIC PLAN
NOT TO SCALE

OAKLAND AVENUE SPECIFIC INFORMATION PANEL			
LEGEND	DIRECTION	BUSINESS	LOGO NO.
GAS	EB/WB	GETGO	11
FOOD	EB/WB	McDONALD'S	3
		EAT'N PARK (24 HOURS)	4
		WENDY'S	5
		PERKINS FAMILY RESTAURANT	6
		STARBUCKS	12
LDOGING	EB/WB	DAYS INN	2
		BEST WESTERN	8
		HAMPTON INN	10

EB SIGNS

10'Hx19'W W10x22 A572 3M TYPE III B650 - #2, #2

FOOD - NEXT RIGHT		
3	4	5
6	X	12

16'Hx13'W W12x26 A572 3M TYPE III B650 - #1, #1

AVERY TYPE IV

GAS - NEXT RIGHT	
11	
LODGING-NEXT RIGHT	
2	8
10	

WB SIGNS

FOOD - NEXT RIGHT		
3	4	5
6	X	12

10'Hx19'W W10x26 A572 3M TYPE III B650 - #2, #1

GAS - NEXT RIGHT	
11	
LODGING-NEXT RIGHT	
2	8
10	

16'Hx13'W W12x26 A572 TYPE IV B650 - #2, #2

AVERY TYPE IV

422
PA 286
OAKLAND AVENUE

\\BAVDDD.DOT\DATA\PROJECTS\2015_EDBS\125076-01\WV\PSE\AS-BUILT DRAWINGS\PENNDOT DISTRICT 10\INDIANA - 32\10-XX_SHTXX US422 OAKLAND AVE PLAN
September/27/2021 11:24 AM