DISTRICT	COUNTY	ROUTE	PROJECT	SHEET
12-0	WESTMORELAND	I-70	XXX-XX	X OF X

BOROUGH OF NEW STANTON AND HEMPFIELD TOWNSHIP

REVISIONS

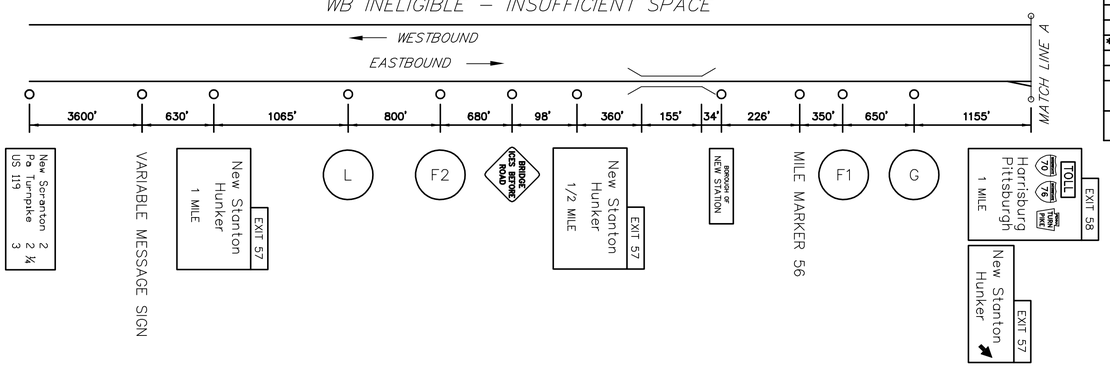

MAINLINE SCHEMATIC
NOT TO SCALE

TABULATION OF QUANTITIES		
ITEM	UNIT	QUANTITY
POST MOUNTED SIGNS, TYPE A, LOGO	SQ.FT.	--
POST MOUNTED SIGNS, TYPE A, LOGO (MODIFIED)	SQ.FT.	--
POST MOUNTED SIGNS, TYPE B, LOGO	SQ.FT.	--
POST MOUNTED SIGNS, TYPE C, LOGO	SQ.FT.	--
BREAKAWAY SYSTEMS	EACH	--
* STEEL S OR W BEAM POSTS	LBS.	--
LOGO SIGN MOUNTING	EACH	--
LOGO SIGN MOUNTING, RESET	EACH	--
REMOVE POST MOUNTED SIGNS, TYPE A LOGO (MODIFIED)	EACH	--
REMOVE POST MOUNTED SIGNS, TYPE A, LOGO	EACH	--

* APPROXIMATE QUANTITY FOR INFORMATION ONLY

SYMBOLS

- ○ *Existing Sign to Remain*
- △ *Existing Sign to be Removed*
- □ *Existing Sign Reset as Shown*
- ● NEW SIGN
- × FUTURE SIGN
- Ø *Existing Utility Pole*

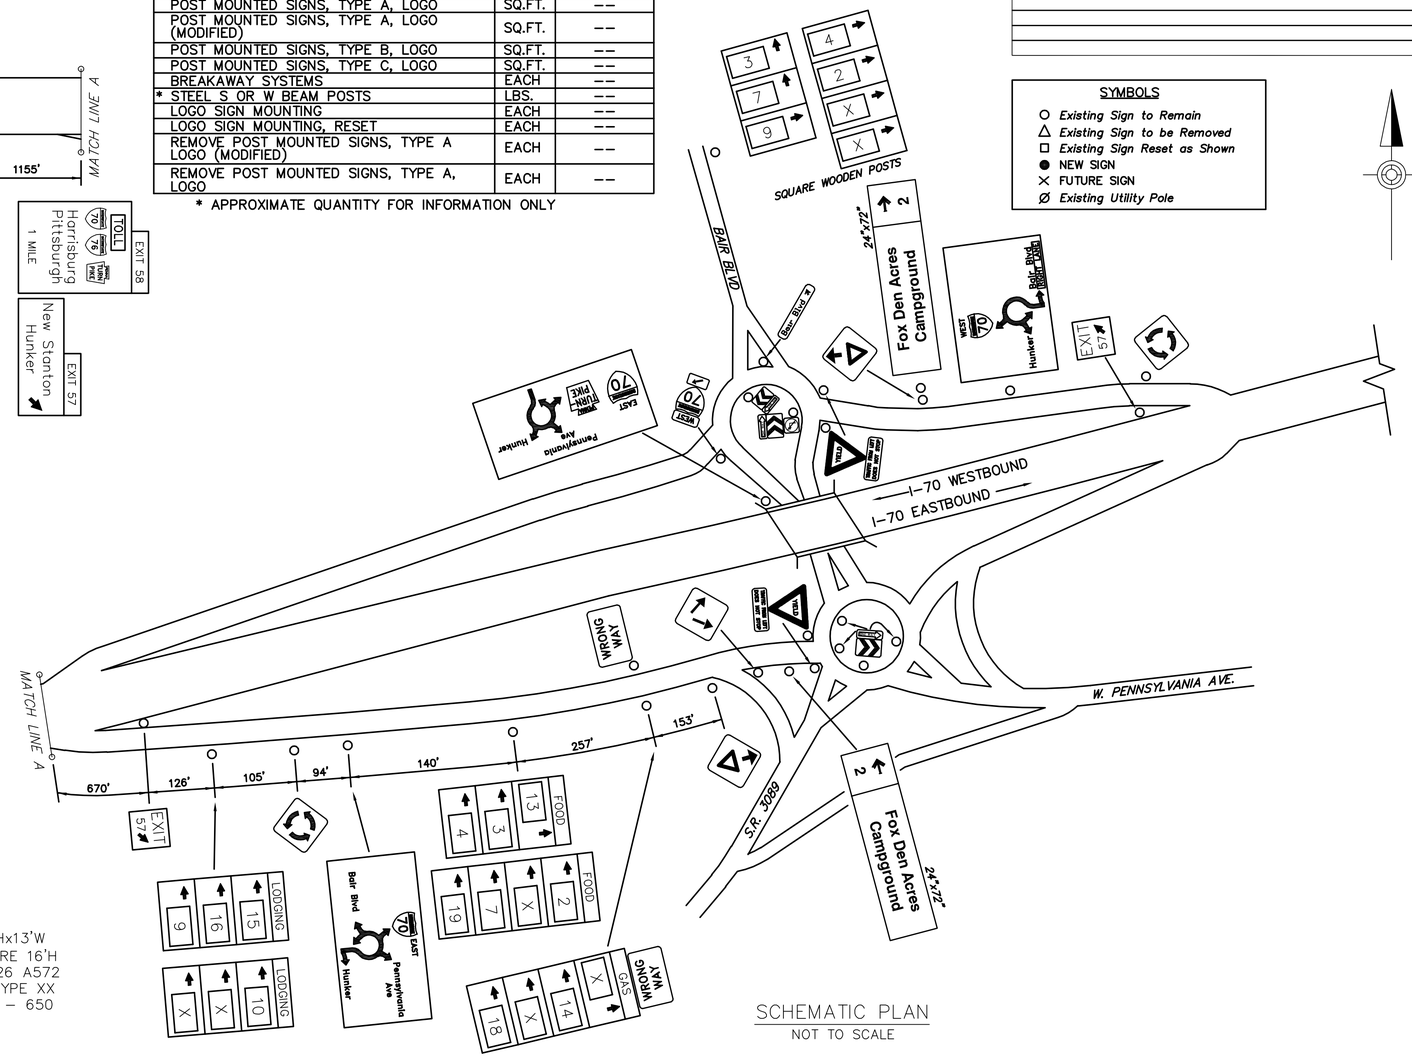

SCHEMATIC PLAN
NOT TO SCALE

LEGEND

2S – GUIDE RAIL

FREEWAY LANE CLOSURES & RESTRICTIONS ONLY PERMITTED BETWEEN 9:00 PM AND 6:00 AM MONDAY THRU FRIDAY. WORK ALONG FREEWAY PERMITTED BETWEEN 9:00 AM AND 2:30 PM, UNLESS OTHERWISE APPROVED BY ENGINEERING DISTRICT. DO NOT WORK DURING HOLIDAY PERIODS. IF APPLICABLE, REINSTALL GUIDERAIL AT END OF EACH DAY.

EXIT 57 SPECIFIC INFORMATION PANEL			
LEGEND	DIRECTION	BUSINESS	LOGO NO.
GAS	EB		
		SHEETZ	14
		GETGO	18
FOOD	EB		
		EAT'N PARK (24-HOUR)	2
		BOB EVANS RESTAURANT	3
		McDONALD'S	4
		WENDY'S	7
		CRACKER BARREL	13
		GETGO	19
LODGING	EB		
		DAYS INN	9
		SUPER 8	10
		COMFORT INN	15
		FAIRFIELD INN & SUITES-MARRIOT	6

EB SIGNS

GAS – EXIT 57: 18 X / 14 ▲

10'Hx13'W
FUTURE 16'H
W10x26 A572
XX TYPE XX
SBM – 650

FOOD – EXIT 57: 2 3 / 4 7 / X 13

F2
14'Hx13'W
W14x30
3M TYPE III
B650 – #4, #4

LODGING–EXIT 57: 9 10 / X X / 15 16

14'Hx13'W
W12x26 A572
3M TYPE III
B650 – #4, #4

FOOD – EXIT 57: 19 / ▲

F1
10'Hx13'W
FUTURE 16'H
W10x26 A572
XX TYPE XX
SBM – 650

INTERSTATE 70

NEW STANTON
EXIT 57

D:\2015_JOBS\215976-01\MK\PSE\AS-BUILT DRAWINGS\PENNDOT DISTRICT 12\WESTMORELAND - 6410-XX SMTXX-I70 EXIT 57 PLAN
June/16/2022 6:59 PM