DISTRICT	COUNTY	ROUTE	PROJECT	SHEET
2-0	CENTRE	I-80		

BOGGS TOWNSHIP

REVISIONS

TABULATION OF QUANTITIES		
ITEM	UNIT	QUANTITY
POST MOUNTED SIGNS, TYPE A, LOGO	SQ.FT.	———
POST MOUNTED SIGNS, TYPE B, LOGO	SQ.FT.	———
POST MOUNTED SIGNS, TYPE C, LOGO	SQ.FT.	———
BREAKAWAY SYSTEMS	EACH	———
* STEEL S OR W BEAM POSTS	LBS.	———
LOGO SIGN MOUNTING	EACH	———
FLAT SHEET PANEL REPLACEMENT	SQ.FT.	
EXTRUDED PANEL REPLACEMENT	SQ.FT.	
REMOVAL OF POST MOUNTED MOTORIST SERVICE SIGNS, TYPES B, C & F	L.S.	———
BREAKAWAY SYS., BRKTS. SUPPLIED BY TRUST	EACH	

* APPROXIMATE QUANTITY FOR INFORMATION ONLY

SYMBOLS

- ○ *Existing Sign to Remain*
- △ *Existing Sign to be Removed*
- □ *Existing Sign Reset as Shown*
- ● NEW SIGN
- × FUTURE SIGN
- Ø *Existing Utility Pole*

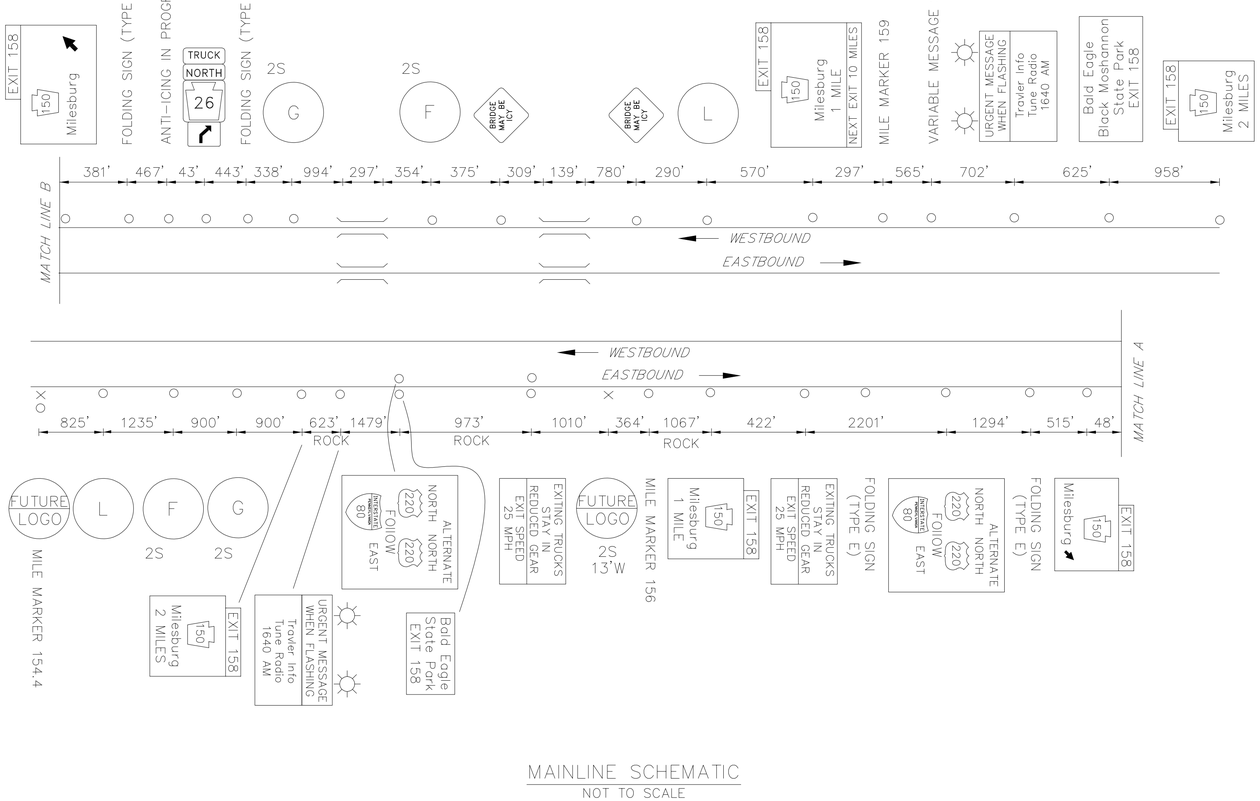

MAINLINE SCHEMATIC

NOT TO SCALE

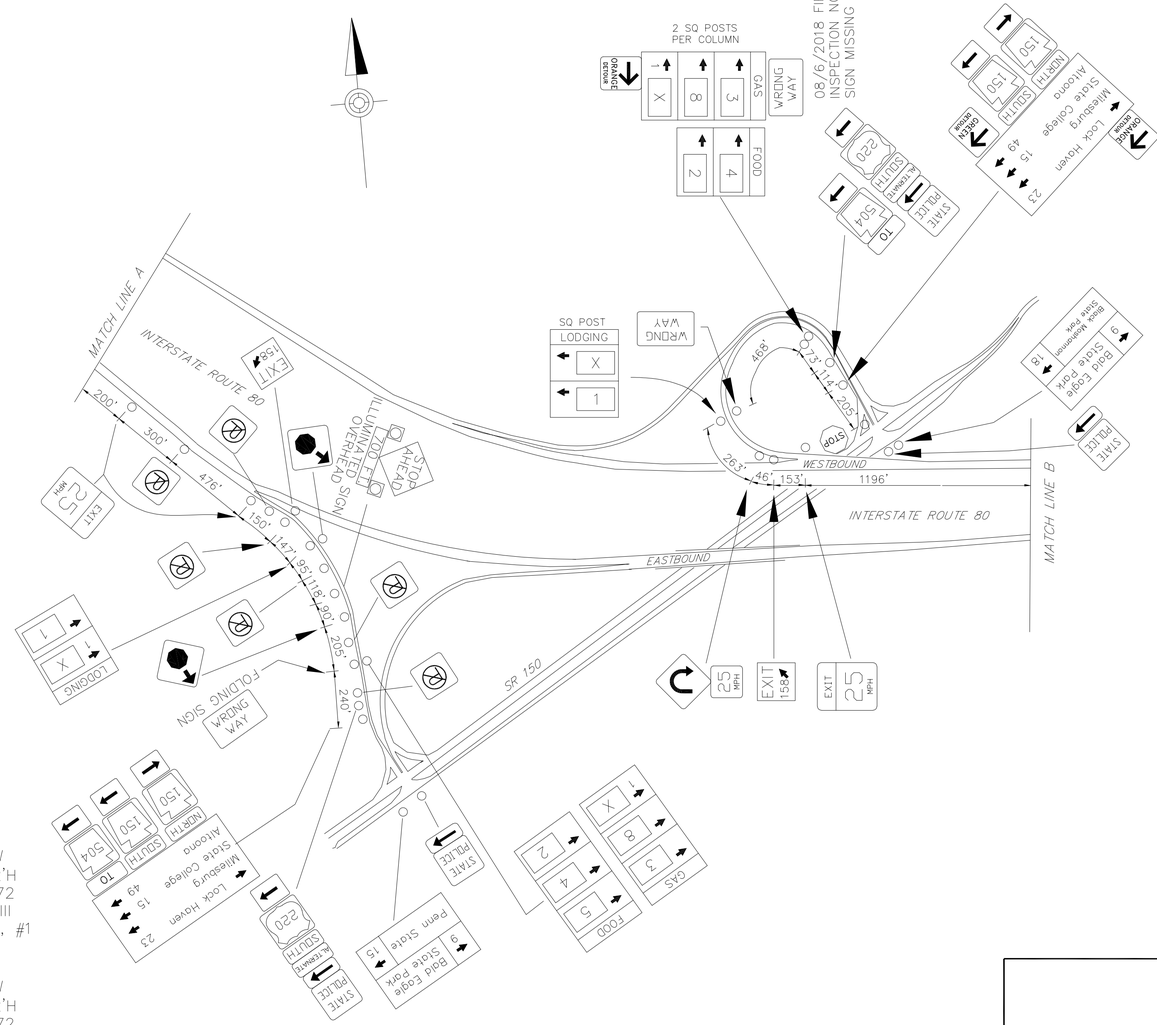

SCHEMATIC PLAN

NOT TO SCALE

EXIT 158 SPECIFIC INFORMATION PANEL			
LEGEND	DIRECTION	BUSINESS	LOGO NO.
GAS	EB/WB	VELERO (DIESEL)	3
		SHELL (24 HRS)	8
FOOD	EB/WB	COUNTRY PRIDE RESTAURANT	2
		SUBWAY	4
		McDONALD'S (24 HRS)	5
LODGING	EB/WB	ESTYA HOTEL	1

	EB SIGNS	WB SIGNS	
10'Hx13'W FUTURE 12'H W10x26 A36 3M TYPE III B650 – #1, #1	GAS – EXIT 158 3 8 X	GAS – EXIT 158 3 8 X	10'Hx13'W FUTURE 12'H W8x21 A572 3M TYPE III B525 – #1, #1
10'Hx13'W W8x21 B525 – #2, #1	FOOD – EXIT 158 2 4 5	FOOD – EXIT 158 2 4 5	10'Hx13'W FUTURE 12'H W8x21 A572 B525 – #2, #2
6'Hx13'W FUTURE 12'H W8x18 B525 – #2, #2	LODGING–EXIT 158 X 1	LODGING–EXIT 158 X 1	6'Hx13'W FUTURE 12'H W8x21 BURIED, B525–#3

INTERSTATE 80

MILESBURG

EXIT 158

D:\2015_02\85\215076-01\MW\PSE\AS-BUILT DRAWINGS\PENNDOT DISTRICT 02\CENTRE - I-80\I-XX SHTXX-I80_EXIT 158 PLAN
June/1/2022 9:44 AM