DISTRICT	COUNTY	ROUTE	PROJECT	SHEET
10-0	CLARION	I-80		
CLARION AND MONROE TOWNSHIPS				
REVISIONS				

SYMBOLS

- ○ *Existing Sign to Remain*
- △ *Existing Sign to be Removed*
- □ *Existing Sign Reset as Shown*
- ● NEW SIGN
- × FUTURE SIGN
- Ø *Existing Utility Pole*

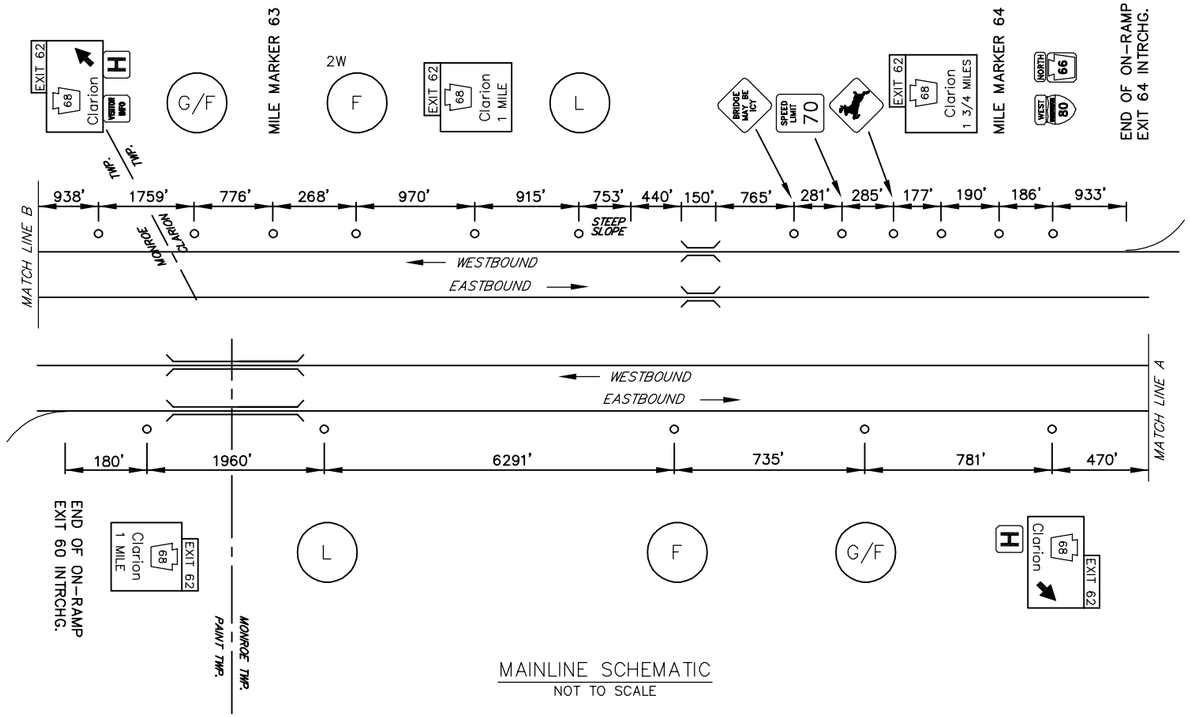

MAINLINE SCHEMATIC
NOT TO SCALE

TABULATION OF QUANTITIES		
ITEM	UNIT	QUANTITY
POST MOUNTED SIGNS, TYPE A, LOGO	SQ.FT.	—
POST MOUNTED SIGNS, TYPE B, LOGO	SQ.FT.	—
POST MOUNTED SIGNS, TYPE C, LOGO	SQ.FT.	—
BREAKAWAY SYSTEMS	EACH	—
* STEEL S OR W BEAM POSTS	LBS.	—
LOGO SIGN MOUNTING	EACH	—
FLAT SHEET REPLACEMENT PANELS	SQ. FT.	
EXTRUDED PANEL REPLACEMENT	SQ. FT.	
REMOVAL OF POST MOUNTED MOTORIST SERVICE SIGNS, TYPES B, C & F	L.S.	--

* APPROXIMATE QUANTITY FOR INFORMATION ONLY

EXIT 62 SPECIFIC INFORMATION PANEL			
LEGEND	DIRECTION	BUSINESS	LOGO NO.
GAS	EB/WB	KWIK FILL (DIESEL)	13
FOOD	EB/WB	ARBY'S	1
		EAT'N PARK	2
		TACO BELL	3
		PERKIN'S FAMILY RESTAURANT	5
		McDONALD'S (24 HRS)	6
		BURGER KING	9
		APPLEBEE'S	14
LODGING	EB/WB	HAMPTON INN	4
		MOTEL 6	8
		QUALITY INN	12
		HOLIDAY INN EXPRESS	16
		MICROTEL INN & SUITES	17
		SLEEP INN	10

	EB SIGNS	WB SIGNS	
12'Hx13'W W6x12 B525 – #2, #2	GAS – EXIT 62: 13 / FOOD – EXIT 62: 14, X; YELLOW BEHIND	GAS – EXIT 62: 13 / FOOD – EXIT 62: 14, X	16'Hx13'W FUTURE 18'H W10x26 B650 – #2, #2
14'Hx13'W W8x18 3M TYPE III B525 – #2, #2	FOOD – EXIT 62: 5, 1, 6, 2, 9, 3	FOOD – EXIT 62: 1, 5, 6, 2, 9, 3	10'Hx19'W W12x26 B650 – #2, #1
14'Hx13'W FUTURE 16'H W10x26 B650 – #2, #2	LODGING – EXIT 62: 8, 10, 16, 12, 4, 17	LODGING – EXIT 62: 8, 10, 16, 12, 4, 17	14'Hx13'W W10x22 B650 – #2, #2

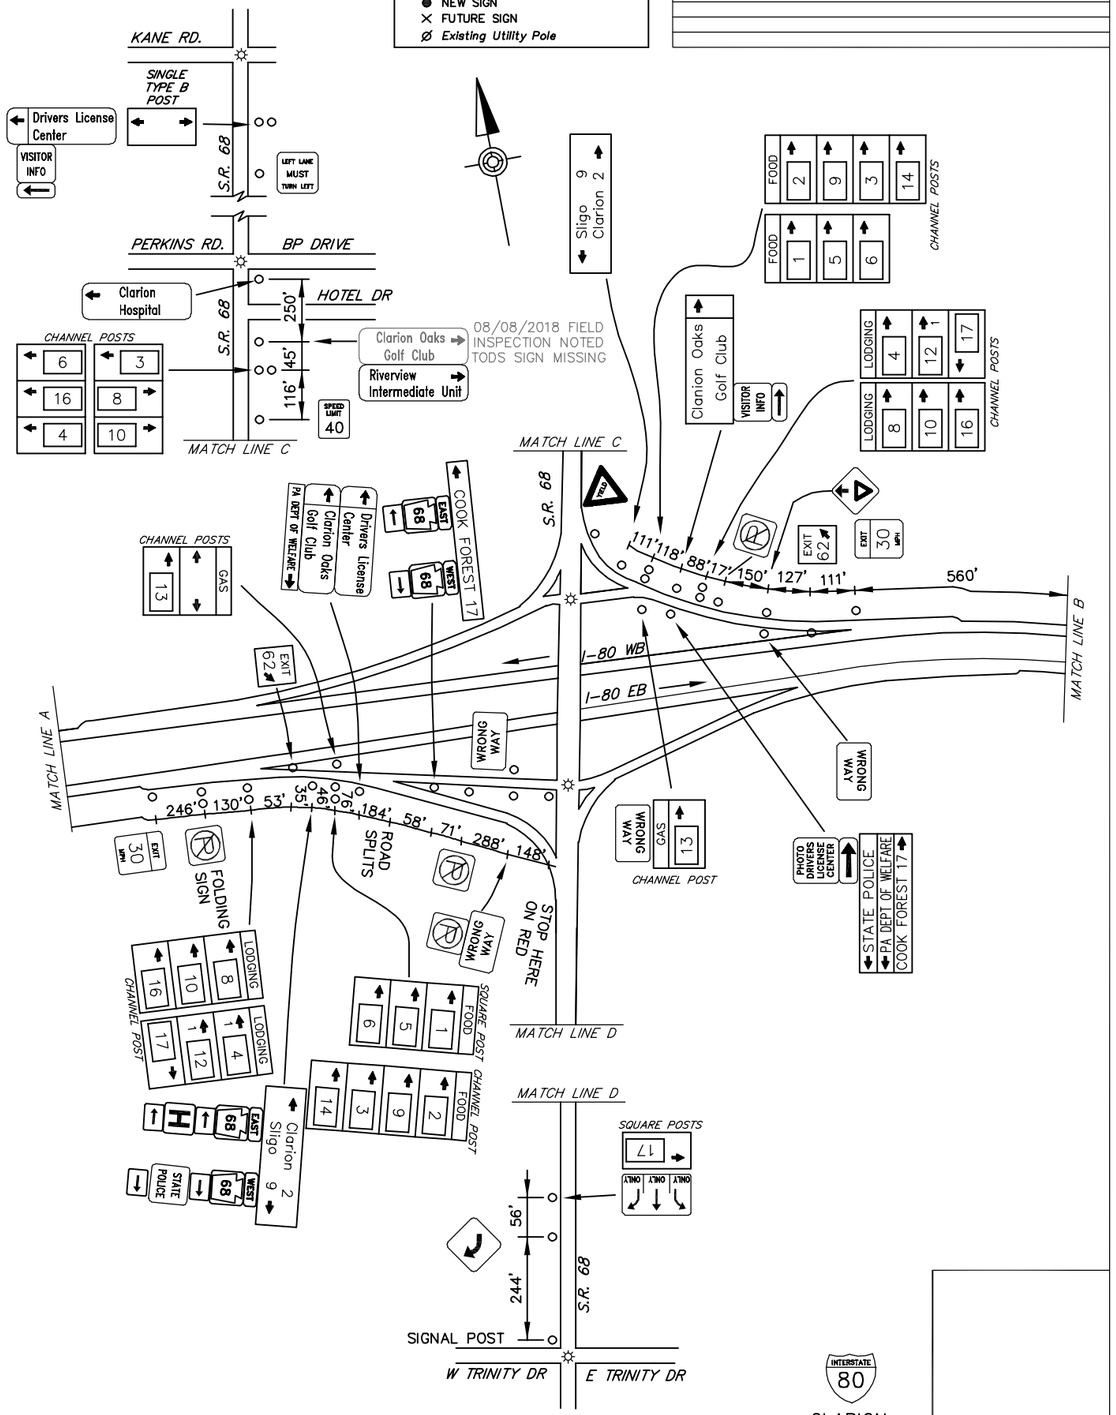

SCHEMATIC PLAN
NOT TO SCALE

INTERSTATE 80
CLARION
EXIT 62

D:\2015\D3B5\215976-01\MW\PSE\AS-BUILT DRAWINGS\PENNDOT DISTRICT 10\CLARION - 16\10-XX SHT0X-I80_EXIT 62 PLAN
June/16/2022 3:58 PM