DISTRICT	COUNTY	ROUTE	PROJECT	SHEET
8-0	CUMBERLAND	I-81		
SOUTHAMPTON & SHIPPENSBURG TOWNSHIPS				
REVISIONS				

TABULATION OF QUANTITIES		
ITEM	UNIT	QUANTITY
POST MOUNTED SIGNS, TYPE A, LOGO	SQ.FT.	–
POST MOUNTED SIGNS, TYPE A, LOGO (MODIFIED)	SQ.FT.	
POST MOUNTED SIGNS, TYPE C, LOGO	SQ.FT.	
BREAKAWAY SYSTEMS	EACH	–
* STEEL S OR W BEAM POSTS	LBS.	–
LOGO SIGN MOUNTING	EACH	
LOGO SIGN MOUNTING, RESET	EACH	
REMOVAL OF POST MOUNTED MOTORIST SERVICE SIGNS, TYPES A & E	EACH	–
REMOVAL OF POST MOUNTED MOTORIST SERVICE SIGNS, TYPES B, C & F	L.S.	

* APPROXIMATE QUANTITY FOR INFORMATION ONLY

SYMBOLS

- ○ *Existing Sign to Remain*
- △ *Existing Sign to be Removed*
- □ *Existing Sign Reset as Shown*
- ● NEW SIGN
- × FUTURE SIGN
- Ø *Existing Utility Pole*

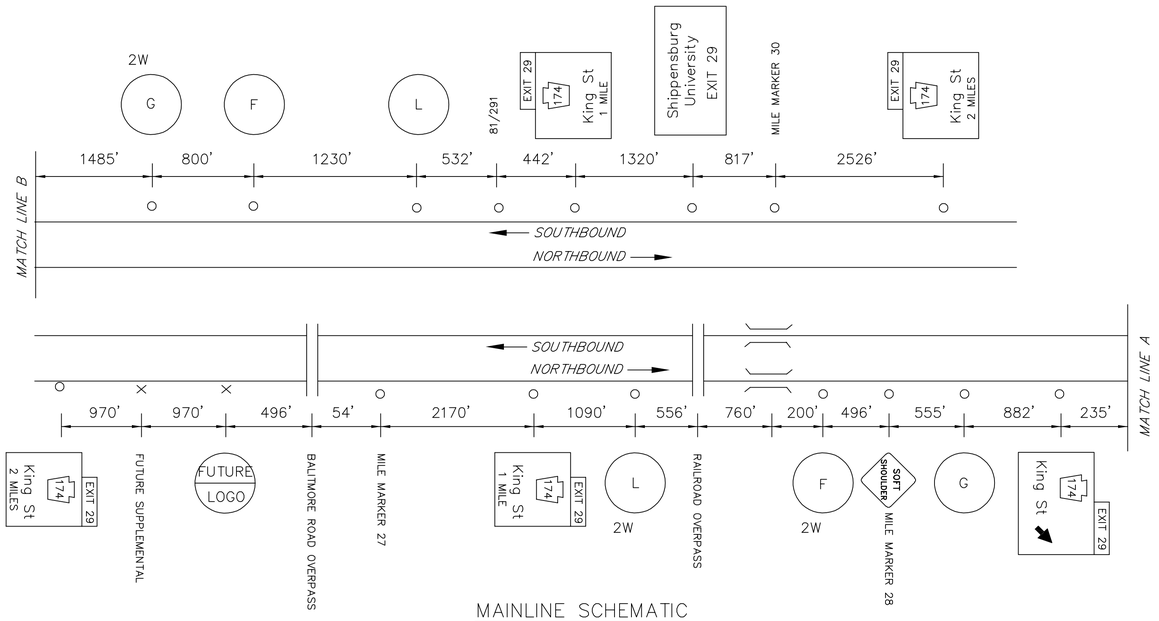

MAINLINE SCHEMATIC
NOT TO SCALE

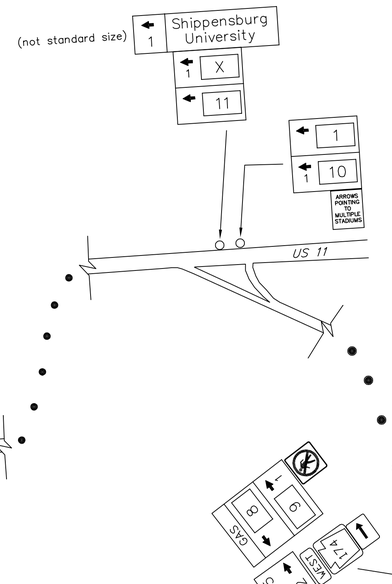

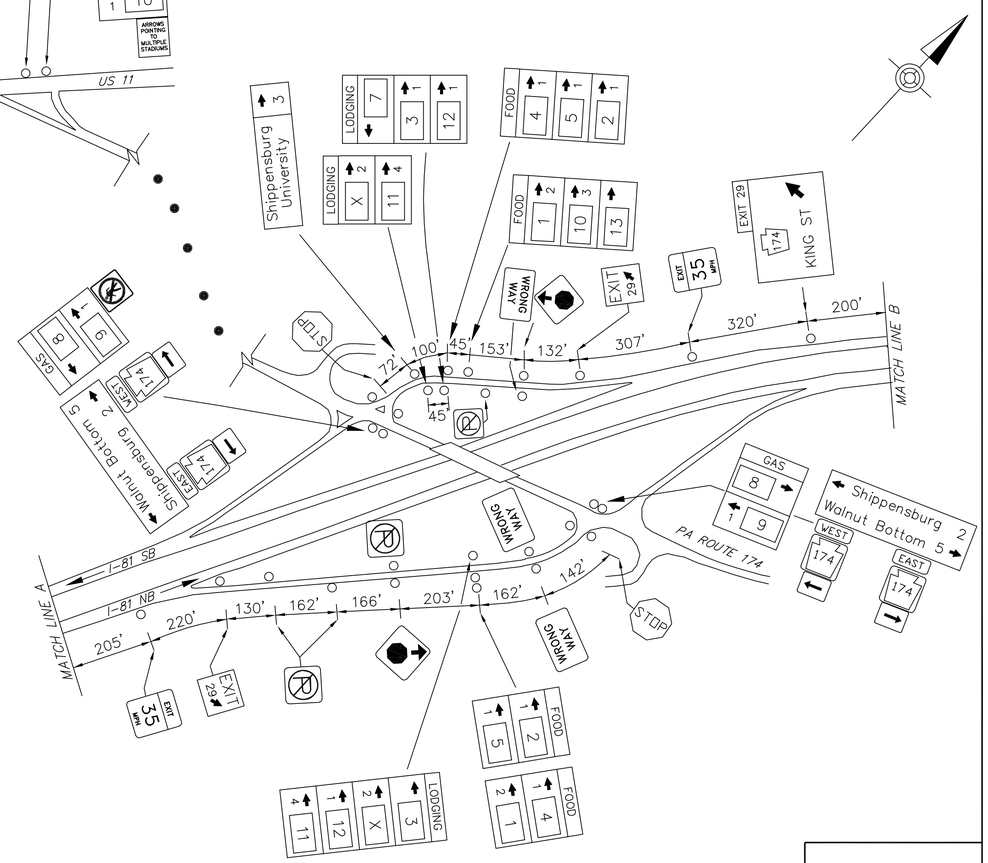

SCHEMATIC PLAN
NOT TO SCALE

LEGEND

2W – GUIDE RAIL.

DO NOT CLOSE OR RESTRICT TRAVEL LANES DURING RUSH HOUR. WORK ALONG FREEWAY PERMITTED BETWEEN 9:00 AM AND 2:30 PM, UNLESS OTHERWISE APPROVED BY ENGINEERING DISTRICT. DO NOT WORK DURING HOLIDAY. PERIODS IF APPICABLE, REINSTALL GUIDERAIL AT END OF EACH DAY.

EXIT 29 ** SPECIFIC INFORMATION PANEL			
LEGEND	DIRECTION	BUSINESS	LOGO NO.
GAS	NB/SB	SUNOCO (24 HRS/DIESEL)	8
		RUTTER'S (24 HRS/DIESEL)	9
FOOD	NB/SB	McDONALD'S	1
		BURGER KING	4
		SUBWAY	2
		WENDY'S	5
	SB	AROOGA'S	10
		DUNKIN'	13
LODGING	NB/SB	BEST WESTERN	3
		COURTYARD BY MARRIOTT	11
		HOLIDAY INN EXPRESS	12
	SB	RODEWAY INN	7

** ONE MILE EXTENSION ALLOWANCE APPLIES AT THIS INTERCHANGE

NB SIGNS

6'Hx13'W
FUTURE 16'H
W14x30 A572
AVERY TYPE IV
B650 – #3, #3

GAS – EXIT 29: 8 9

10'Hx13'W
FUTURE 12'H
W10x26 A572
TYPE III
B650 – #1, #1

FOOD – EXIT 29: 4 1 / 2 5

10'Hx13'W
W6x12
AVERY TYPE IV
B525 – #1, #1

LODGING – EXIT 29: 3 12 / X 11

SB SIGNS

GAS – EXIT 29: 8 9

6'Hx13'W
FUTURE 14'H
W14x30 A572
3M TYPE III
B650 – #2, #2

FOOD – EXIT 29: 5 2 / 4 1 / 10 13

14'Hx13'W
W8x21 A572
AVERY TYPE IV
B525 – #2, #2

LODGING – EXIT 29: 7 3 12 / X 11

10'Hx19'W
FUTURE 12'H
W12x26
AVERY TYPE IV
B650 – #2, #2

INTERSTATE 81
KING STREET
EXIT 29

D:\2015_ID\81\215976-I81HVPSEVAS-BUILT DRAWINGS\PENNDOT DISTRICT 8\CUMBERLAND - 21\0-XX SHTXX IBL_EXIT 29 PLAN
June/9/2022 4:00 PM